

## **Disclaimer**

This Report, including the data and information contained in this Report, is provided to you on an "as is" and "as available" basis at the sole discretion of the Government of Alberta and subject to the terms and conditions of use below (the "Terms and Conditions"). The Government of Alberta has not verified this Report for accuracy and does not warrant the accuracy of, or make any other warranties or representations regarding, this Report. Furthermore, updates to this Report may not be made available. Your use of any of this Report is at your sole and absolute risk.

This Report is provided to the Government of Alberta, and the Government of Alberta has obtained a license or other authorization for use of the Reports, from:

Shell Canada Energy, Chevron Canada Limited, and Marathon Oil Canada Corporation, for the Quest Project

(collectively the "Project")

Each member of the Project expressly disclaims any representation or warranty, express or implied, as to the accuracy or completeness of the material and information contained herein, and none of them shall have any liability, regardless of any negligence or fault, for any statements contained in, or for any omissions from, this Report. Under no circumstances shall the Government of Alberta or the Project be liable for any damages, claims, causes of action, losses, legal fees or expenses, or any other cost whatsoever arising out of the use of this Report or any part thereof or the use of any other data or information on this website.

## **Terms and Conditions of Use**

Except as indicated in these Terms and Conditions, this Report and any part thereof shall not be copied, reproduced, distributed, republished, downloaded, displayed, posted or transmitted in any form or by any means, without the prior written consent of the Government of Alberta and the Project.

The Government of Alberta's intent in posting this Report is to make them available to the public for personal and non-commercial (educational) use. You may not use this Report for any other purpose. You may reproduce data and information in this Report subject to the following conditions:

- any disclaimers that appear in this Report shall be retained in their original form and applied to the data and information reproduced from this Report
- the data and information shall not be modified from its original form
- the Project shall be identified as the original source of the data and information, while this website shall be identified as the reference source, and
- the reproduction shall not be represented as an official version of the materials reproduced, nor as having been made in affiliation with or with the endorsement of the Government of Alberta or the Project


By accessing and using this Report, you agree to indemnify and hold the Government of Alberta and the Project, and their respective employees and agents, harmless from and against any and all claims, demands, actions and costs (including legal costs on a solicitor-client basis) arising out of any breach by you of these Terms and Conditions or otherwise arising out of your use or reproduction of the data and information in this Report.


Your access to and use of this Report is subject exclusively to these Terms and Conditions and any terms and conditions contained within the Report itself, all of which you shall comply with. You will not use this Report for any purpose that is unlawful or prohibited by these Terms and Conditions. You agree that any other use of this Report means you agree to be bound by these Terms and Conditions. These Terms and Conditions are subject to modification, and you agree to review them periodically for changes. If you do not accept these Terms and Conditions you agree to immediately stop accessing this Report and destroy all copies in your possession or control.


These Terms and Conditions may change at any time, and your continued use and reproduction of this Report following any changes shall be deemed to be your acceptance of such change.


If any of these Terms and Conditions should be determined to be invalid, illegal or unenforceable for any reason by any court of competent jurisdiction then the applicable provision shall be severed and the remaining provisions of these Terms and Conditions shall survive and remain in full force and effect and continue to be binding and enforceable.


These Terms and Conditions shall: (i) be governed by and construed in accordance with the laws of the province of Alberta and you hereby submit to the exclusive jurisdiction of the Alberta courts, and (ii) ensure to the benefit of, and be binding upon, the Government of Alberta and your respective successors and assigns.

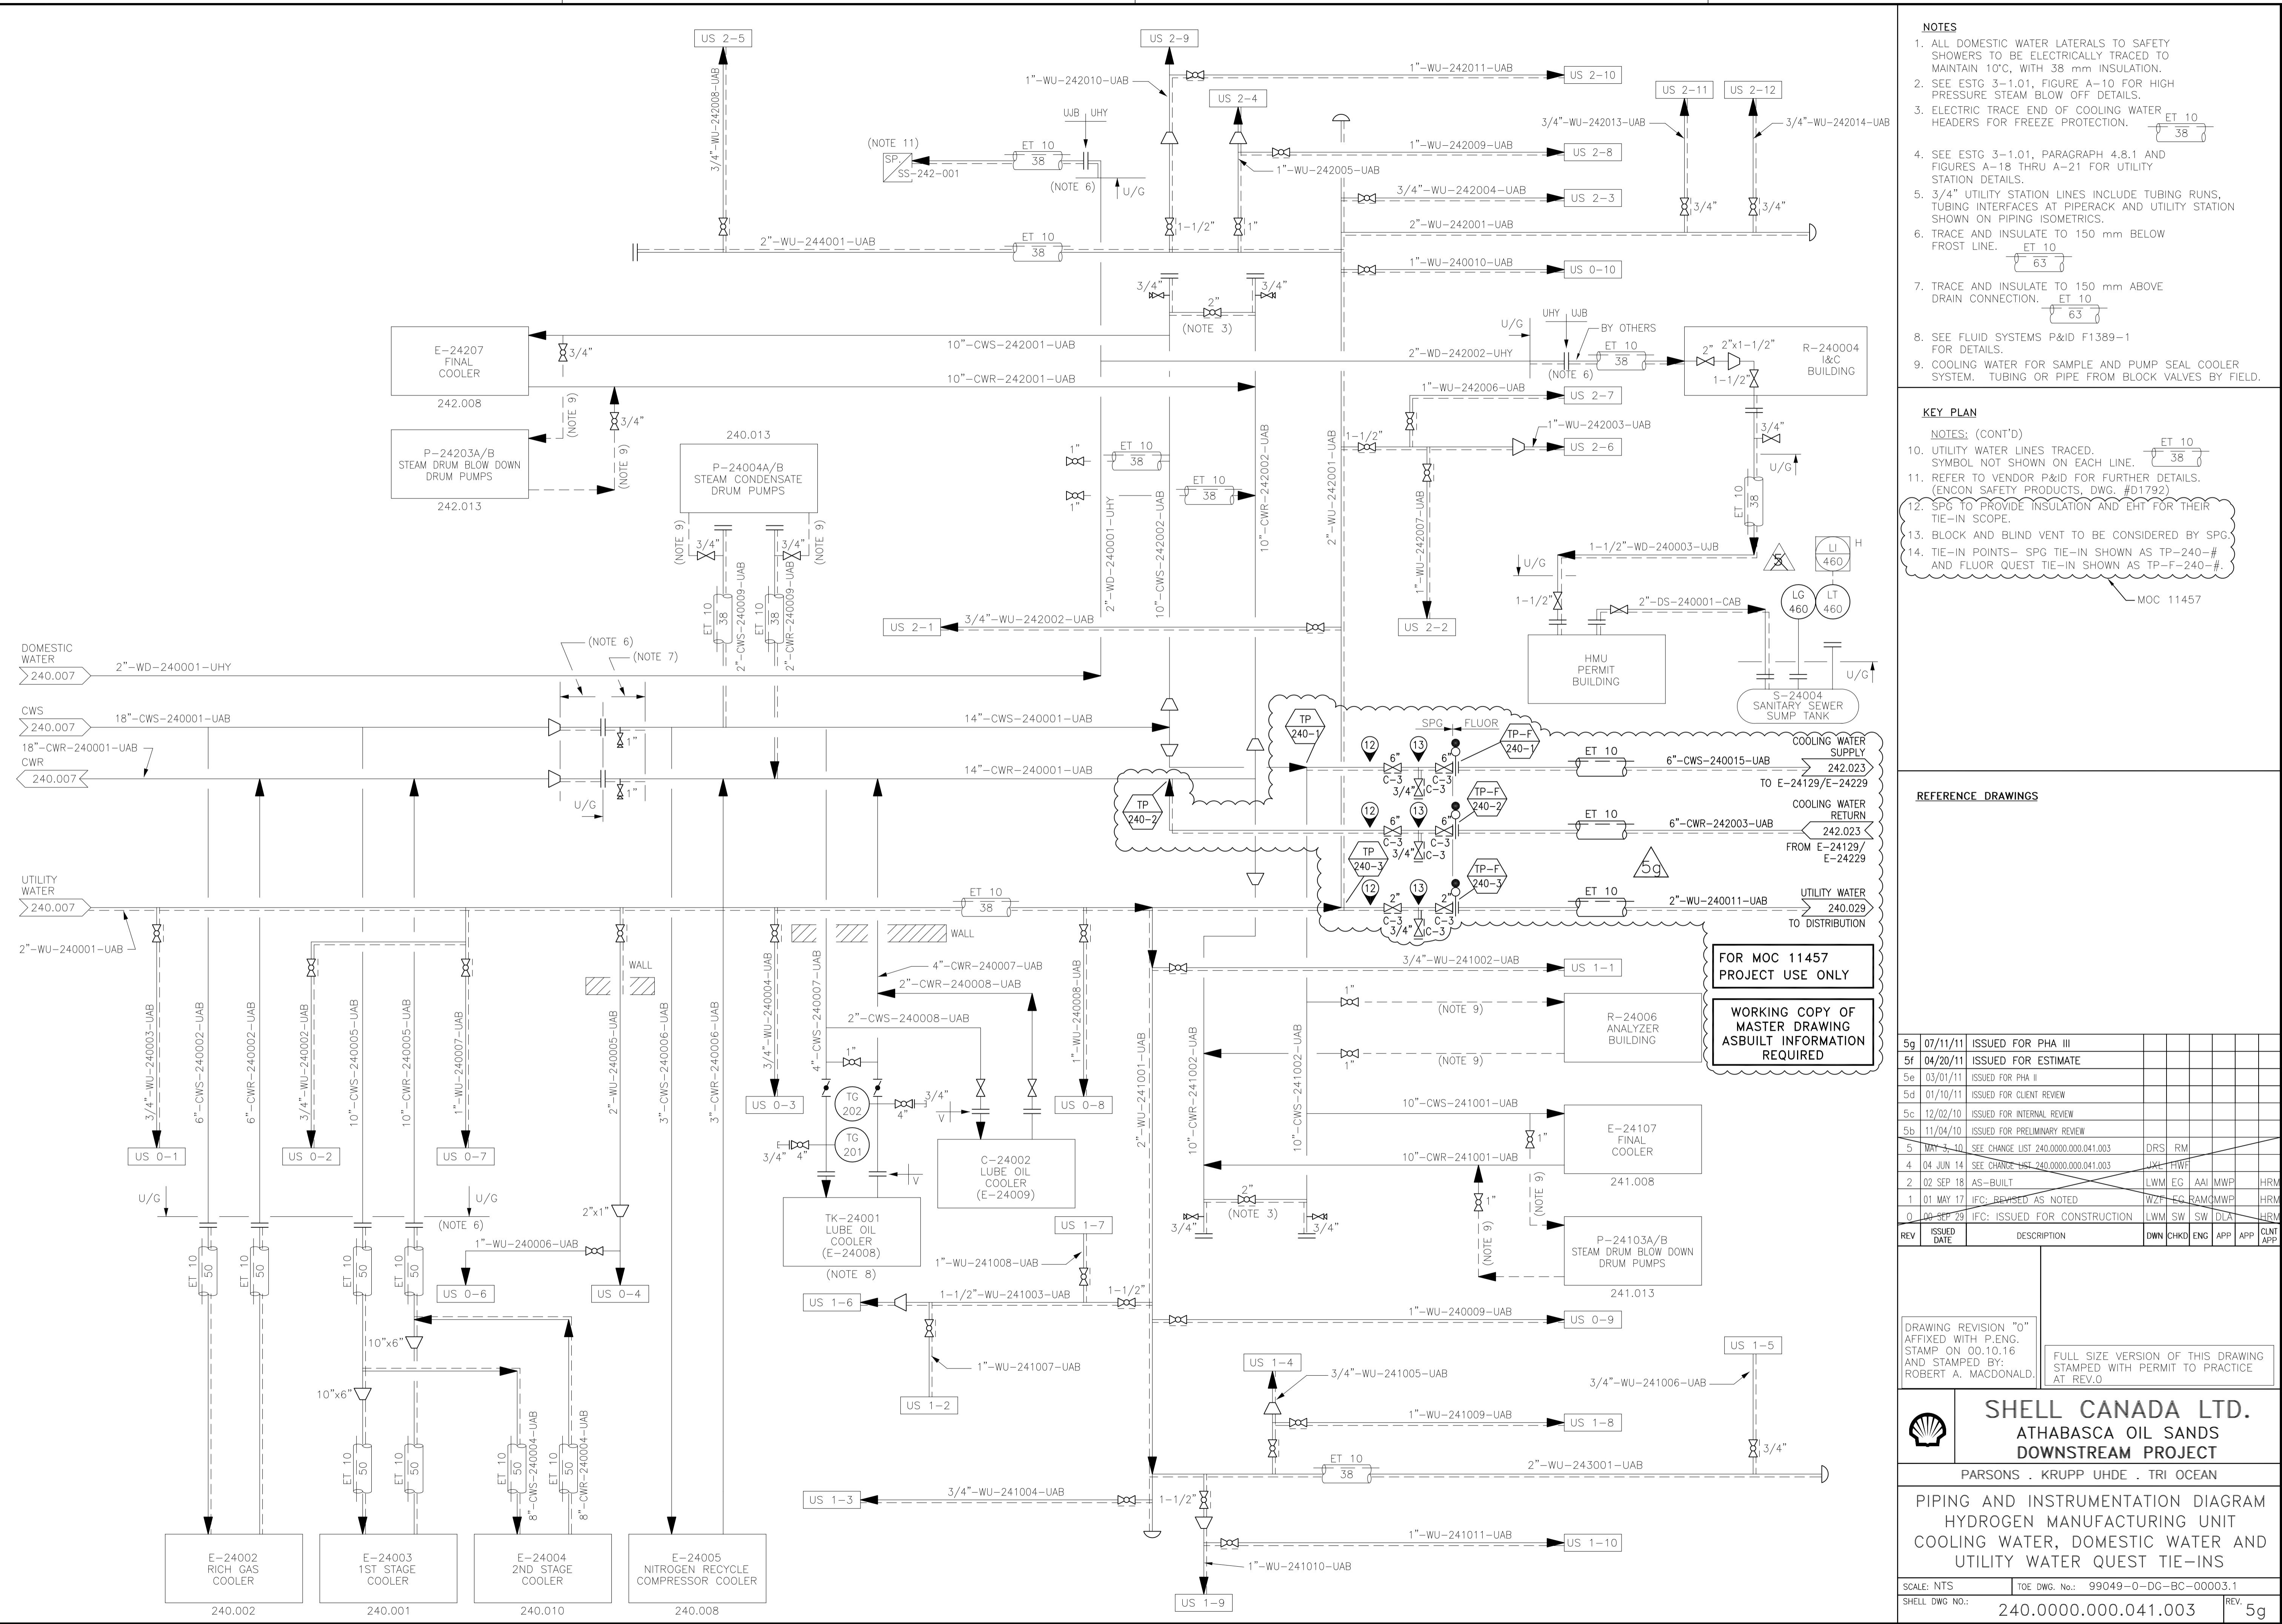

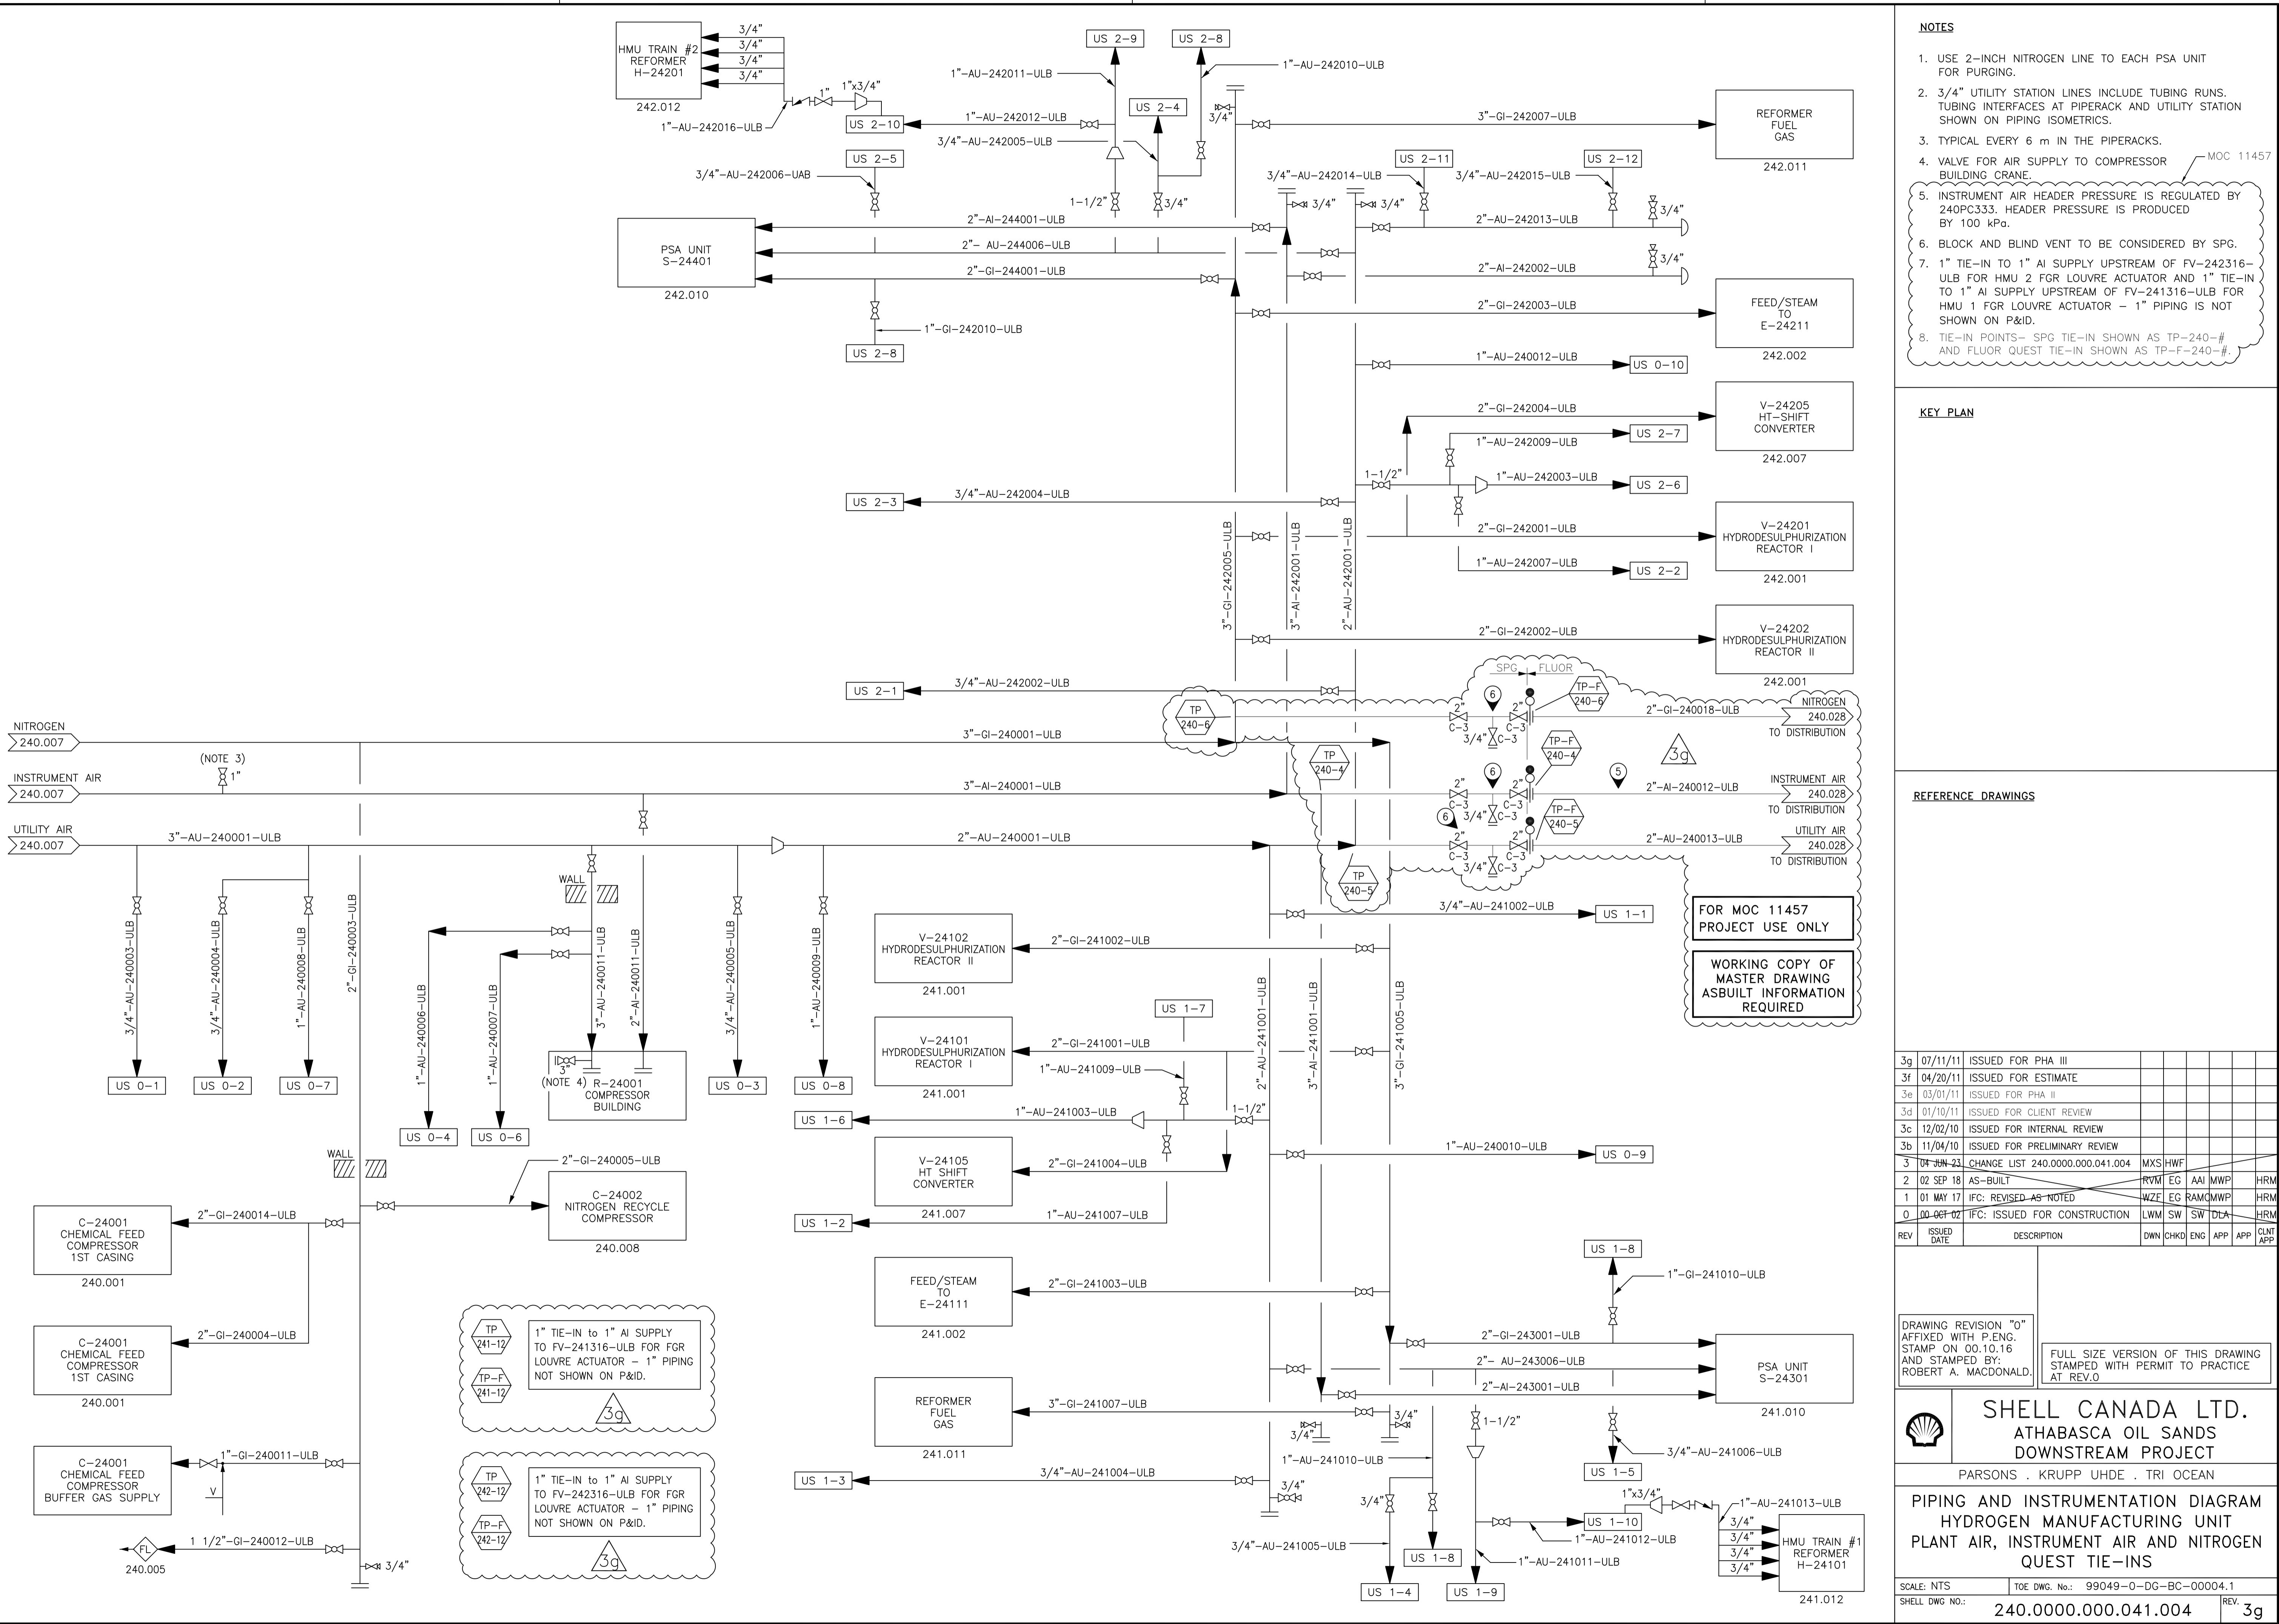

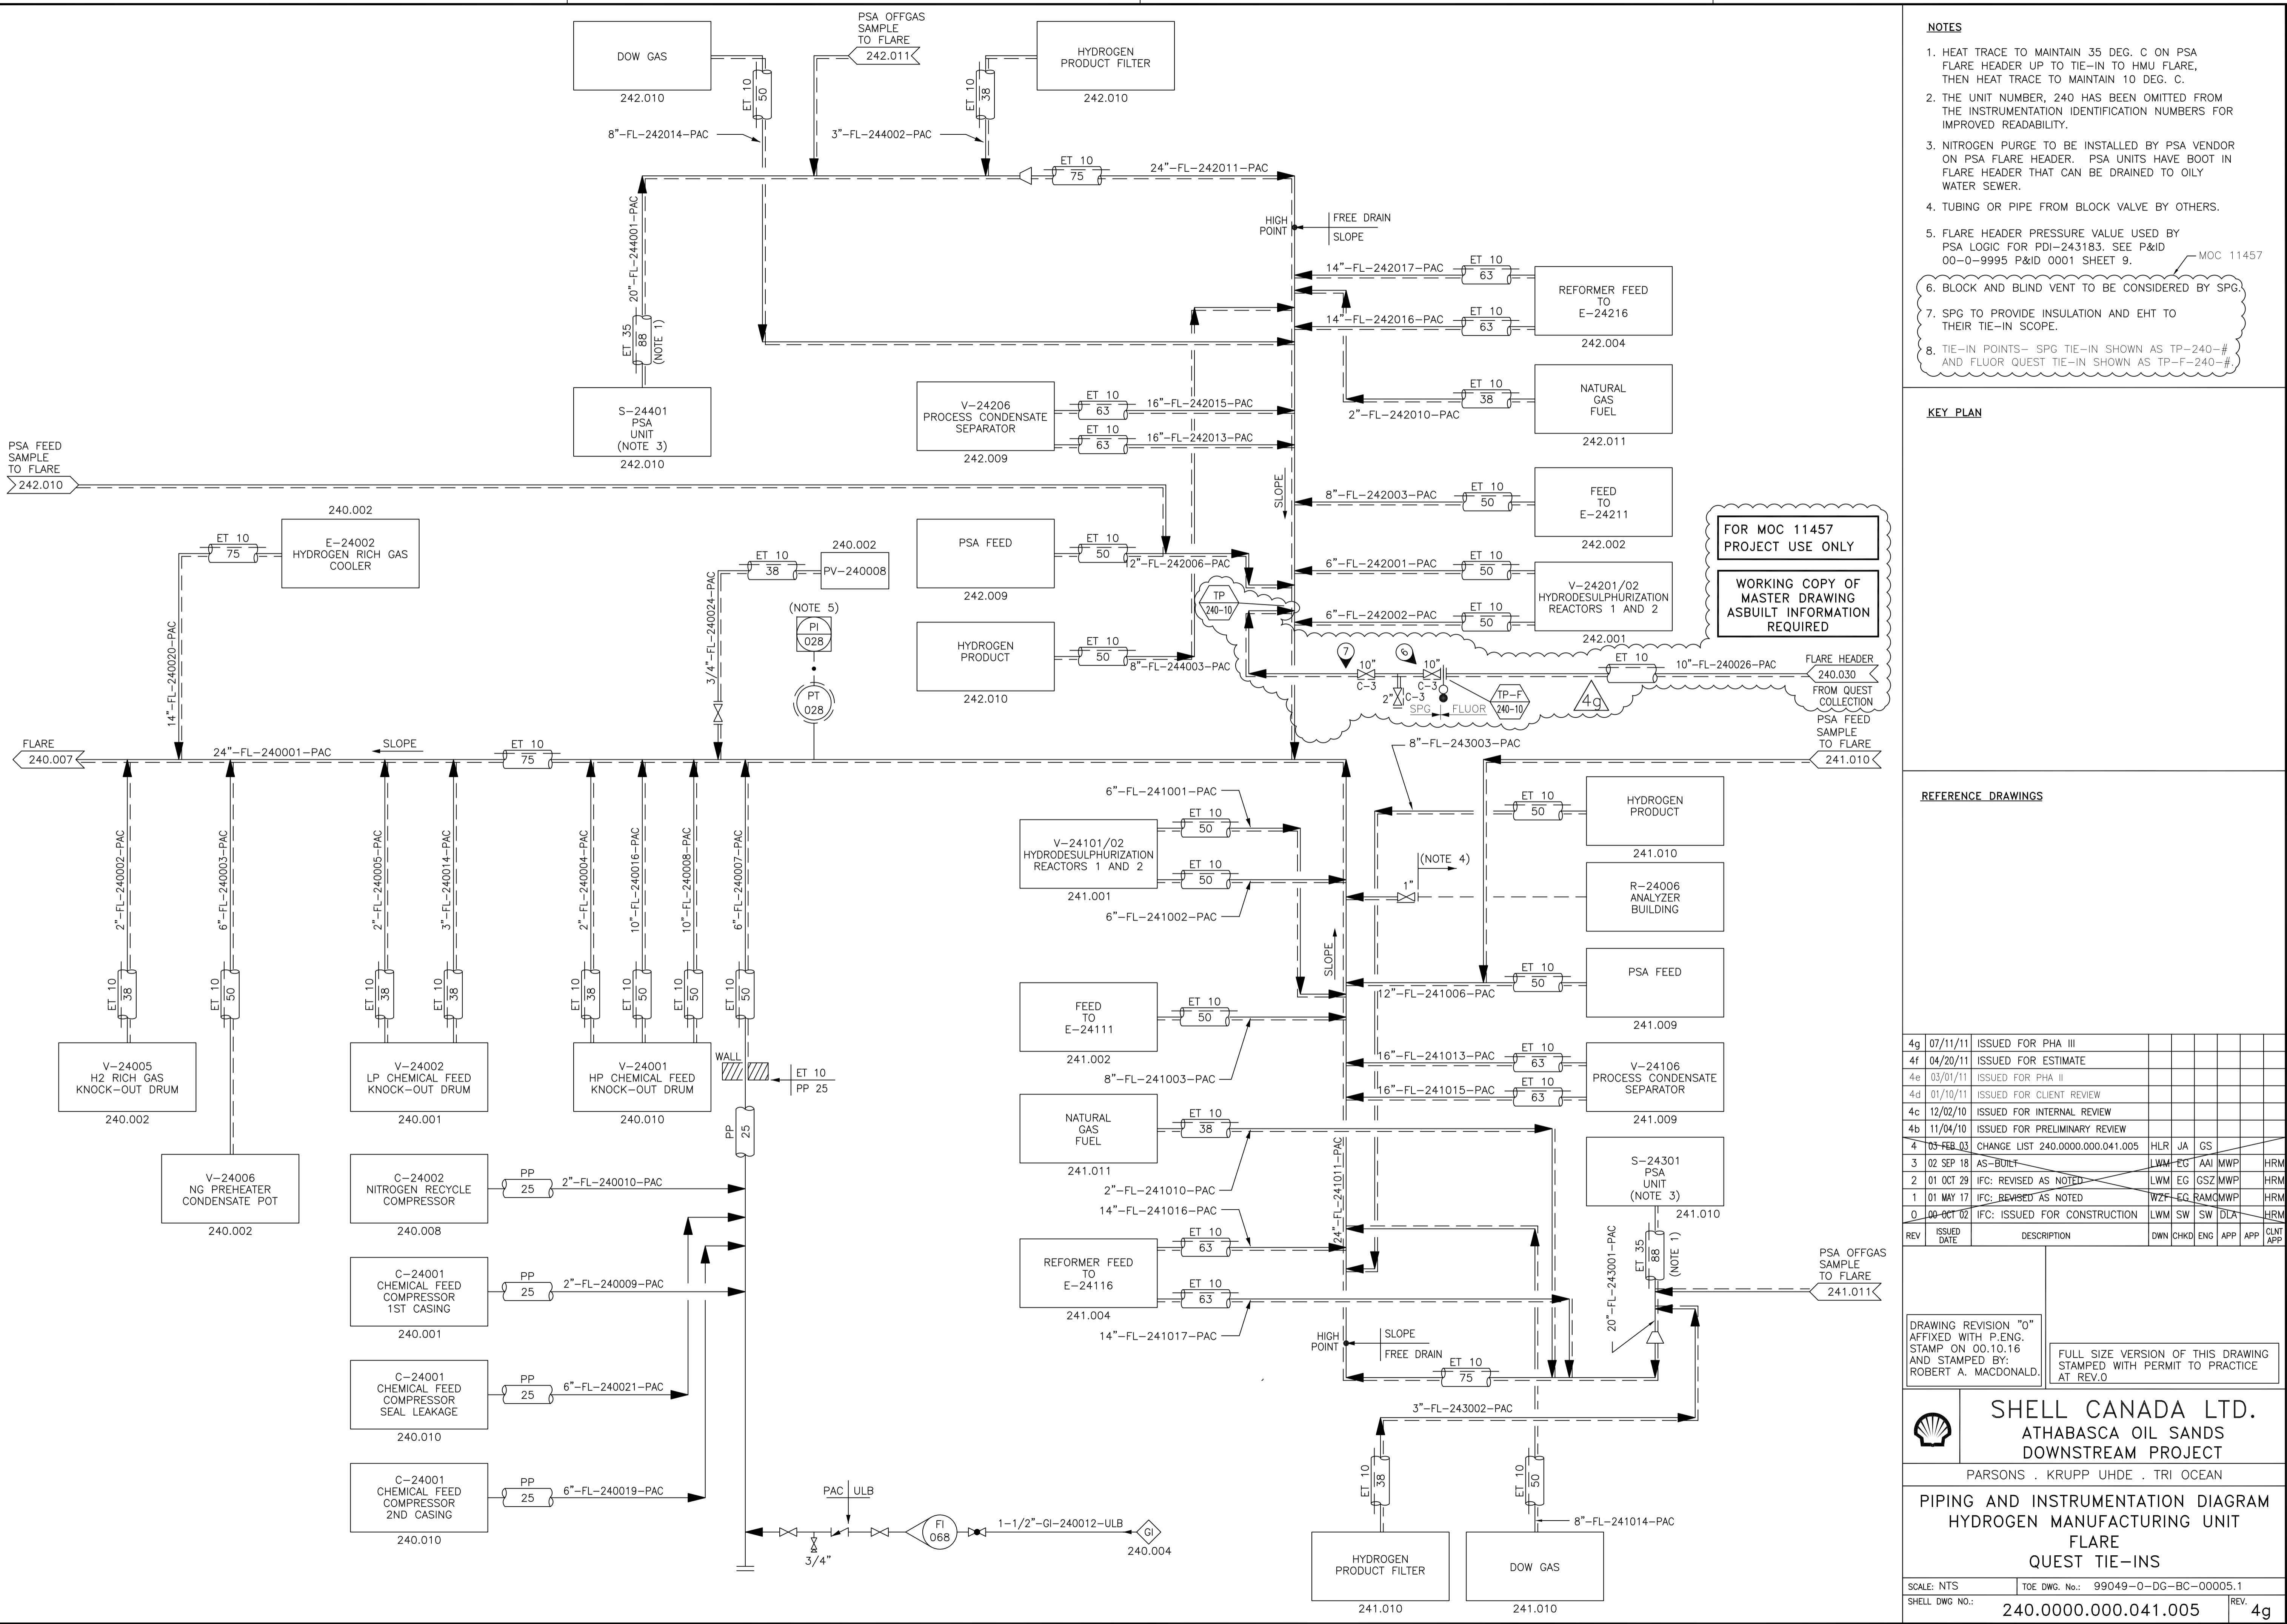

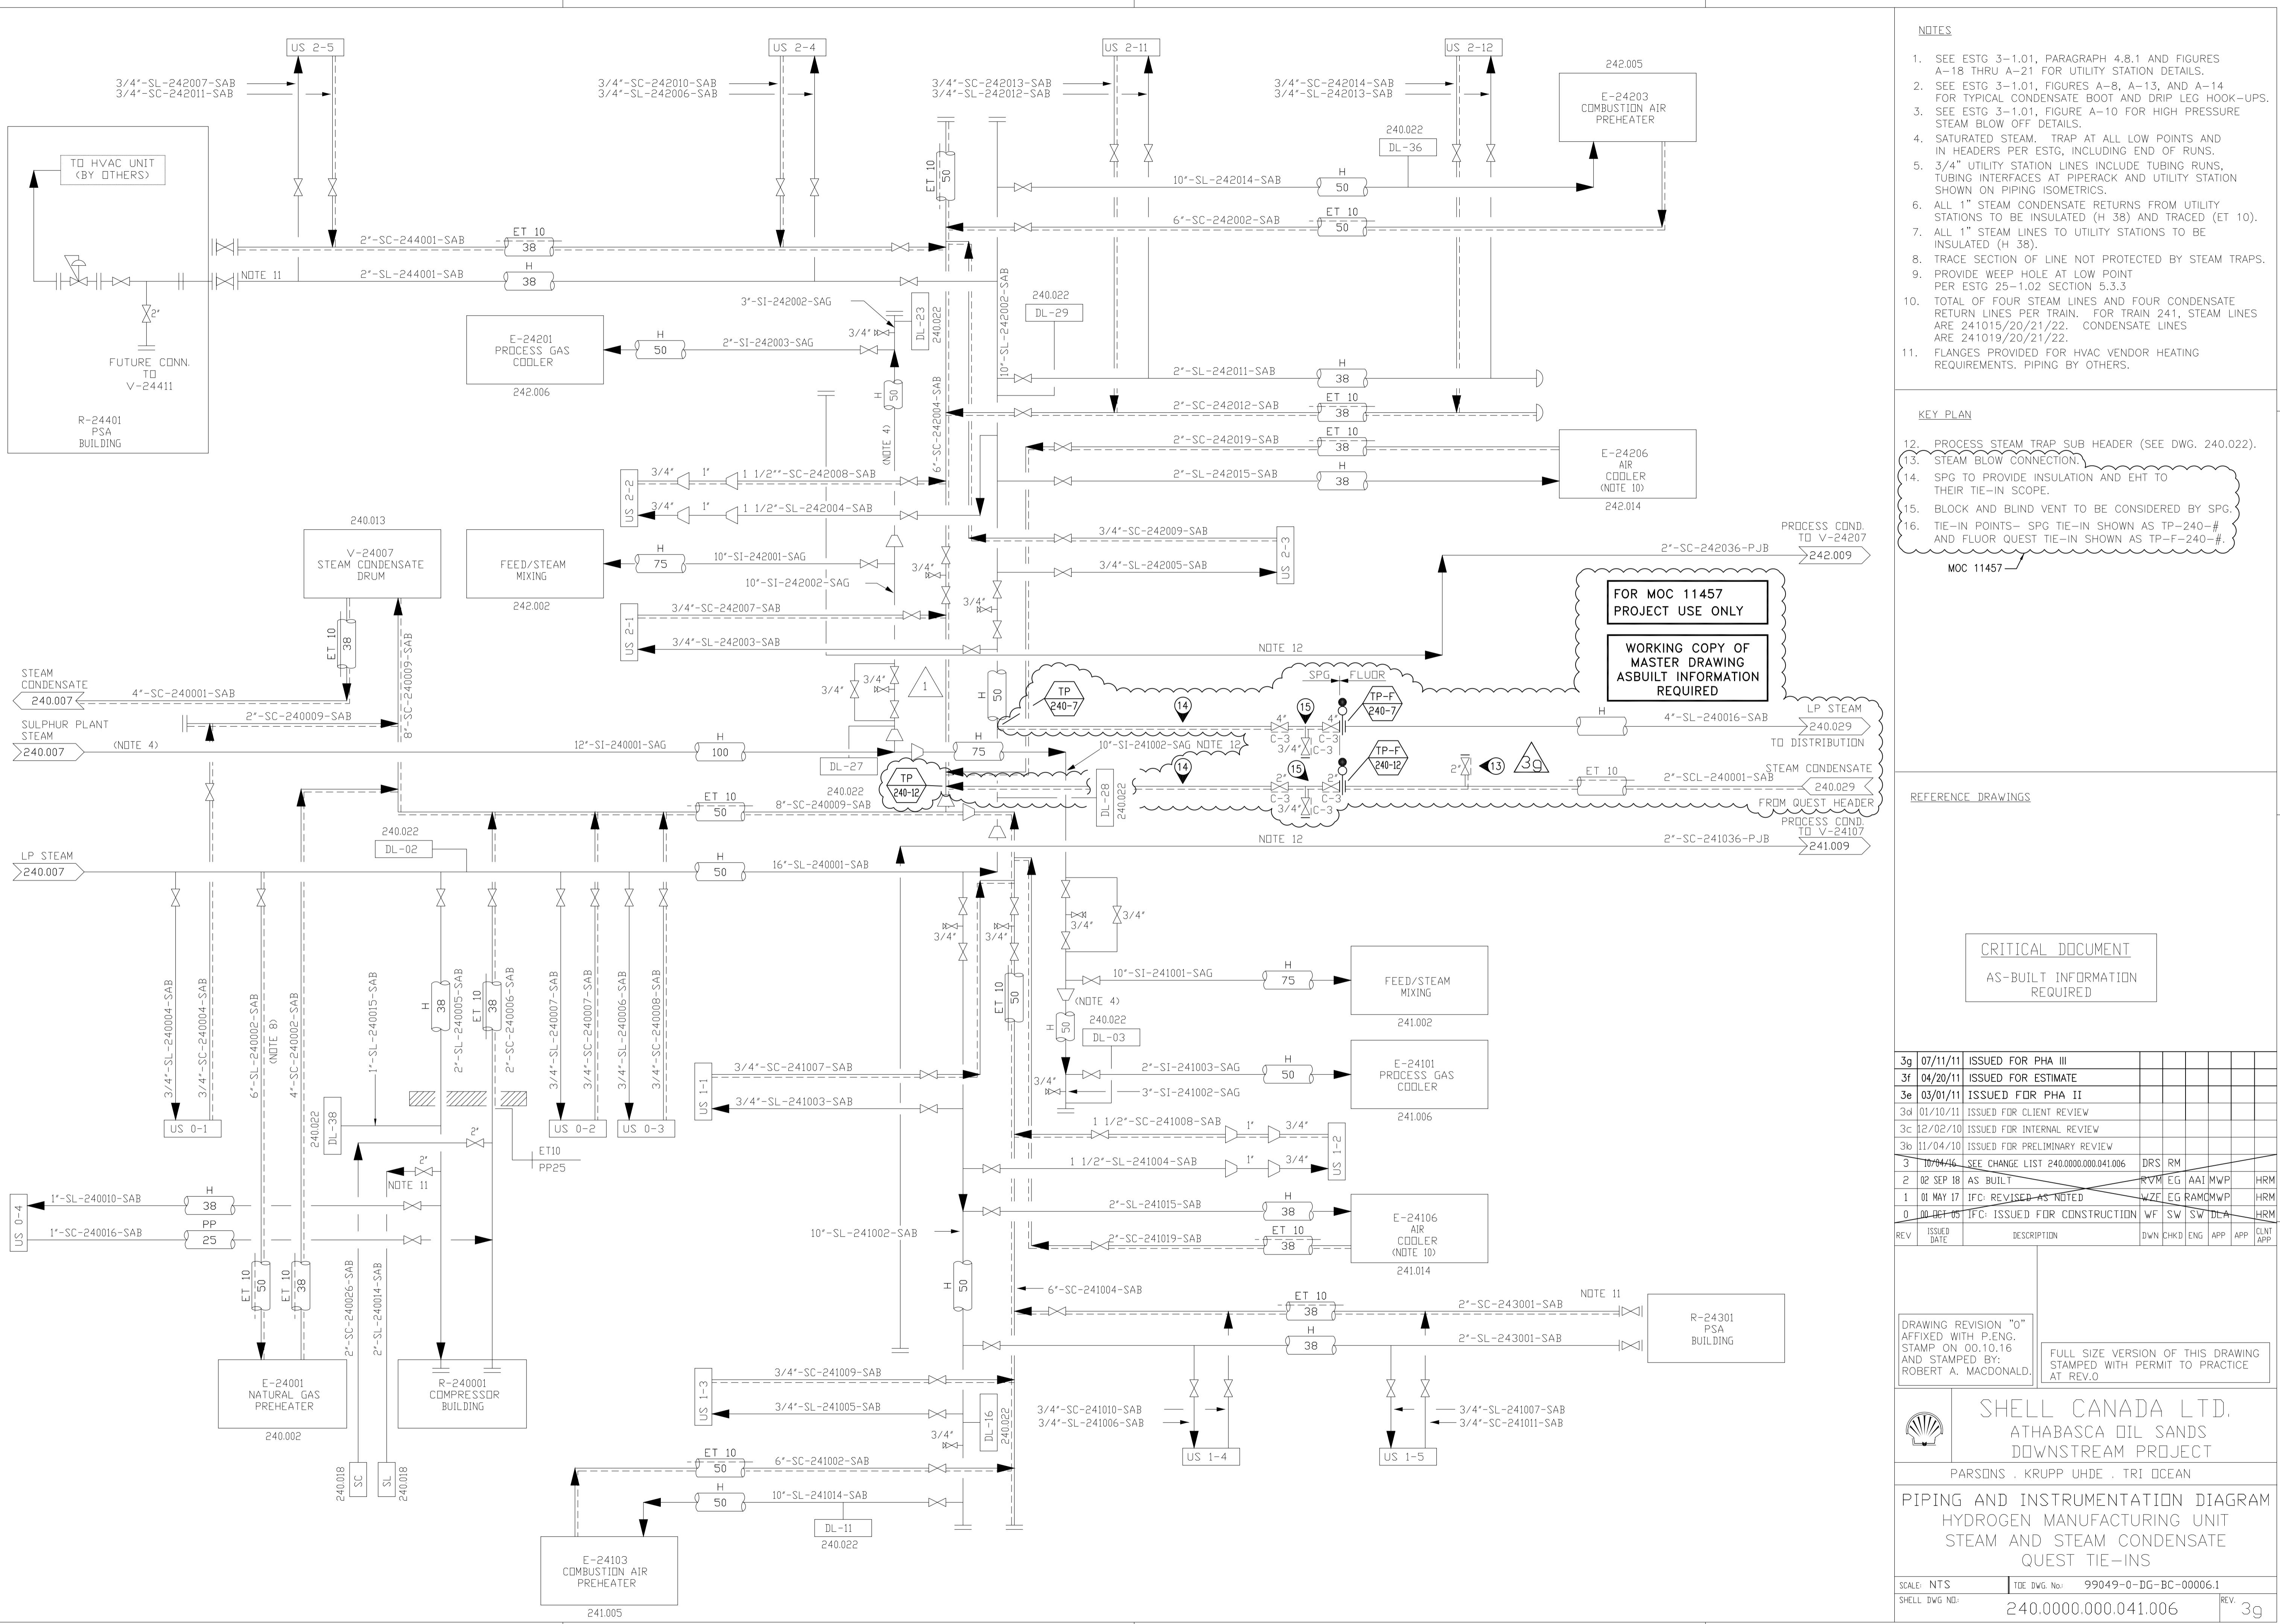

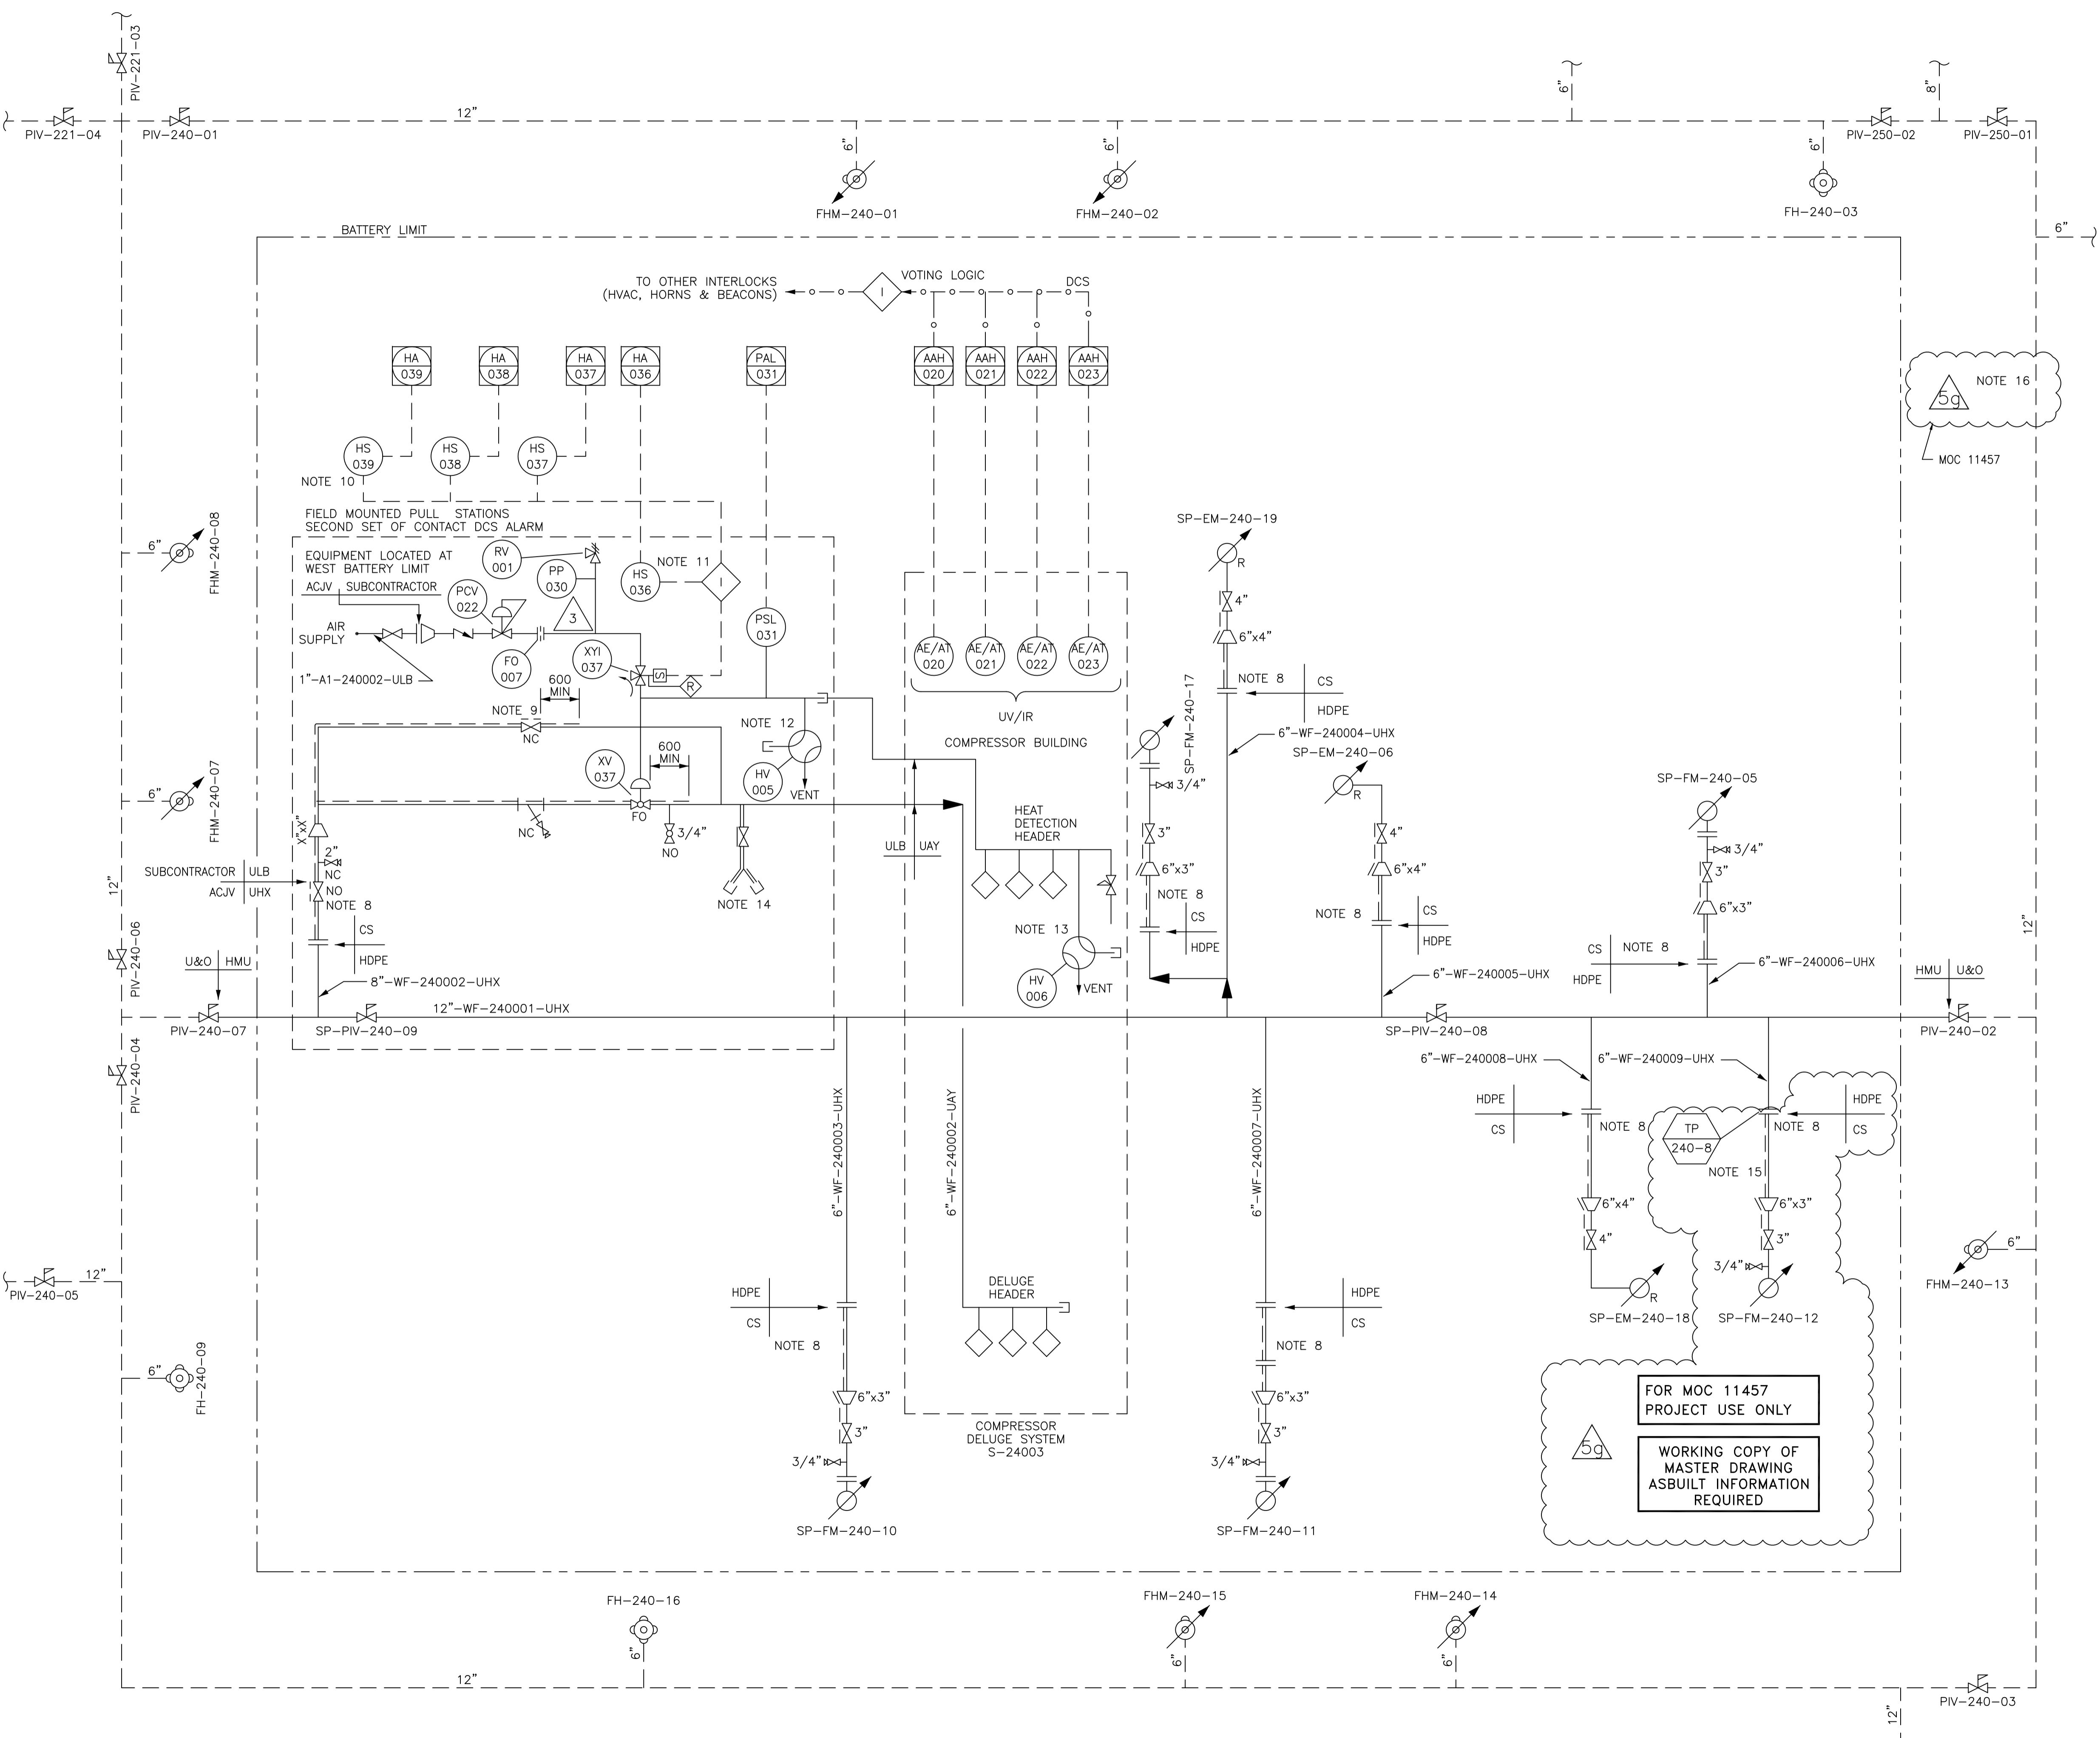

FORMAT A1

5g 07/11/11 ISSUED FOR PHA III  
 5f 04/20/11 ISSUED FOR ESTIMATE  
 5e 03/01/11 ISSUED FOR PHA II  
 5d 01/10/11 ISSUED FOR CLIENT REVIEW  
 5c 12/02/10 ISSUED FOR INTERNAL REVIEW  
 5b 11/04/10 ISSUED FOR INFORMATION  
 5-03-APR-30 CHANGE LIST 240.0000.000.041.011 (PIT# 1004) HLR HH  
 4 02 SEP 18 AS-BUILT LWM EG AAI MWP HRM  
 3 01 OCT 05 REVISED PER DCR 0293 & 0297 LWM EG MWP MWP HRM  
 2 01 MAY 17 IFC: REVISED AS NOTED WZF EG RAMC MWP HRM  
 1 00 NOV 23 IFC: ISSUED FOR CONSTRUCTION WZF CJB RAMC MWP MWP HRM  
 0 00 OCT 02 IFC: ISSUED FOR CONSTRUCTION LWM SW SW DLA HRM  
 REV DATE DESCRIPTION DWN CHKD ENG APP APP CLNT APP

DRAWING REVISION "0" AFFIXED WITH P.ENG. STAMP ON 00 OCT 02 AND STAMPED BY: ROBERT A. MACDONALD.

FULL SIZE VERSION OF THIS DRAWING STAMPED WITH PERMIT TO PRACTICE AT REV.0

**SHELL CANADA LTD.**  
**ATHABASCA OIL SANDS**  
**DOWNSTREAM PROJECT**  
 PARSONS . KRUPP UHDE . TRI OCEAN  
**PIPING AND INSTRUMENTATION DIAGRAM**  
**HYDROGEN MANUFACTURING UNIT**  
**FIREWATER DISTRIBUTION**  
**QUEST TIE-INs**

SCALE: NTS TOE DWG. No.: 99049-0-DG-BC-00011.1  
 SHELL DWG. No.: 240.0000.000.041.011 REV. 5g


4

3

2

1

ALL INFORMATION CONTAINED IN THIS DRAWING AND IN INFORMATION CONTAINED HEREIN IS THE PROPERTY OF SHELL CANADA AND IS NOT TO BE USED, DISCLOSED, OR REPRODUCED IN ANY FORMAT BY ANY OTHER PARTY WITHOUT SHELL CANADA AND SHELL PRIORITY WRITTEN PERMISSION.

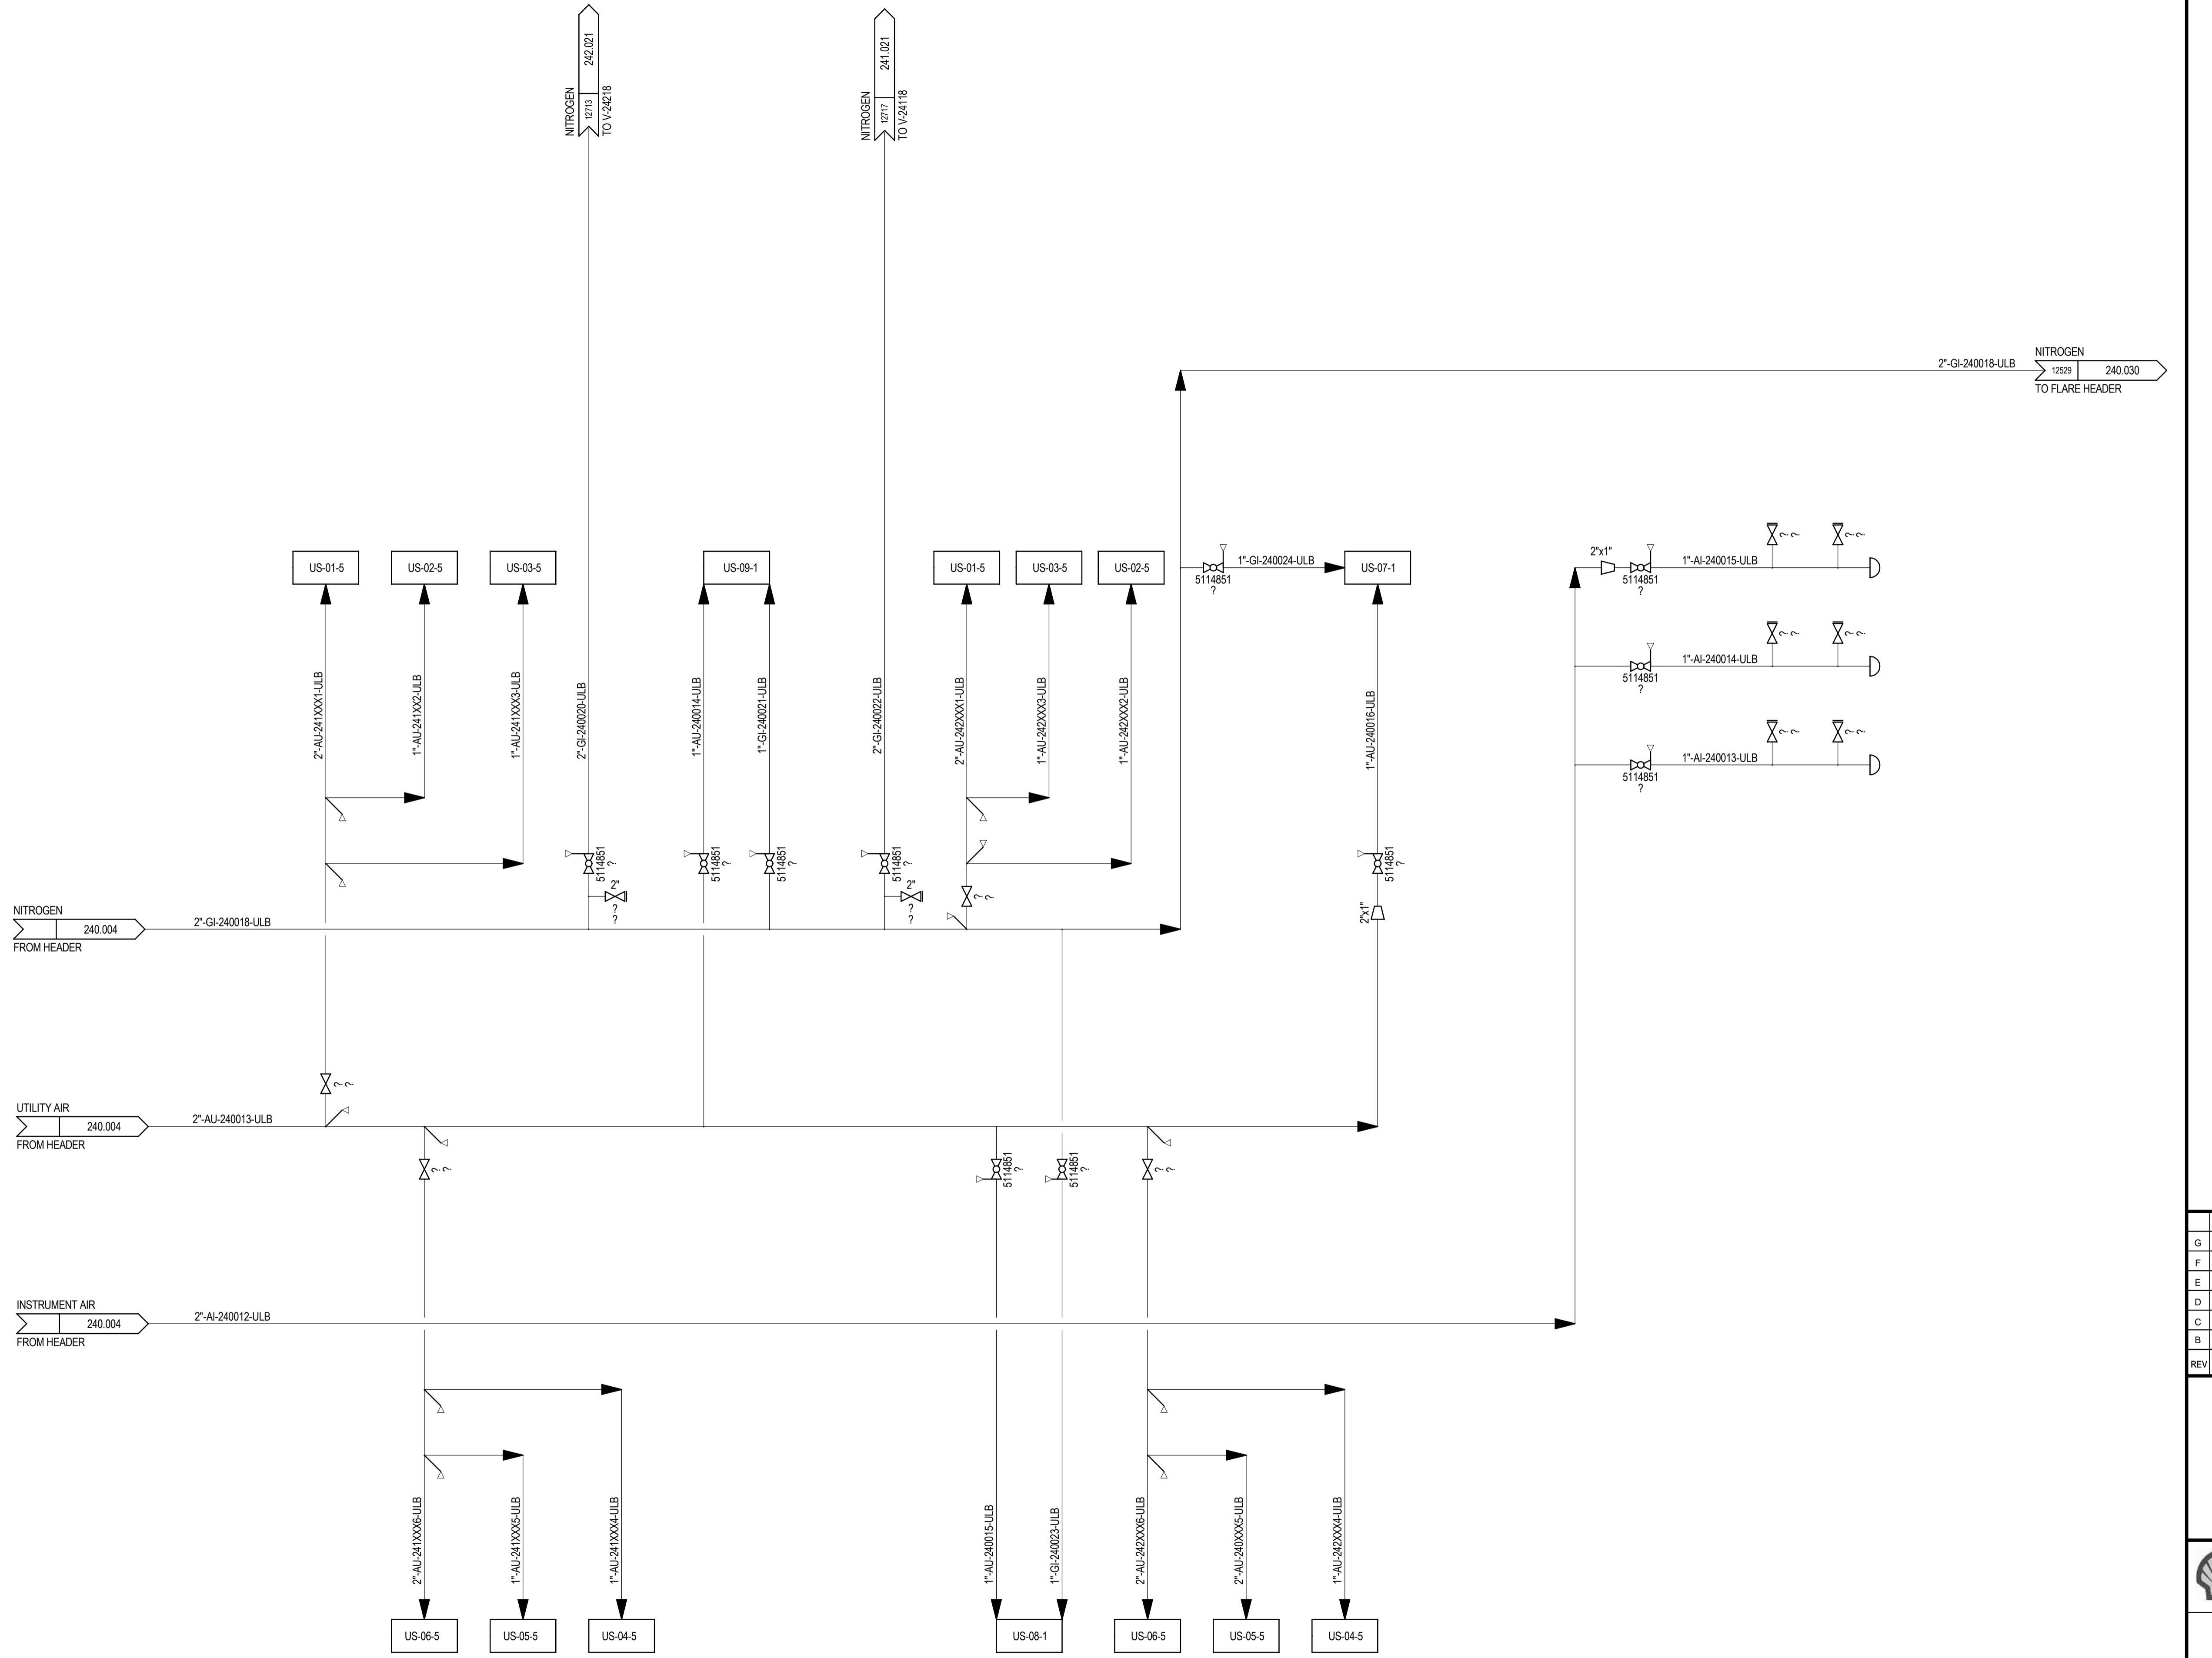

## NOTES:

- SEE DRAWINGS 200.0000.000.041.007 THRU 016 FOR SYMBOL IDENTIFICATION  
GENERAL NOTES & CONNECTION DETAILS.  
ALL INSTRUMENT TAG NUMBERS ARE PREFIXED BY "240" UNLESS OTHERWISE  
STATED.  
ESTG 3-1.01, PARAGRAPH 4.8.1 AND FIGURES A-18 THRU A-21 FOR UTILITY  
STATION DETAILS.  
PIPING HEADER BRANCH CONNECTIONS SHALL BE MADE ON TOP OF PIPE AND BE  
VALVED.

07/11/11	ISSUED FOR PHA III									
04/20/11	ISSUED FOR ESTIMATE									
03/01/11	ISSUED FOR PHA II									
01/10/11	ISSUED FOR CLIENT REVIEW									
12/02/10	ISSUED FOR INTERNAL REVIEW									
	ISSUED FOR PRELIMINARY REVIEW									
ISSUED	DESCRIPTION	BY	CKD	PRS	CS	PDP	MC	APE	PEM	CLIENT



SHELL CANADA  
QUEST CCS PROJECT


# **FLUOR**®

# **PIPING AND INSTRUMENT DIAGRAM QUEST CCS PROJECT**

# UNIT 240 - HYDROGEN MANUFACTURING UNIT

## INSTR. AIR UTILITY AIR AND NITROGEN DISTRIBUTION

SCALE: NONE | SHELL DWG NO.: 240 0000 000 041 028 | REV. G

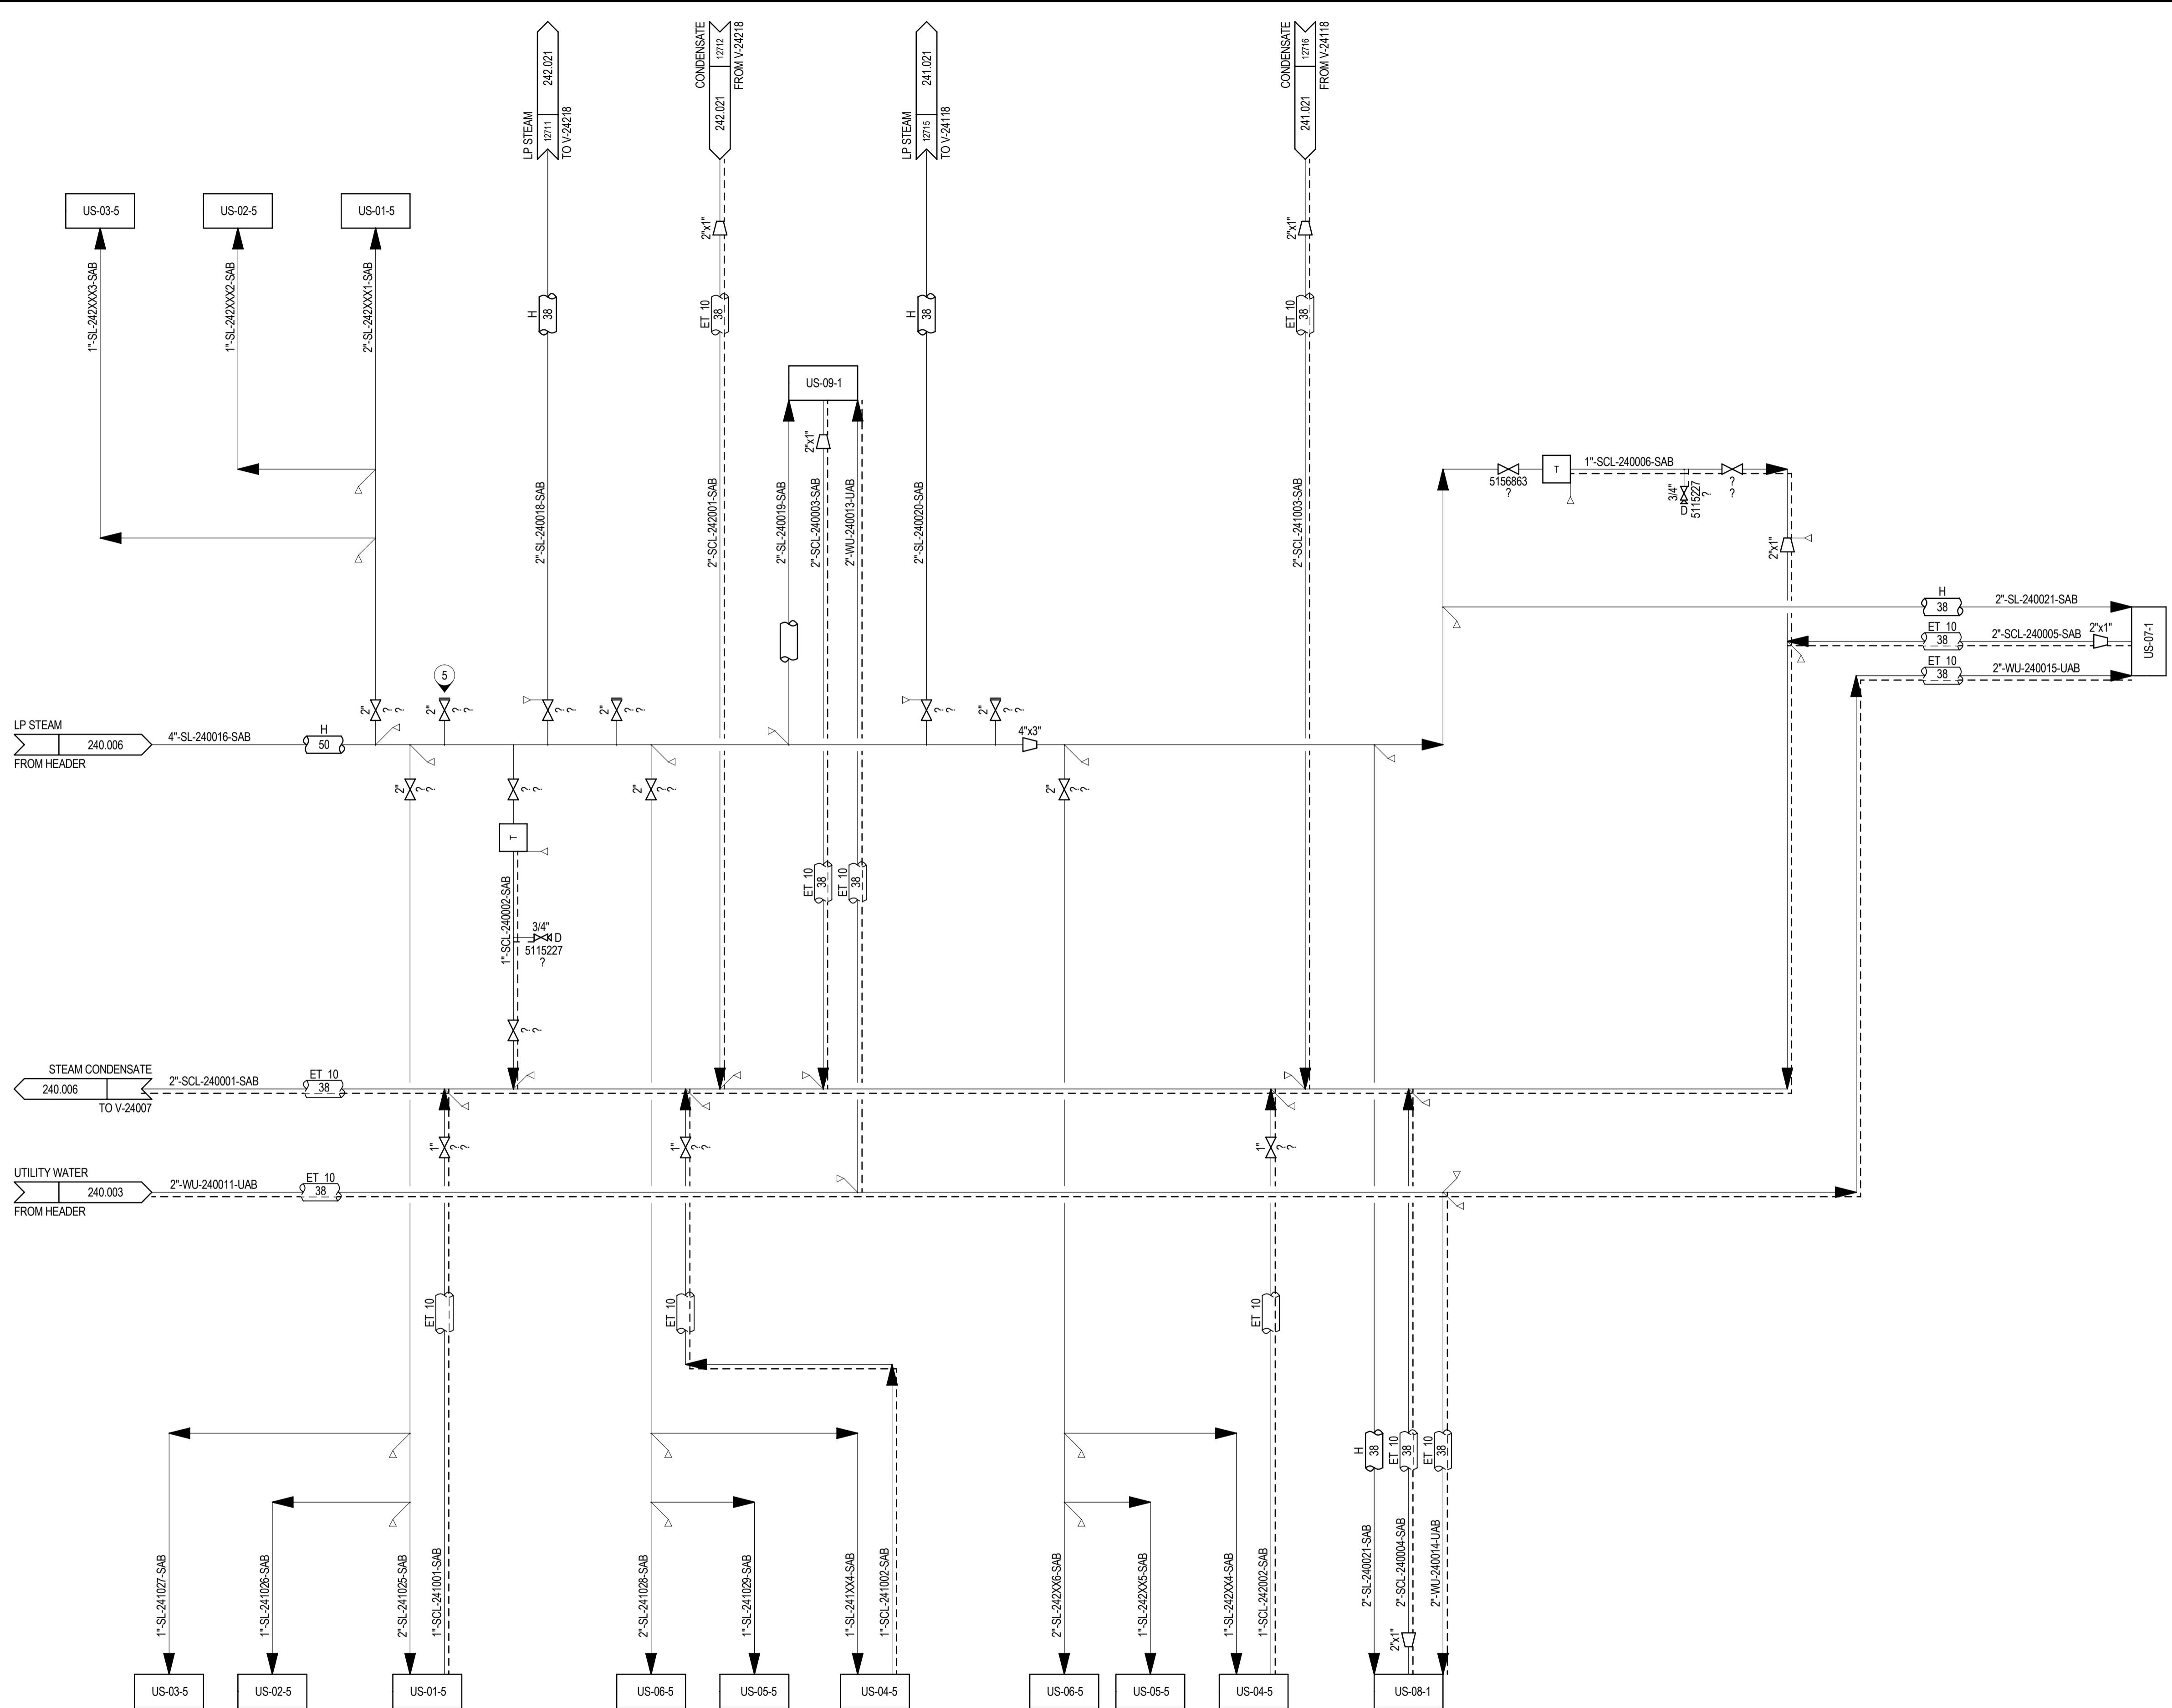

1. SEE DRAWINGS 200.000.000.041.007 THRU 016 FOR SYMBOL IDENTIFICATION GENERAL NOTES & CONNECTION DETAILS
2. ALL INSTRUMENT TAG NUMBERS ARE PREFIXED BY "240" UNLESS OTHERWISE STATED.
3. ESTG 3-1.01, PARAGRAPH 4.8.1 AND FIGURES A-18 THRU A-21 FOR UTILITY STATION DETAILS.
4. SATURATED STEAM TRAP AT ALL LOW POINTS AND IN HEADERS PER ESTG, INCLUDING END OF RUNS.
5. STEAM BLOW CONNECTION.
6. PIPING HEADER BRANCH CONNECTIONS SHALL BE MADE ON TOP OF PIPE AND BE VALVED.

**HOLDS:**

- NUMBER OF RVs AND SIZING TO BE CONFIRMED DURING DETAILED ENGINEERING.
- INSTRUMENT SIZING TO BE CONFIRMED DURING DETAILED ENGINEERING.
- NUMBER OF UTILITY STATIONS PER COLUMN TO BE DETERMINED IN DETAILED DESIGN.
- STEAM LINE SIZING FOR STEAM-OUT.

G	07/11/11	ISSUED FOR PHA III
F	04/20/11	ISSUED FOR ESTIMATE
E	03/01/11	ISSUED FOR PHA.II
D	01/10/11	ISSUED FOR CLIENT REVIEW
C	12/02/10	ISSUED FOR INTERNAL REVIEW
B		ISSUED FOR PRELIMINARY REVIEW
REV	ISSUED DATE	DESCRIPTION
		BY CKD PRS CS PDP MC APE PEM
		CLIENT APP



**SHELL CANADA**  
QUEST CCS PROJECT


**FLUOR®**

PIPING AND INSTRUMENT DIAGRAM  
QUEST CCS PROJECT

UNIT 240 - HYDROGEN MANUFACTURING UNIT  
LP STEAM COND. AND UTILITY WATER DISTRIBUTION

SCALE: NONE  
SHELL DWG NO.: 240.0000.000.041.029

REV. G

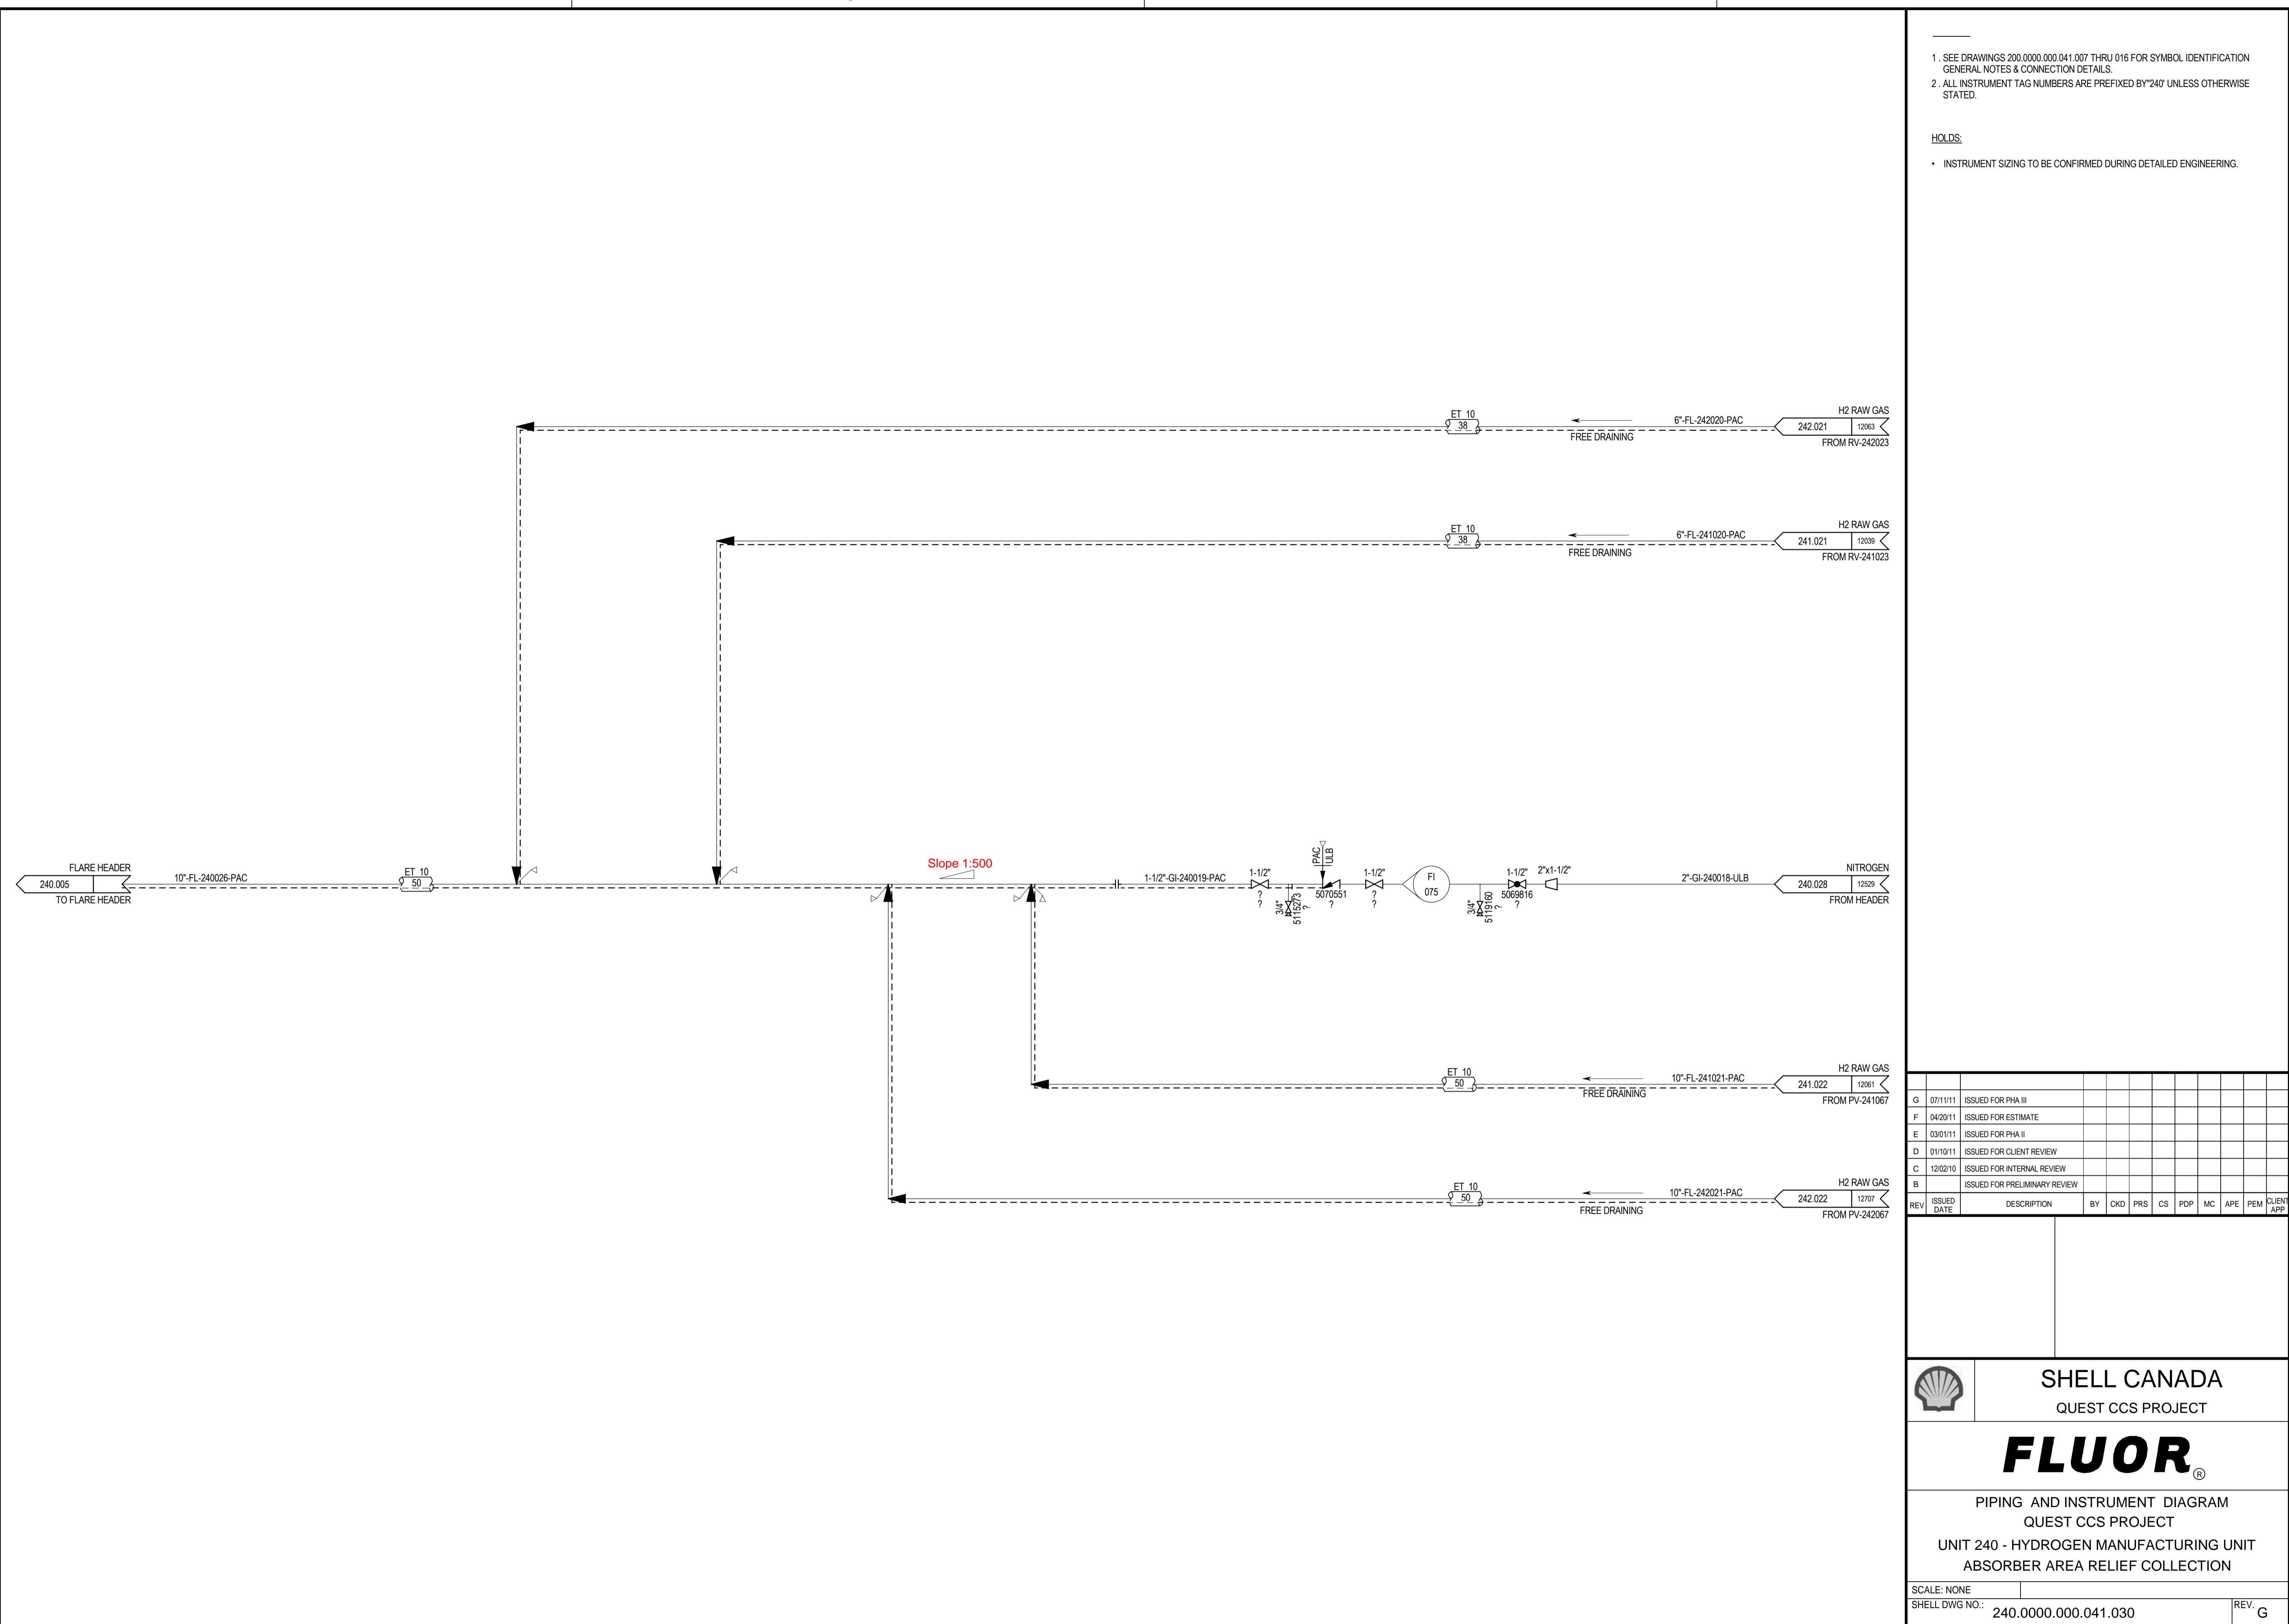

4

3

2

1

D


D

C

C


B

B

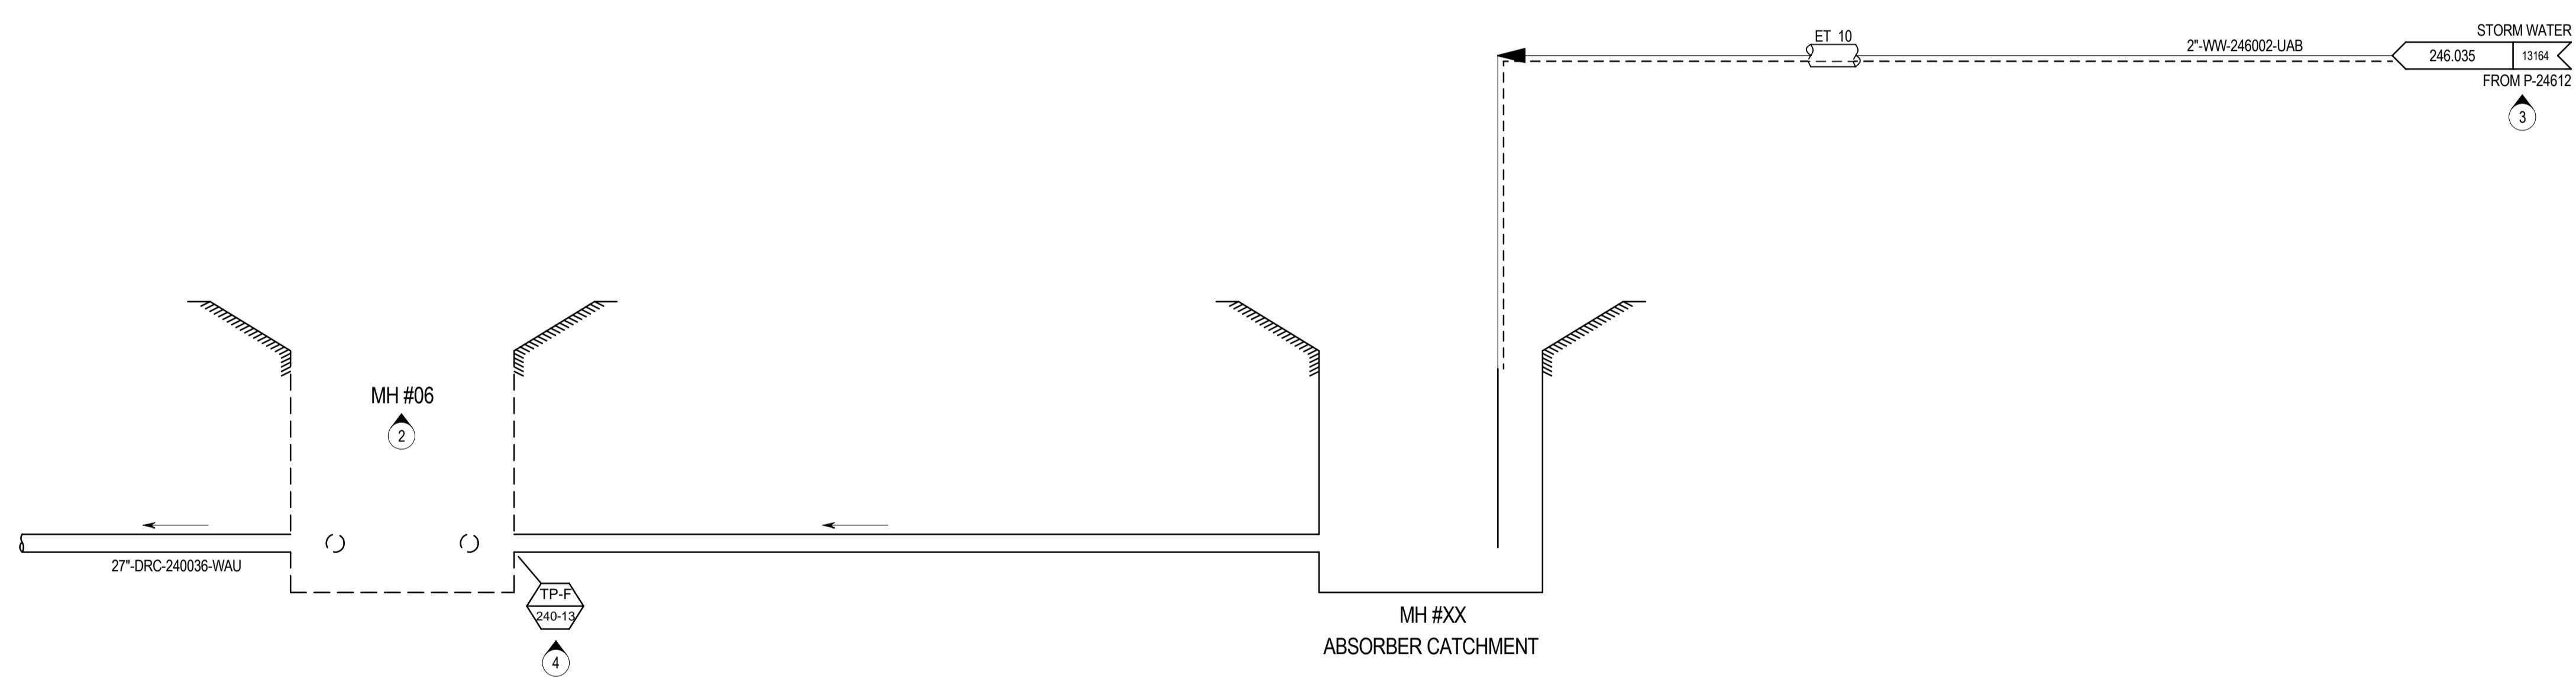

1. SEE DRAWINGS 200.000.000.041.007 THRU 016 FOR SYMBOL IDENTIFICATION GENERAL NOTES & CONNECTION DETAILS.
2. SEE 240.2315.000.050.011.
3. STORM WATER FROM UNIT 246 "QUEST CAPTURE" TO BE ROUTED TO NEW CATCH BASIN IN HMU 1 & 2 ABSORBER AREA.
4. NEW CATCH BASIN TO DRAIN TO TIE-IN AT MH #06.

G	07/11/11	ISSUED FOR PHA III																
REV	ISSUED DATE	DESCRIPTION	BY	CKD	PRS	CS	PDP	MC	APE	PEM	CLIENT APP							

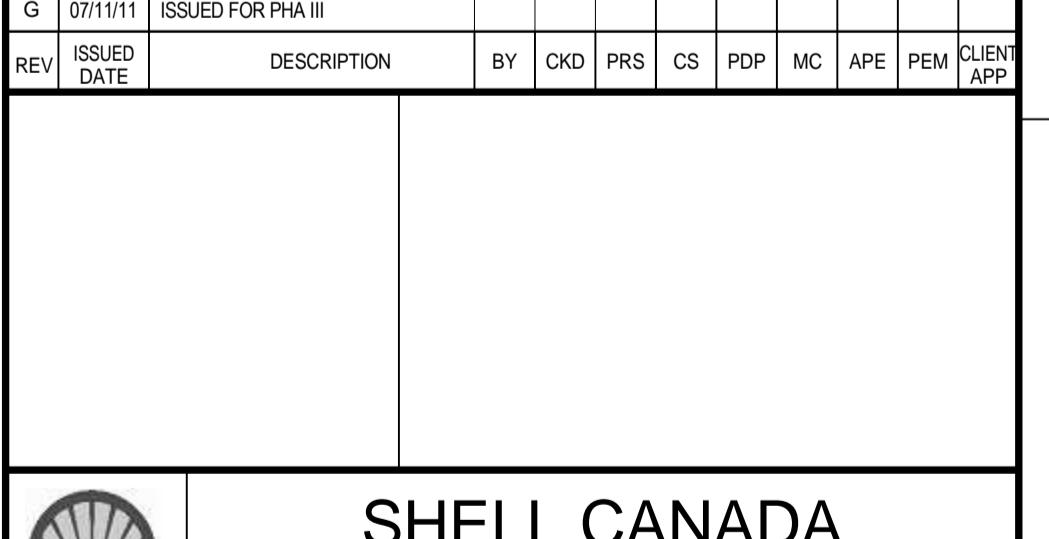



PIPING AND INSTRUMENT DIAGRAM  
QUEST CCS PROJECT  
UNIT 240 - HYDROGEN MANUFACTURING UNIT  
STORM WATER DRAINAGE & POTENTIALLY OILY SWS


SCALE: NONE


SHELL DWG NO.: 240.0000.000.041.032


REV. G

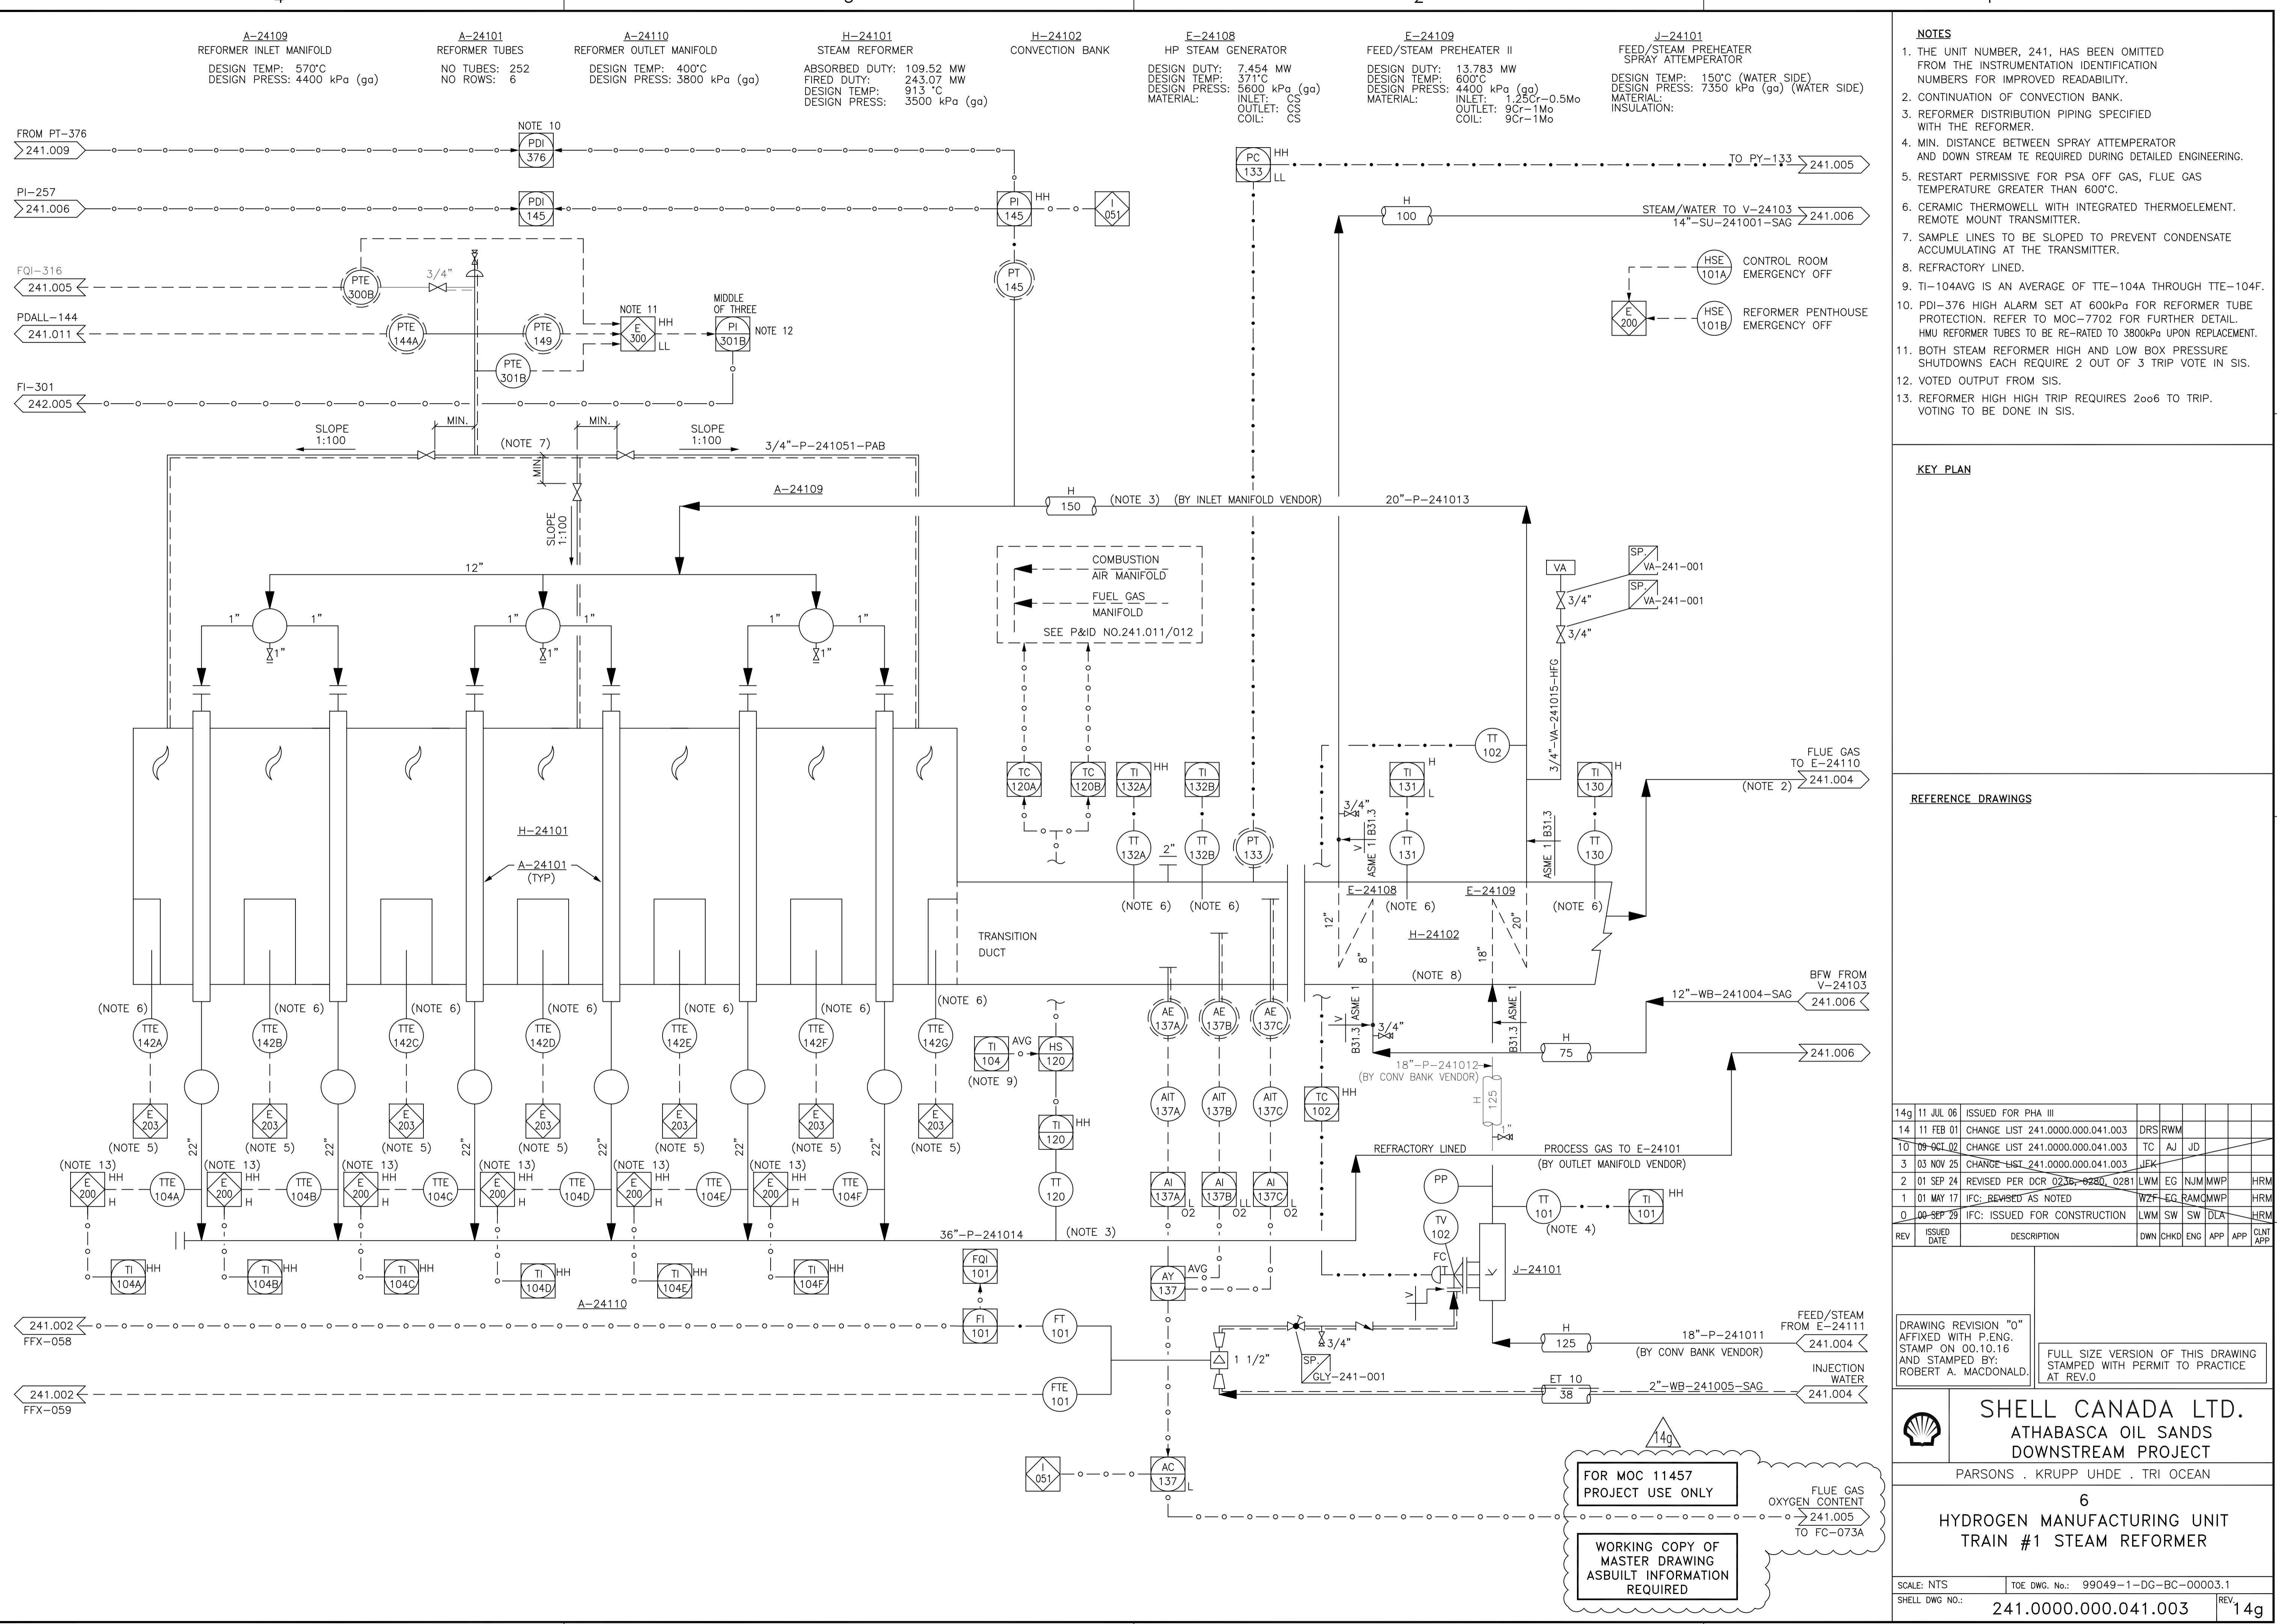


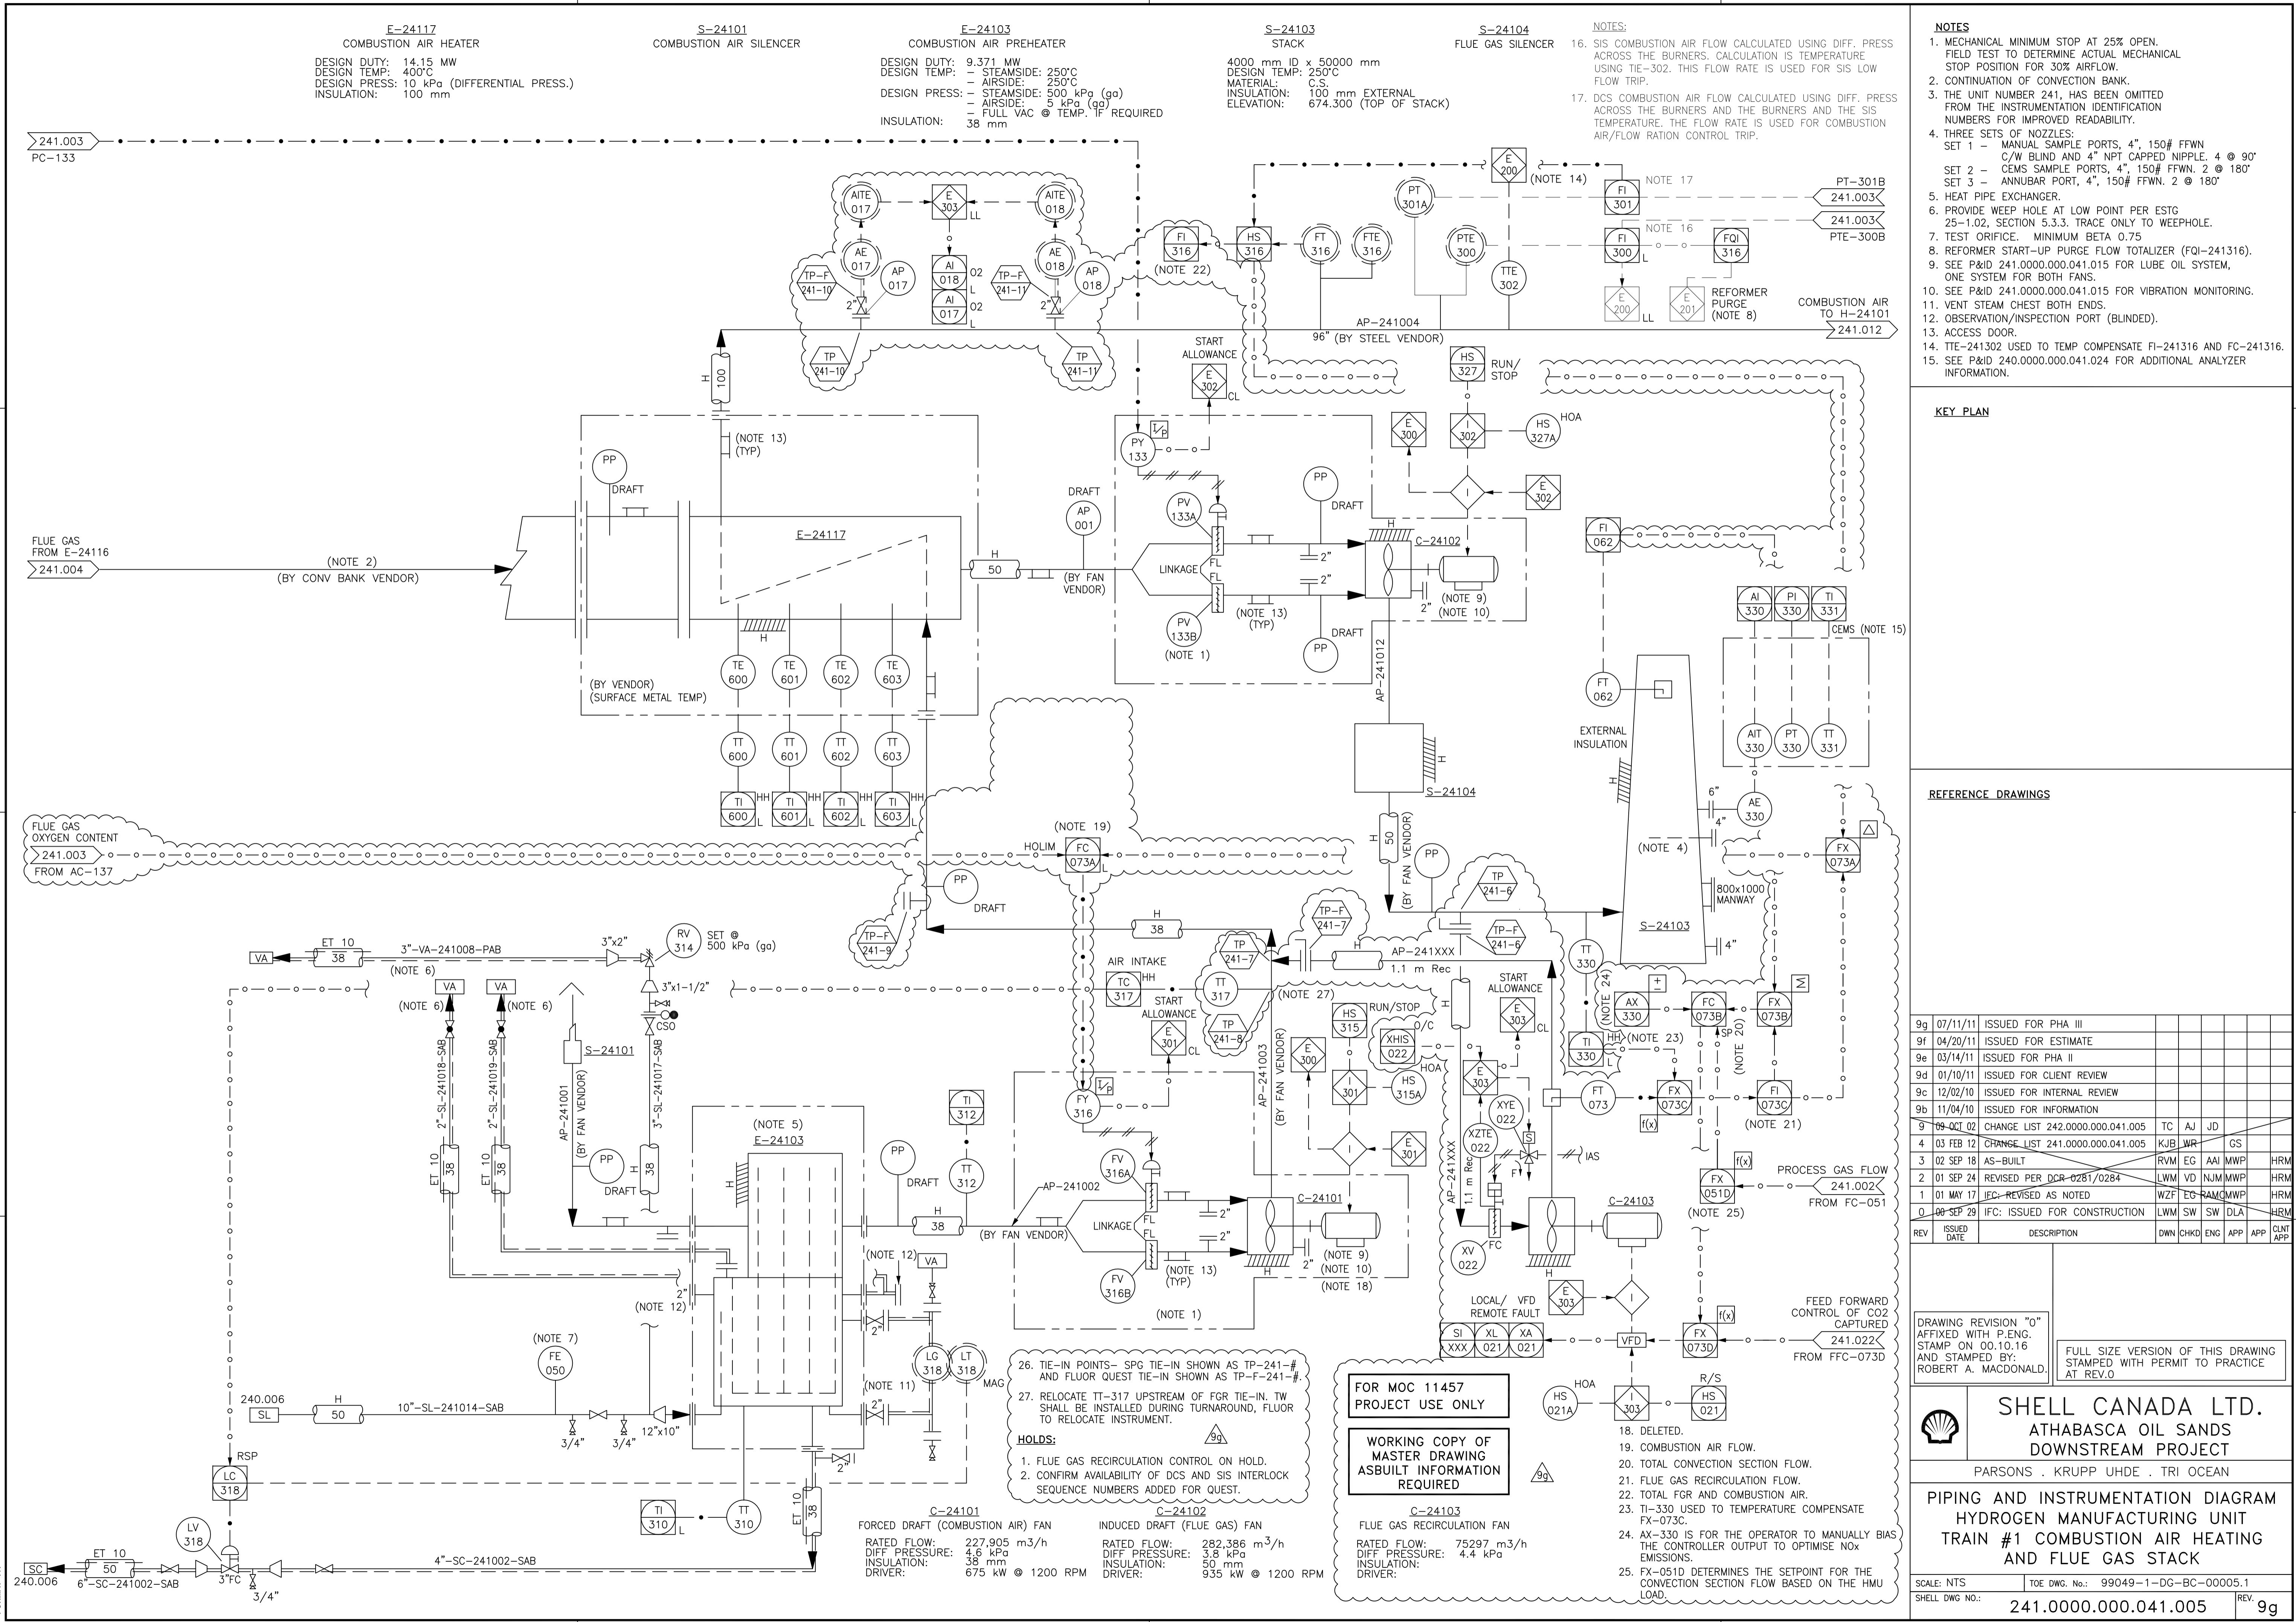


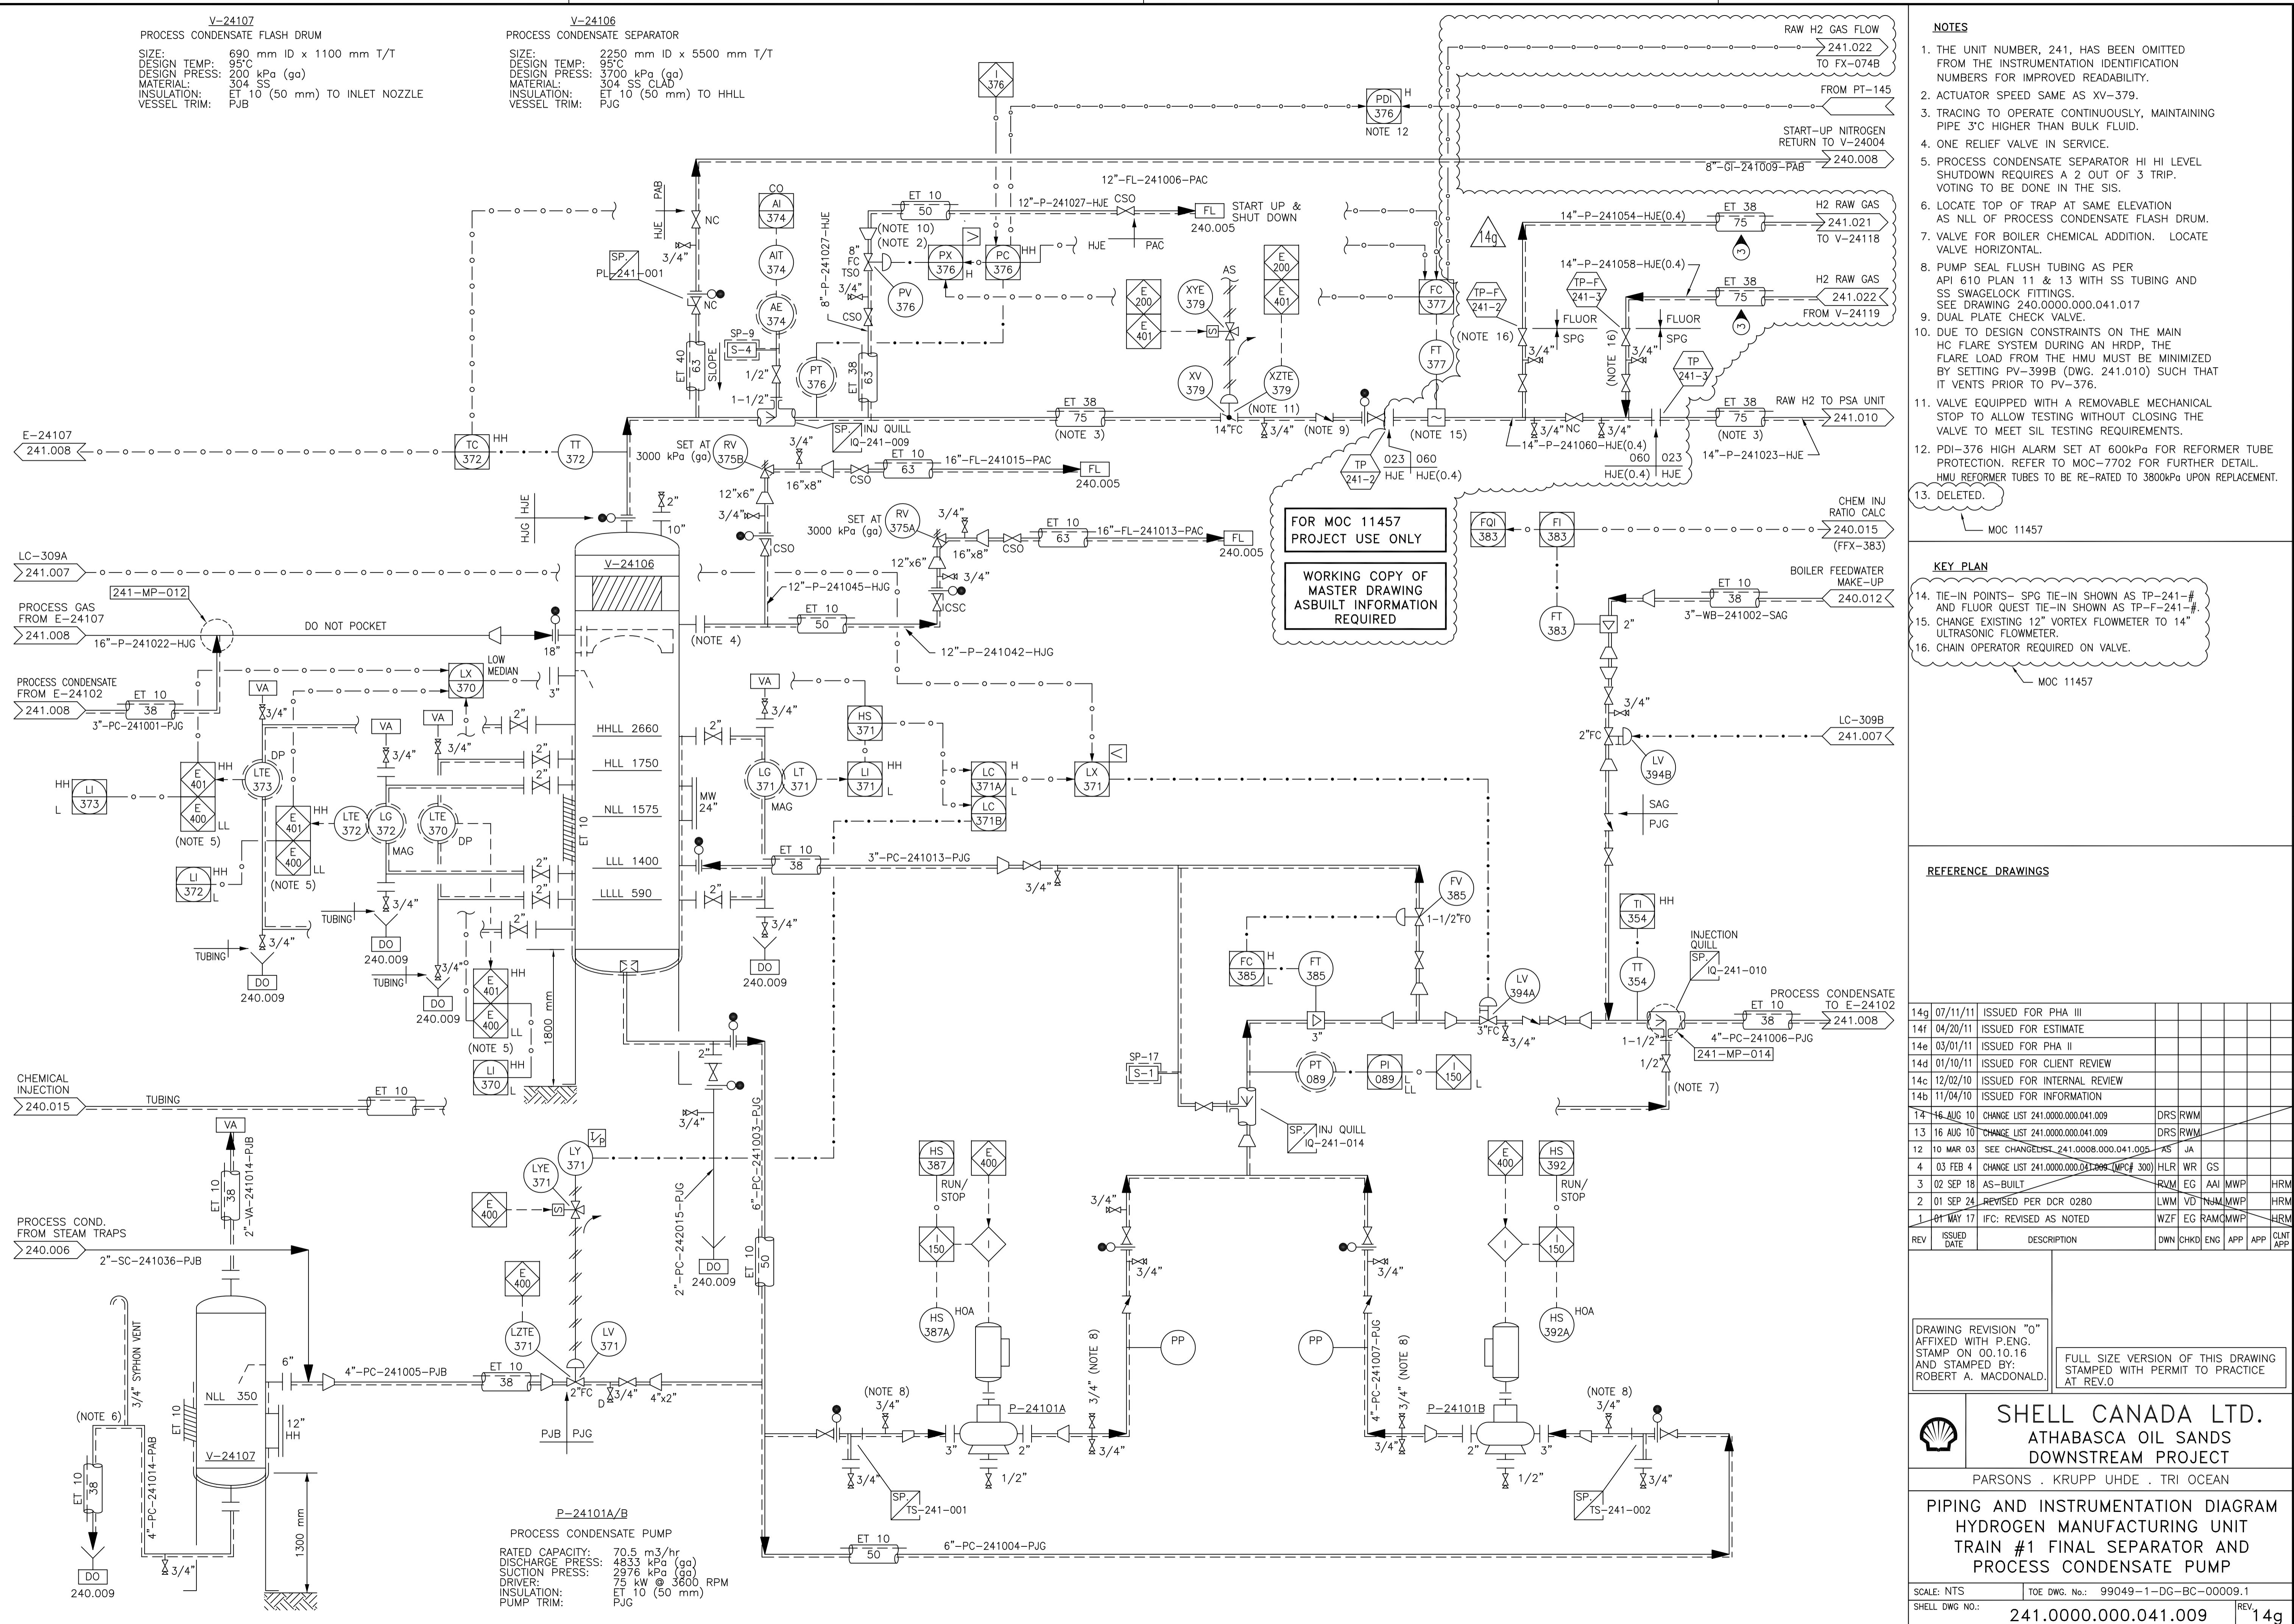


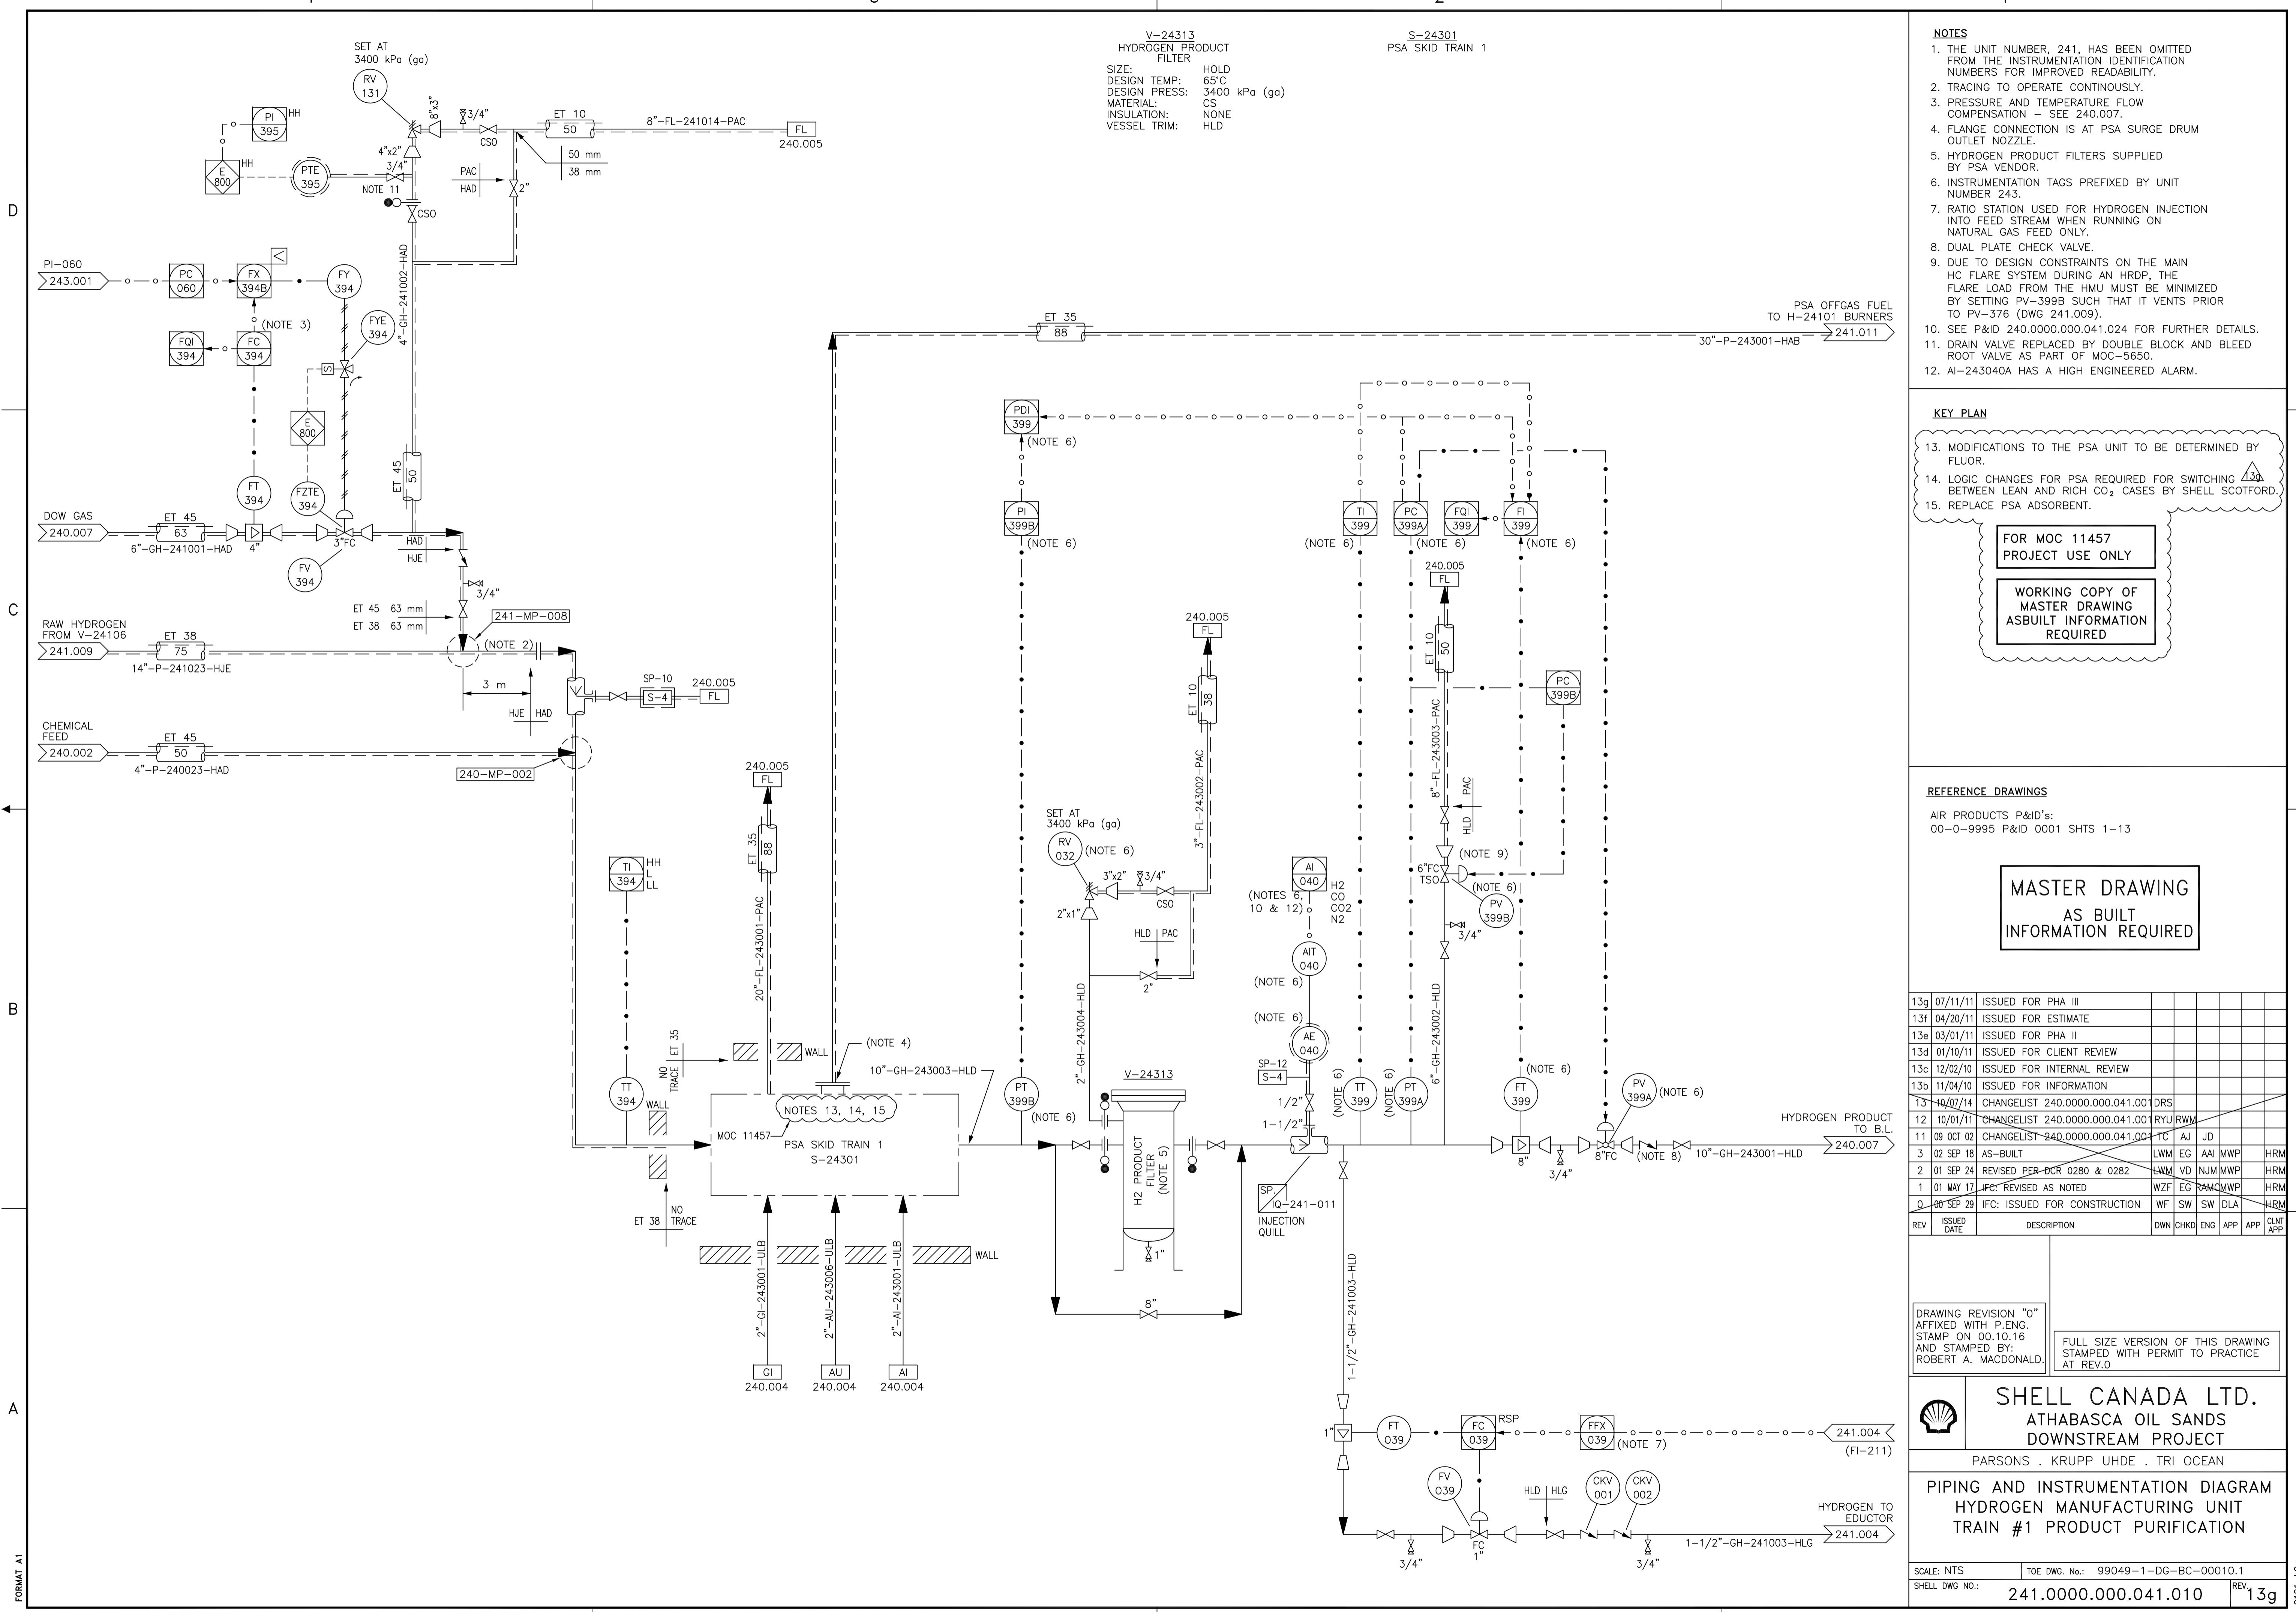


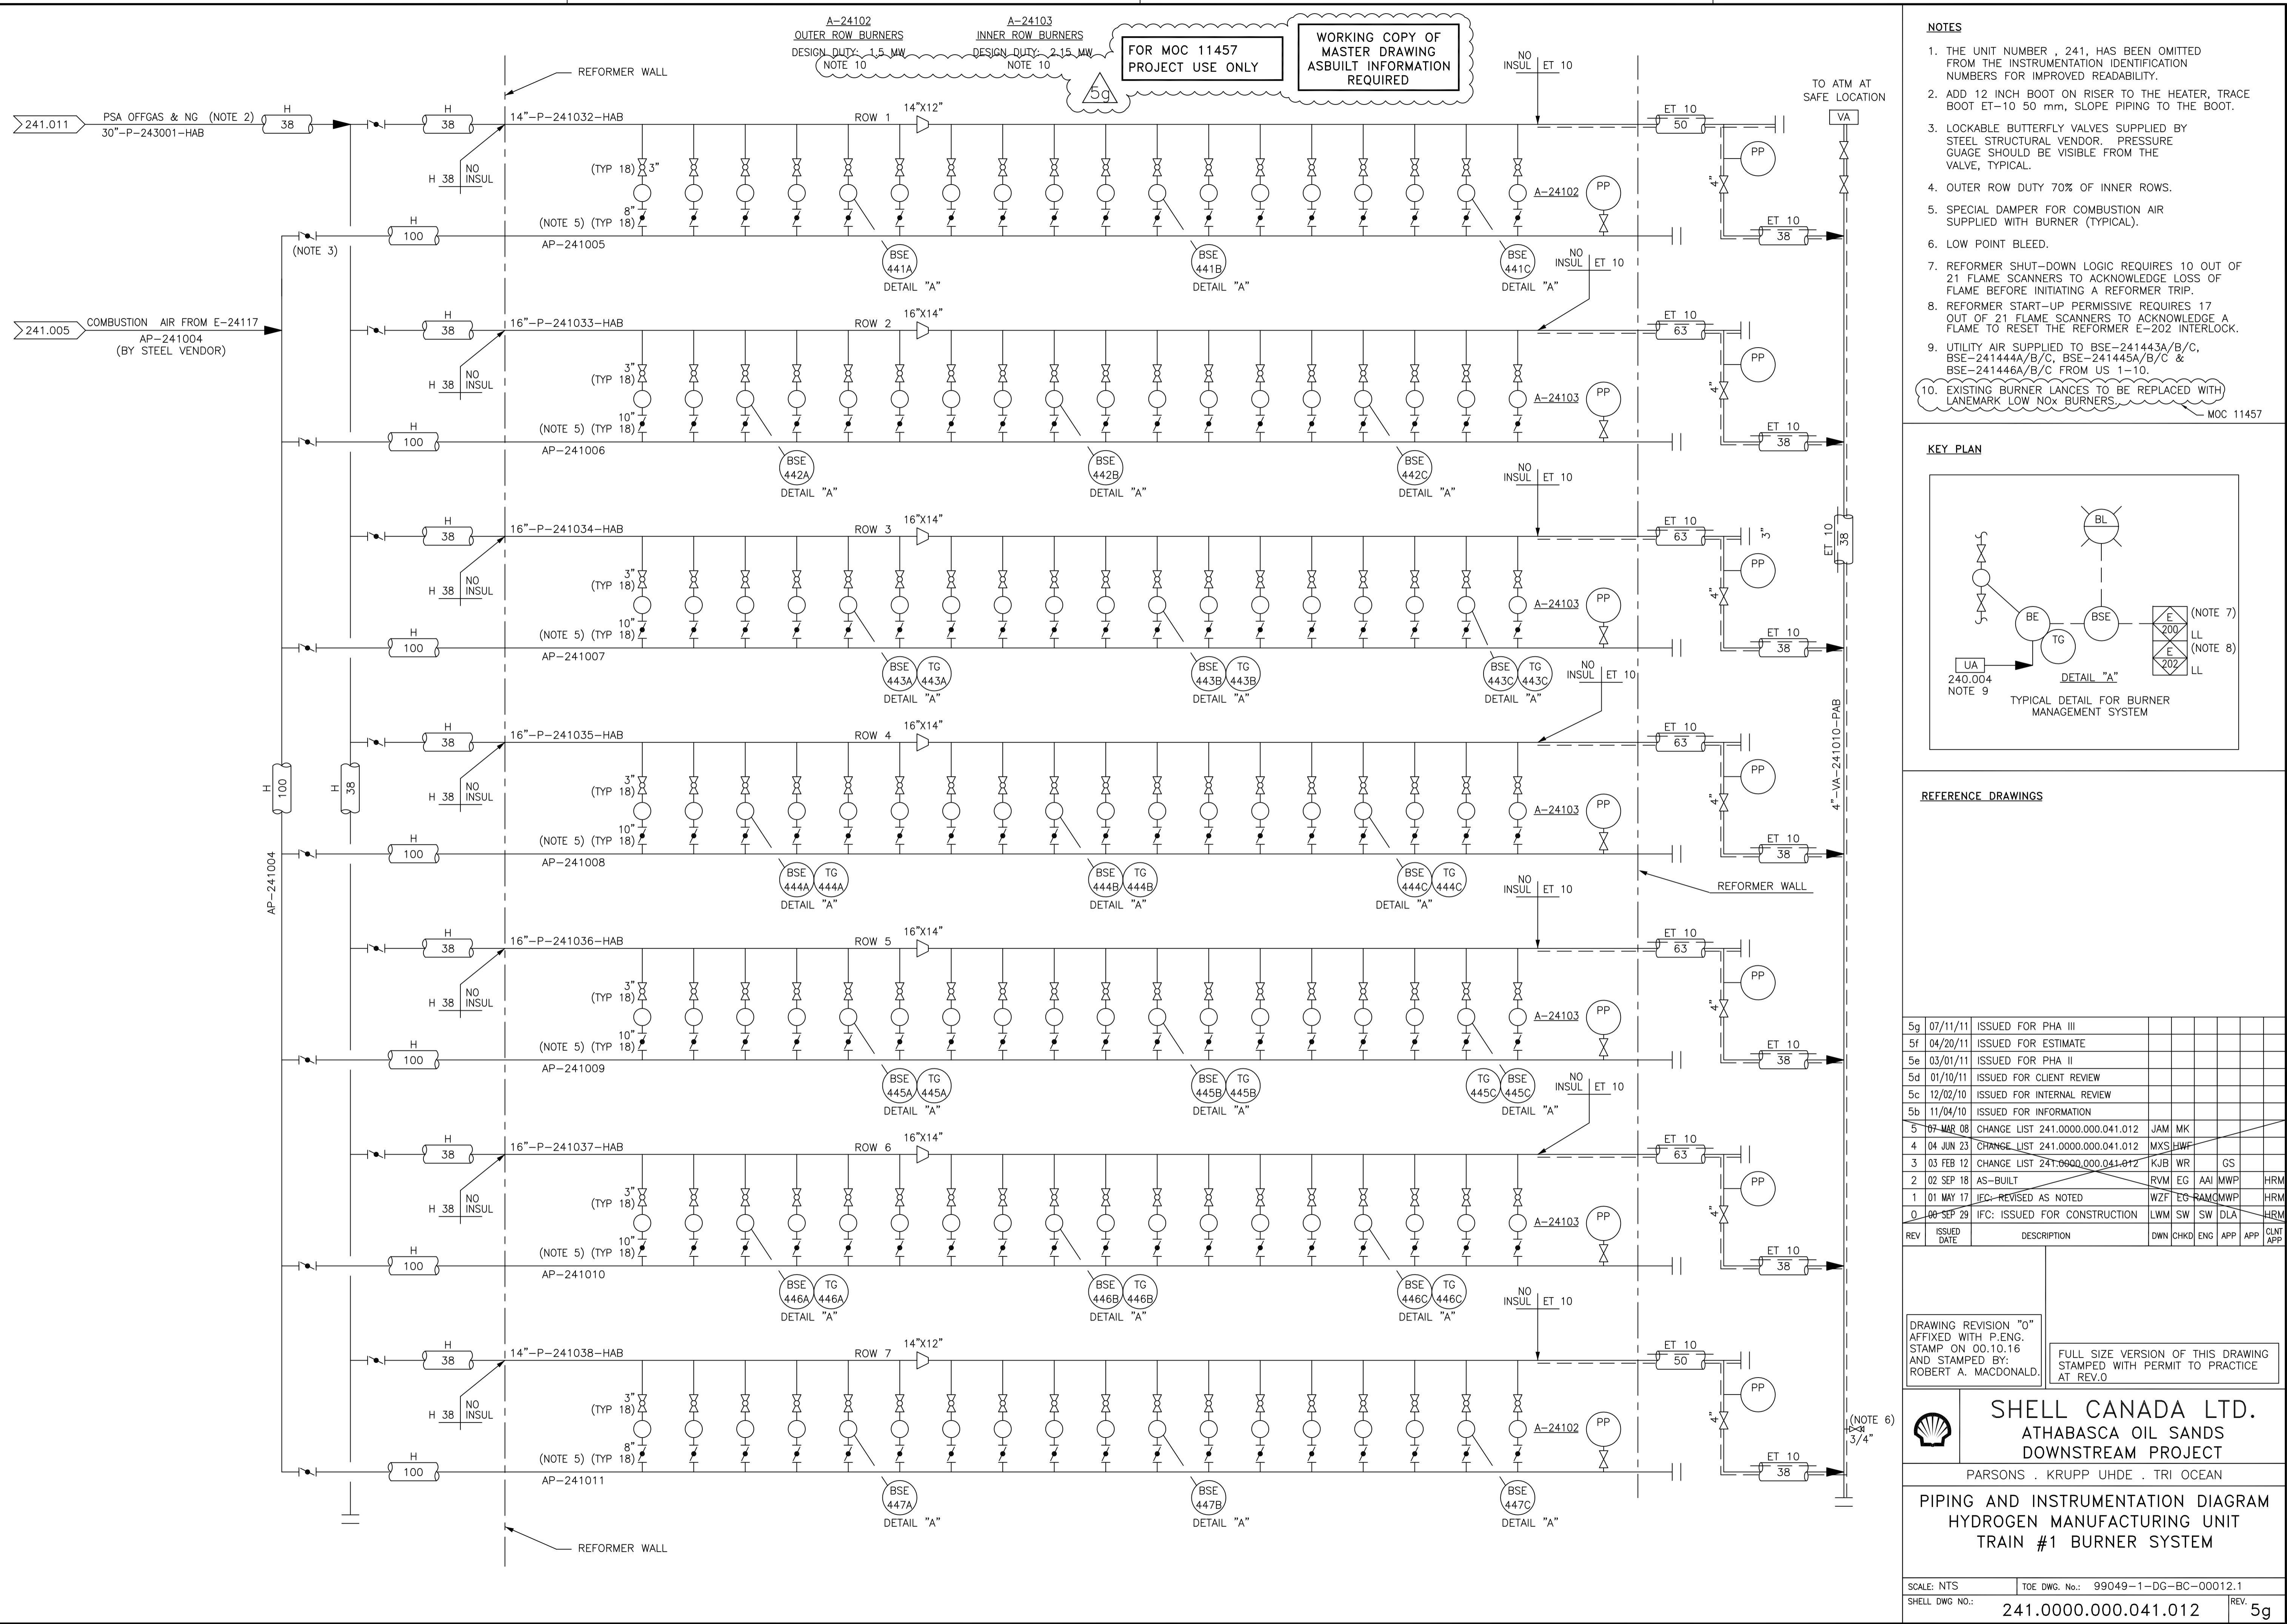


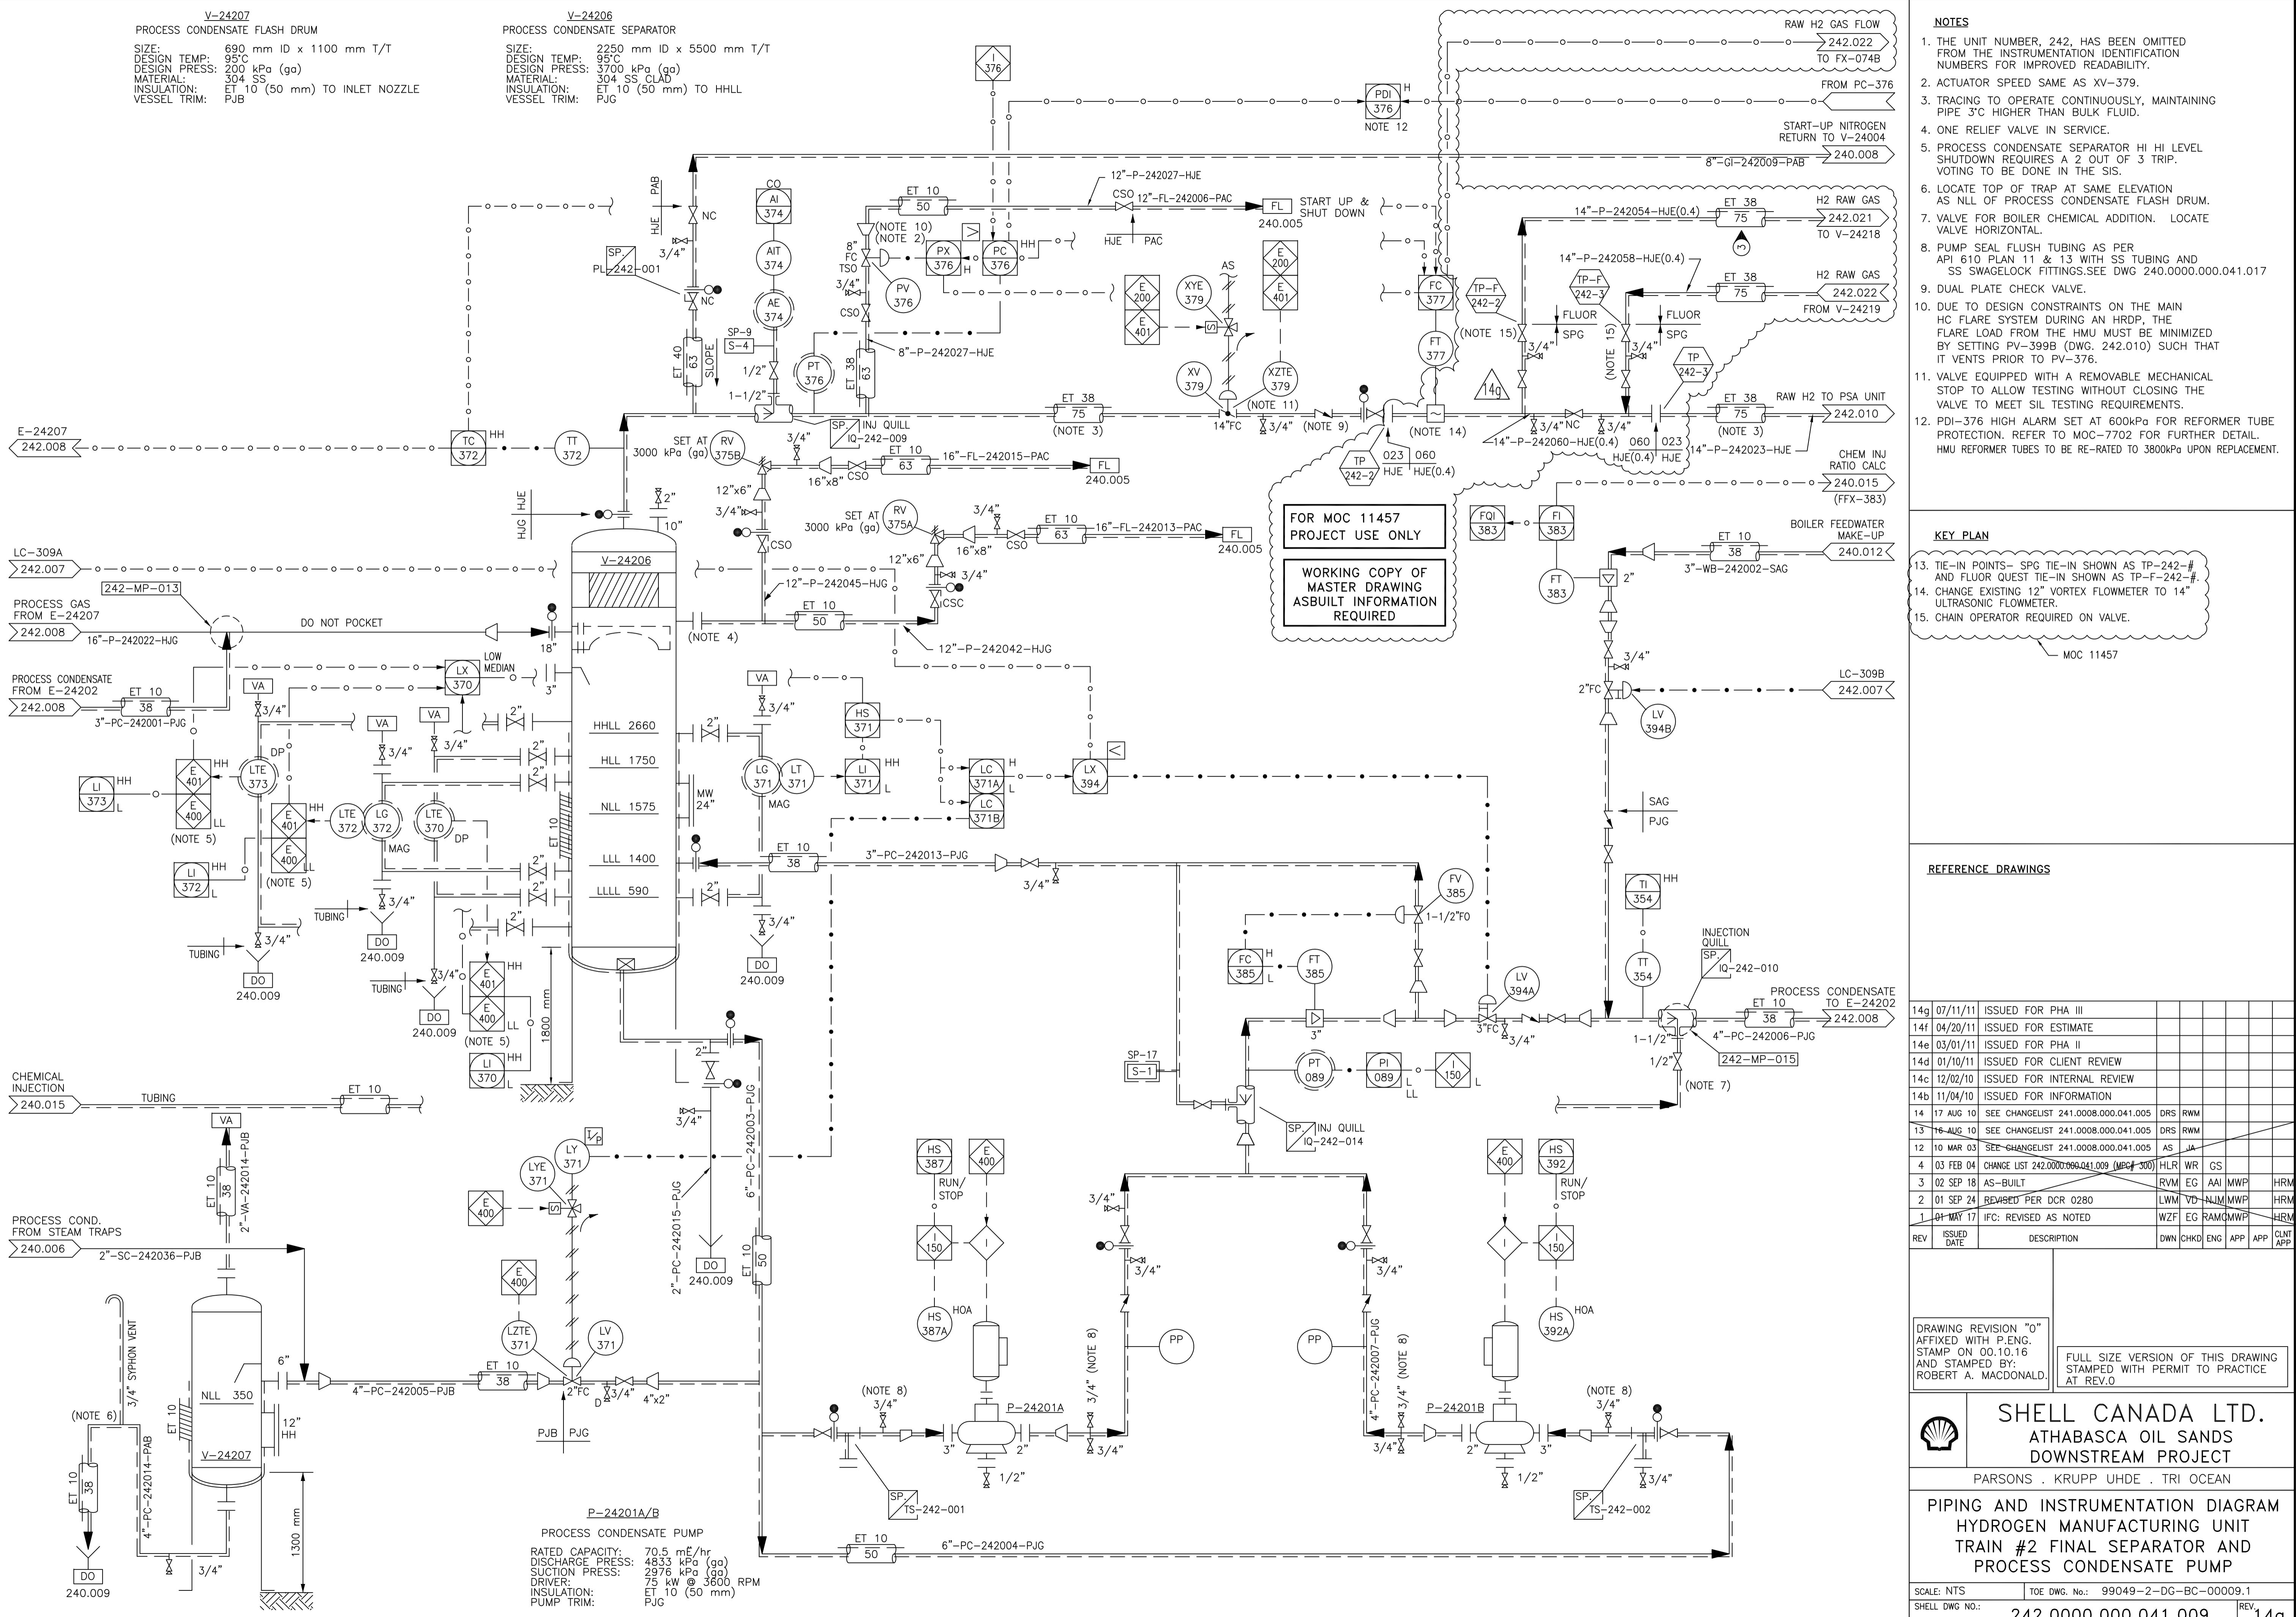


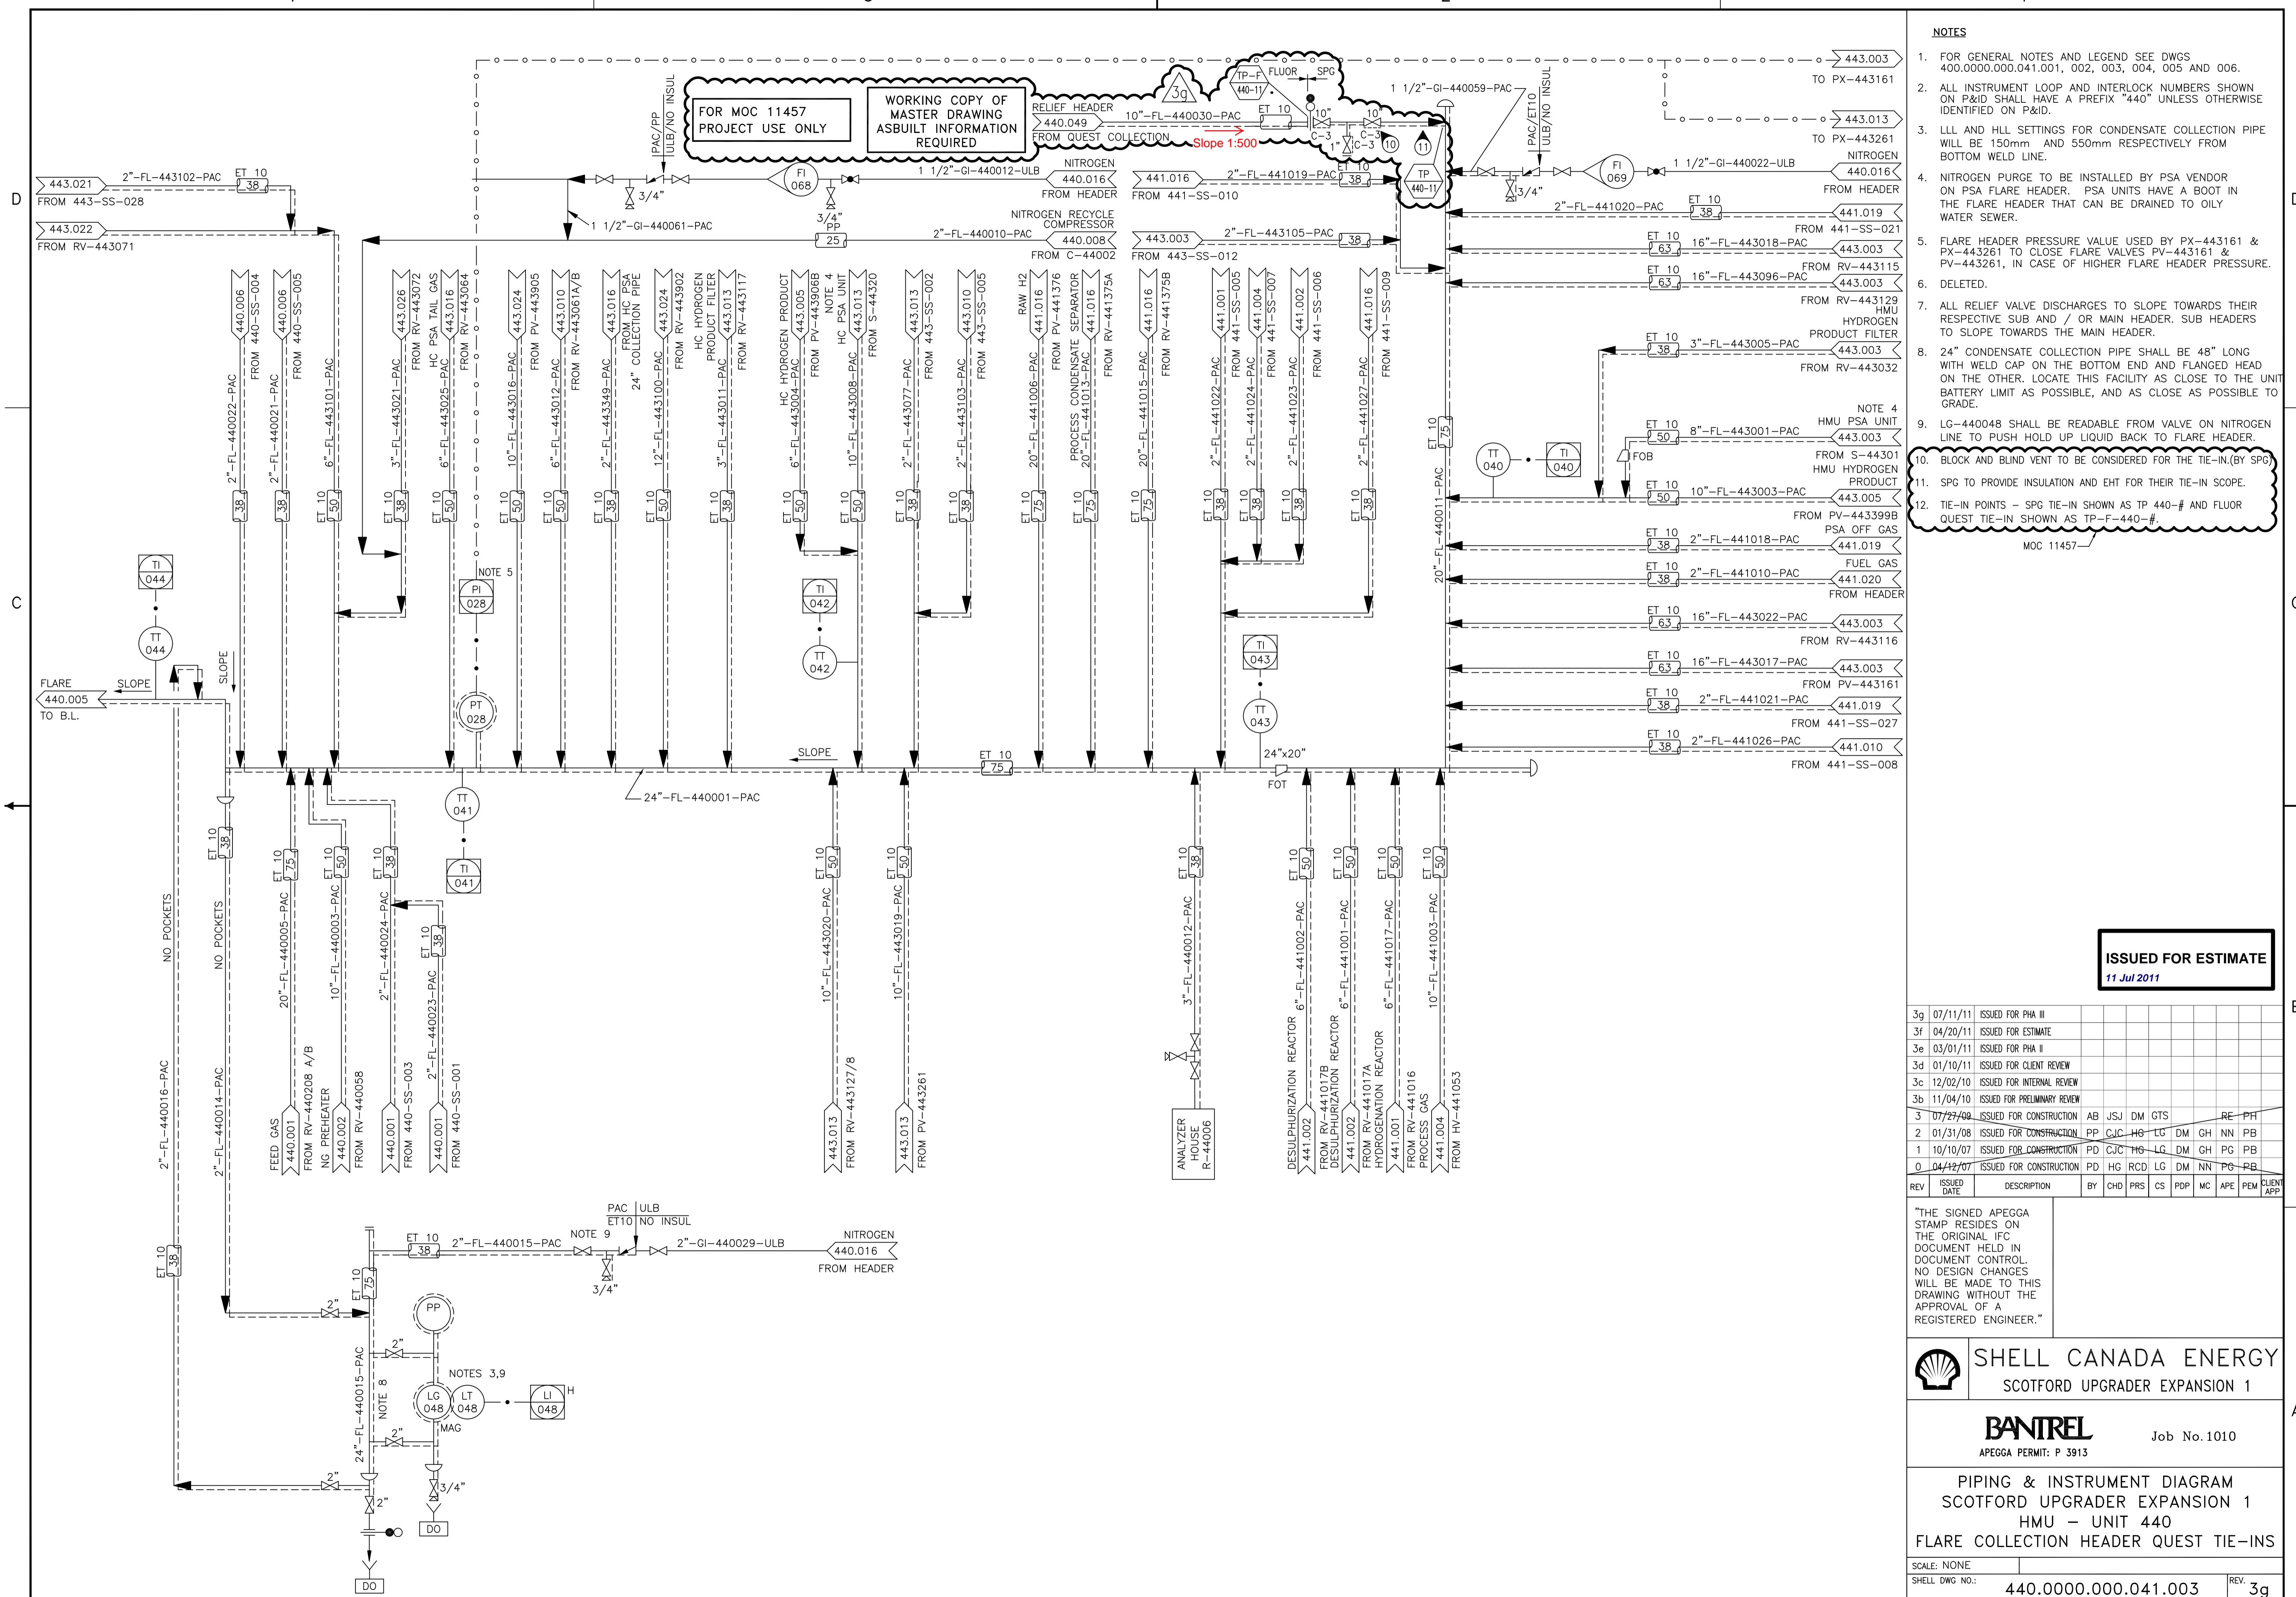

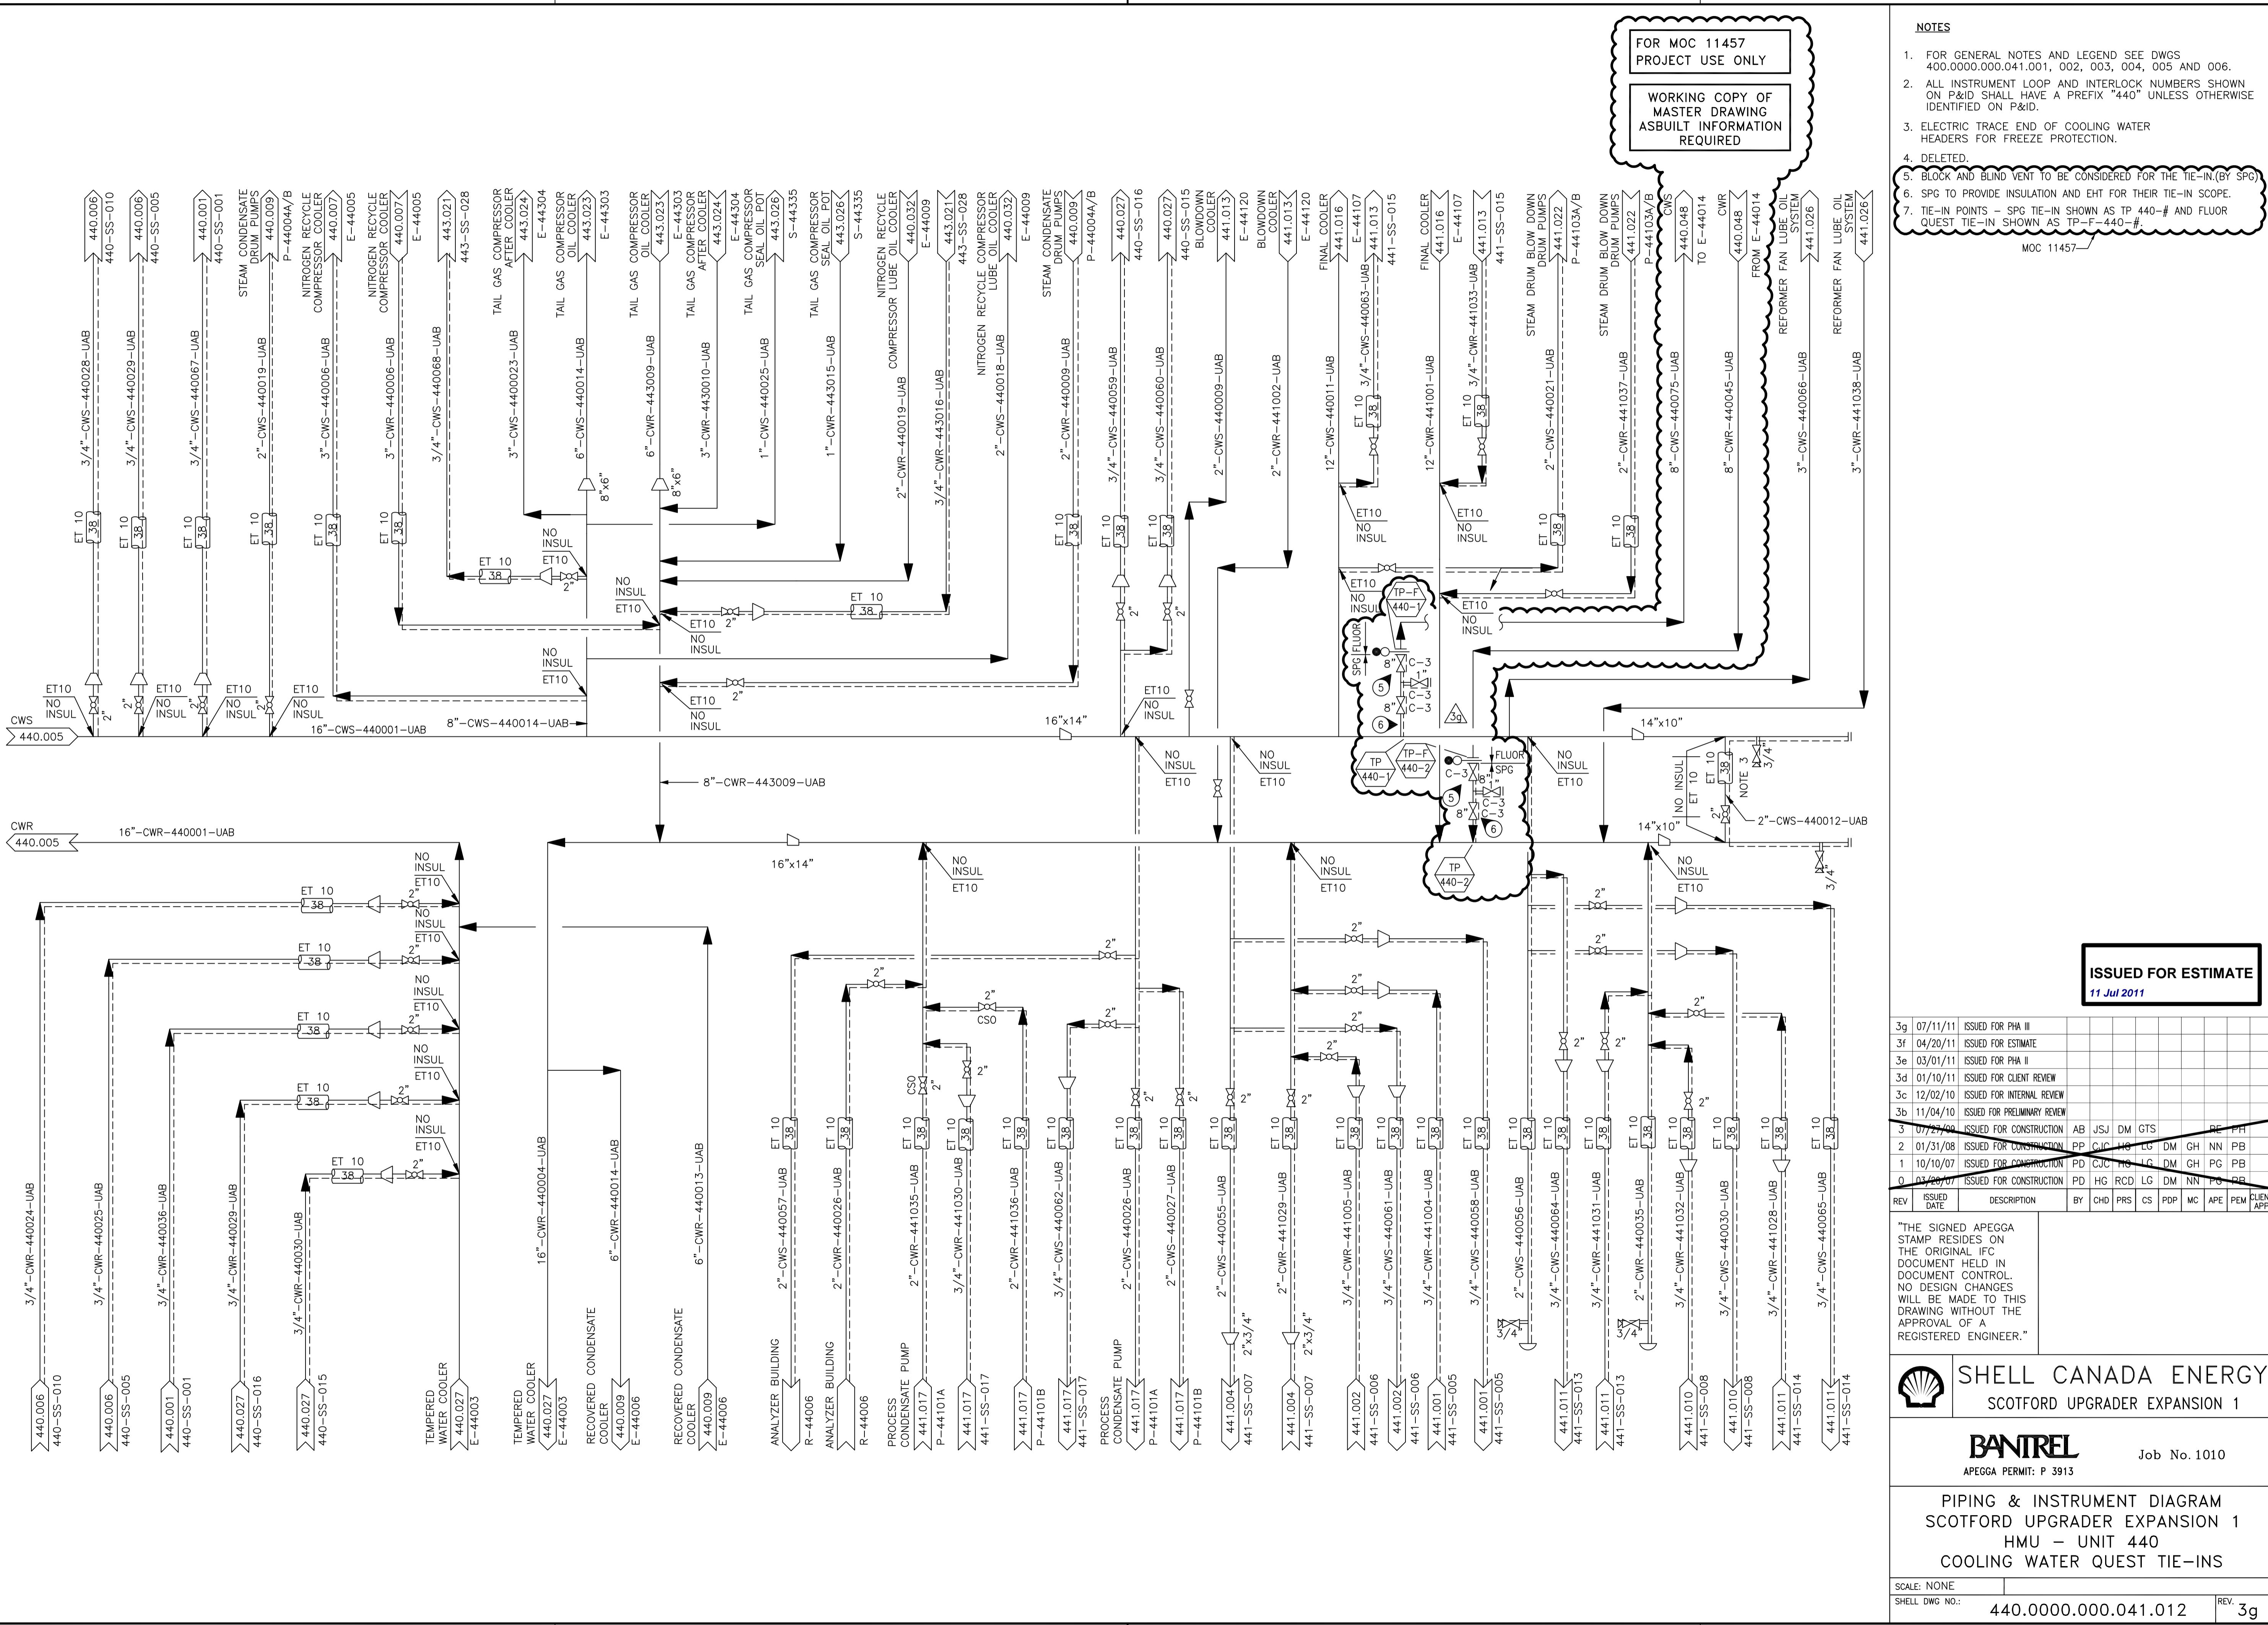

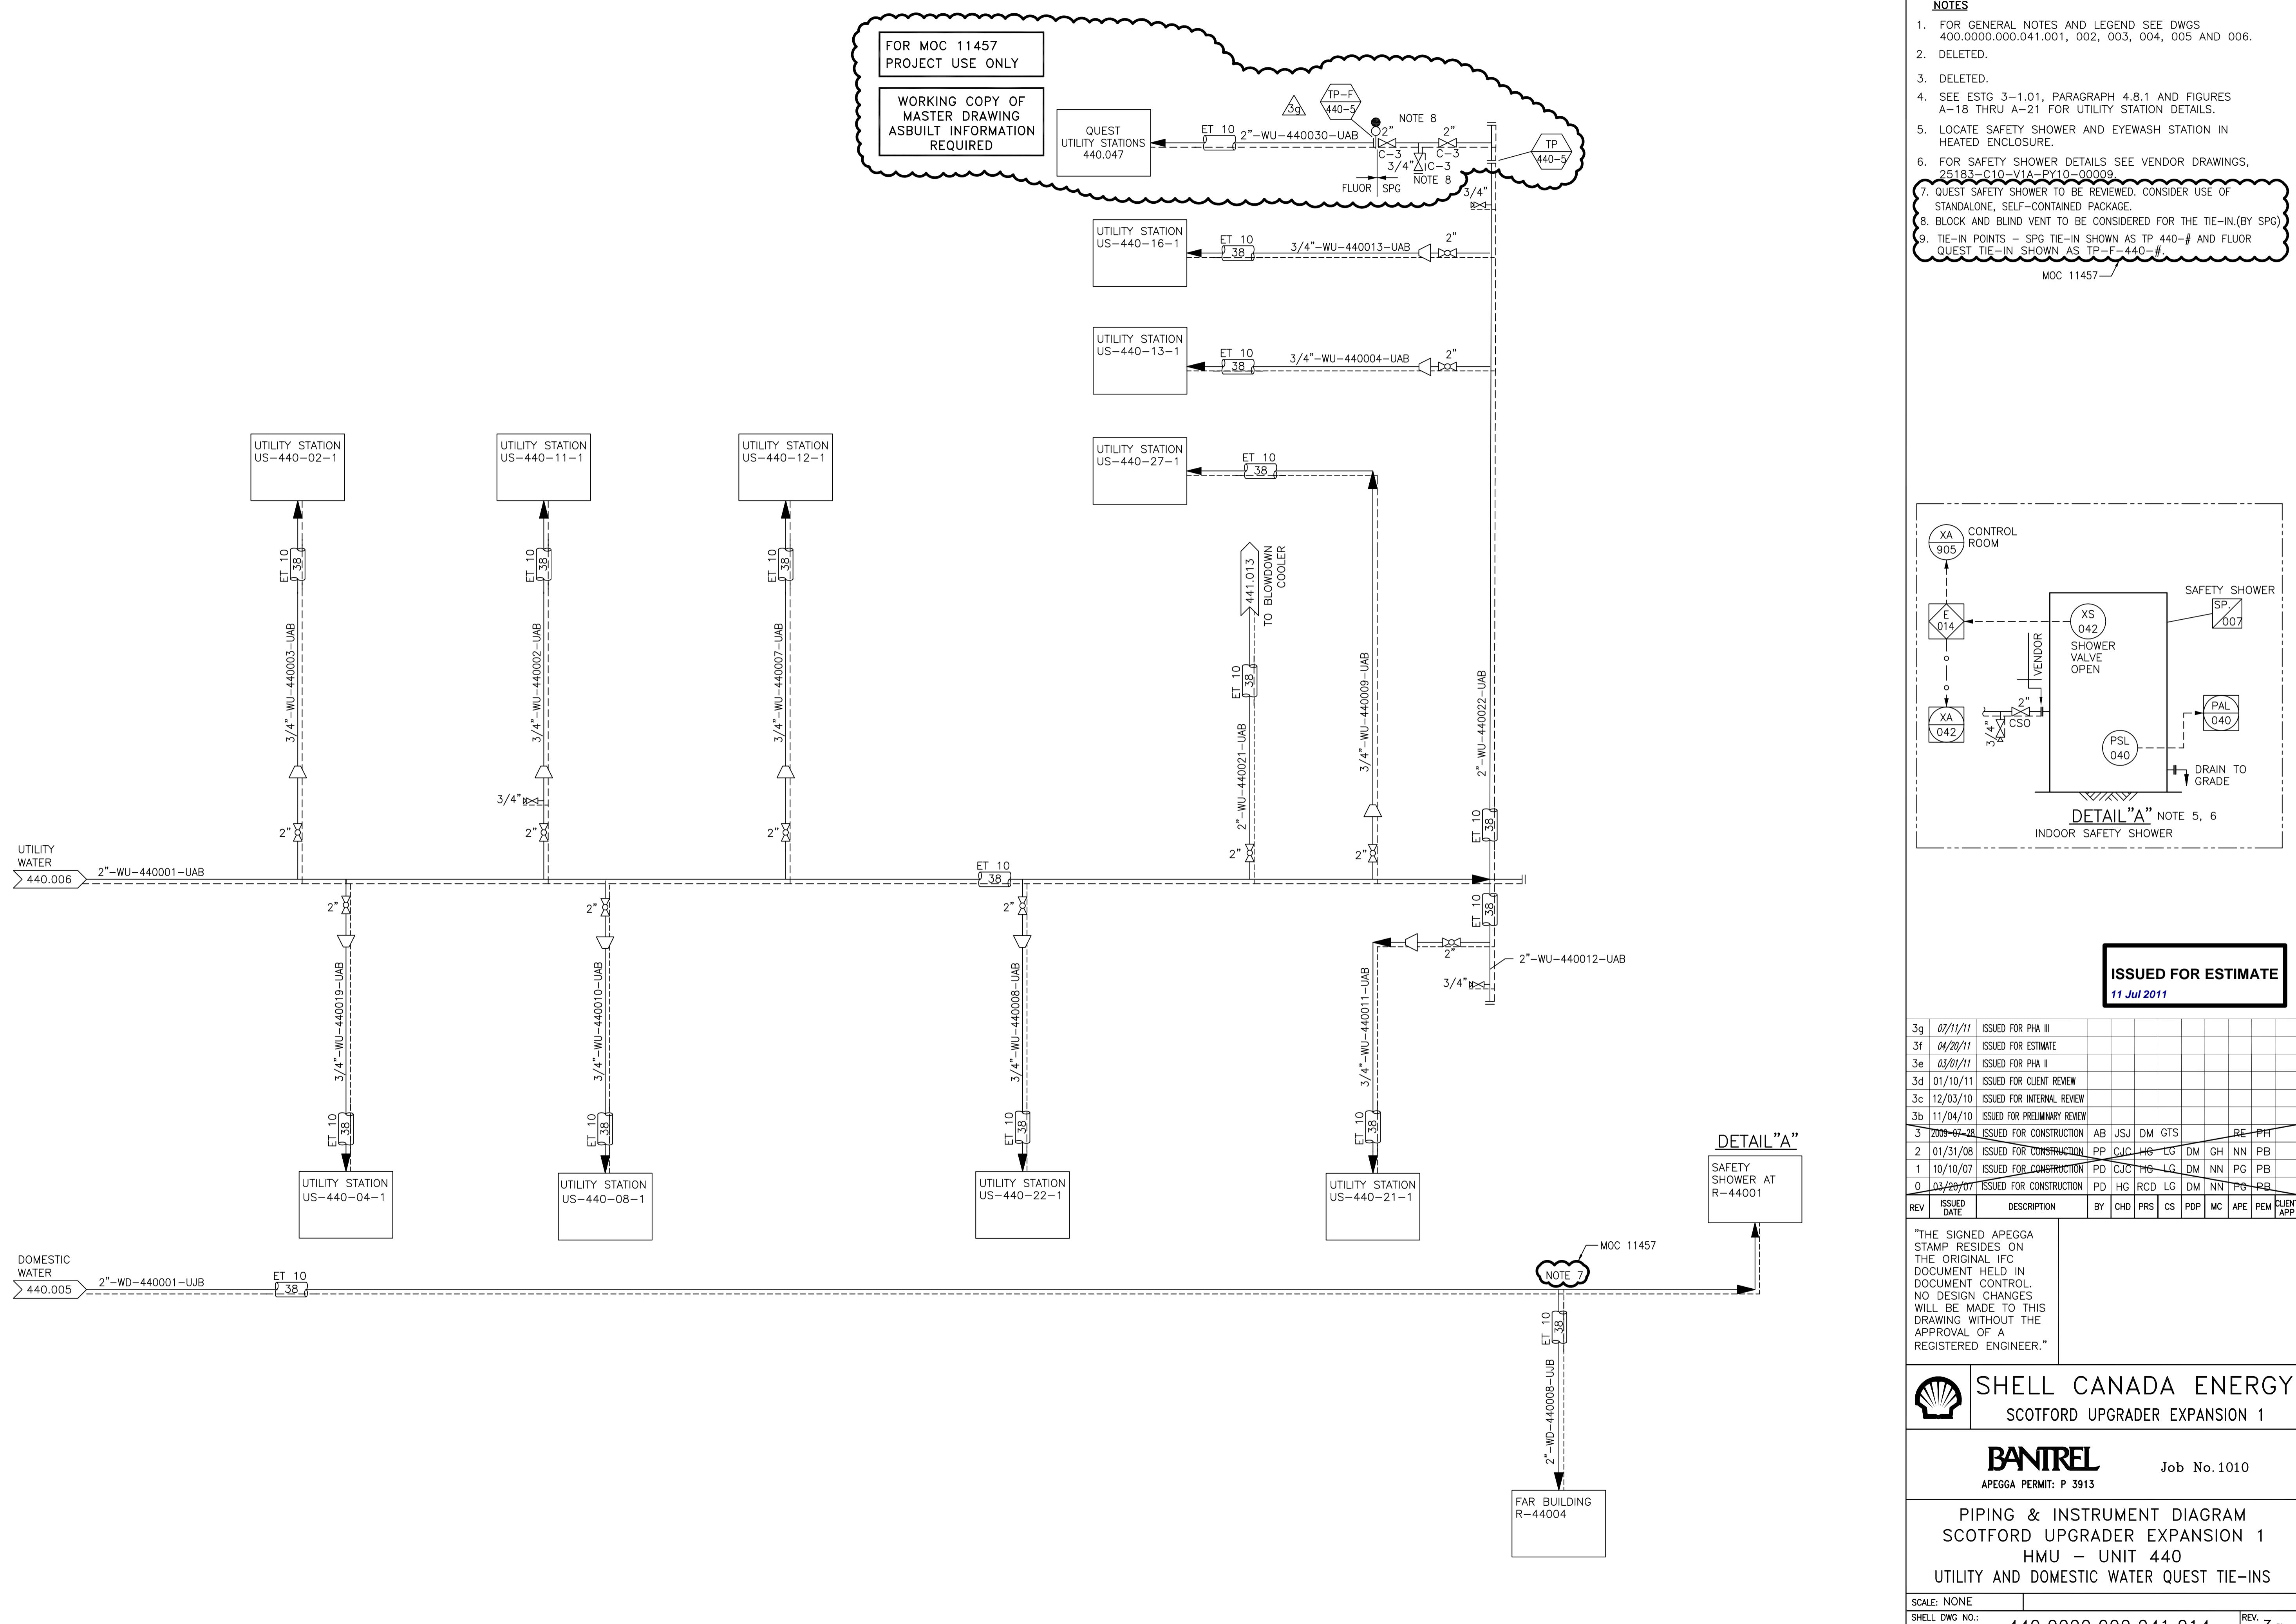

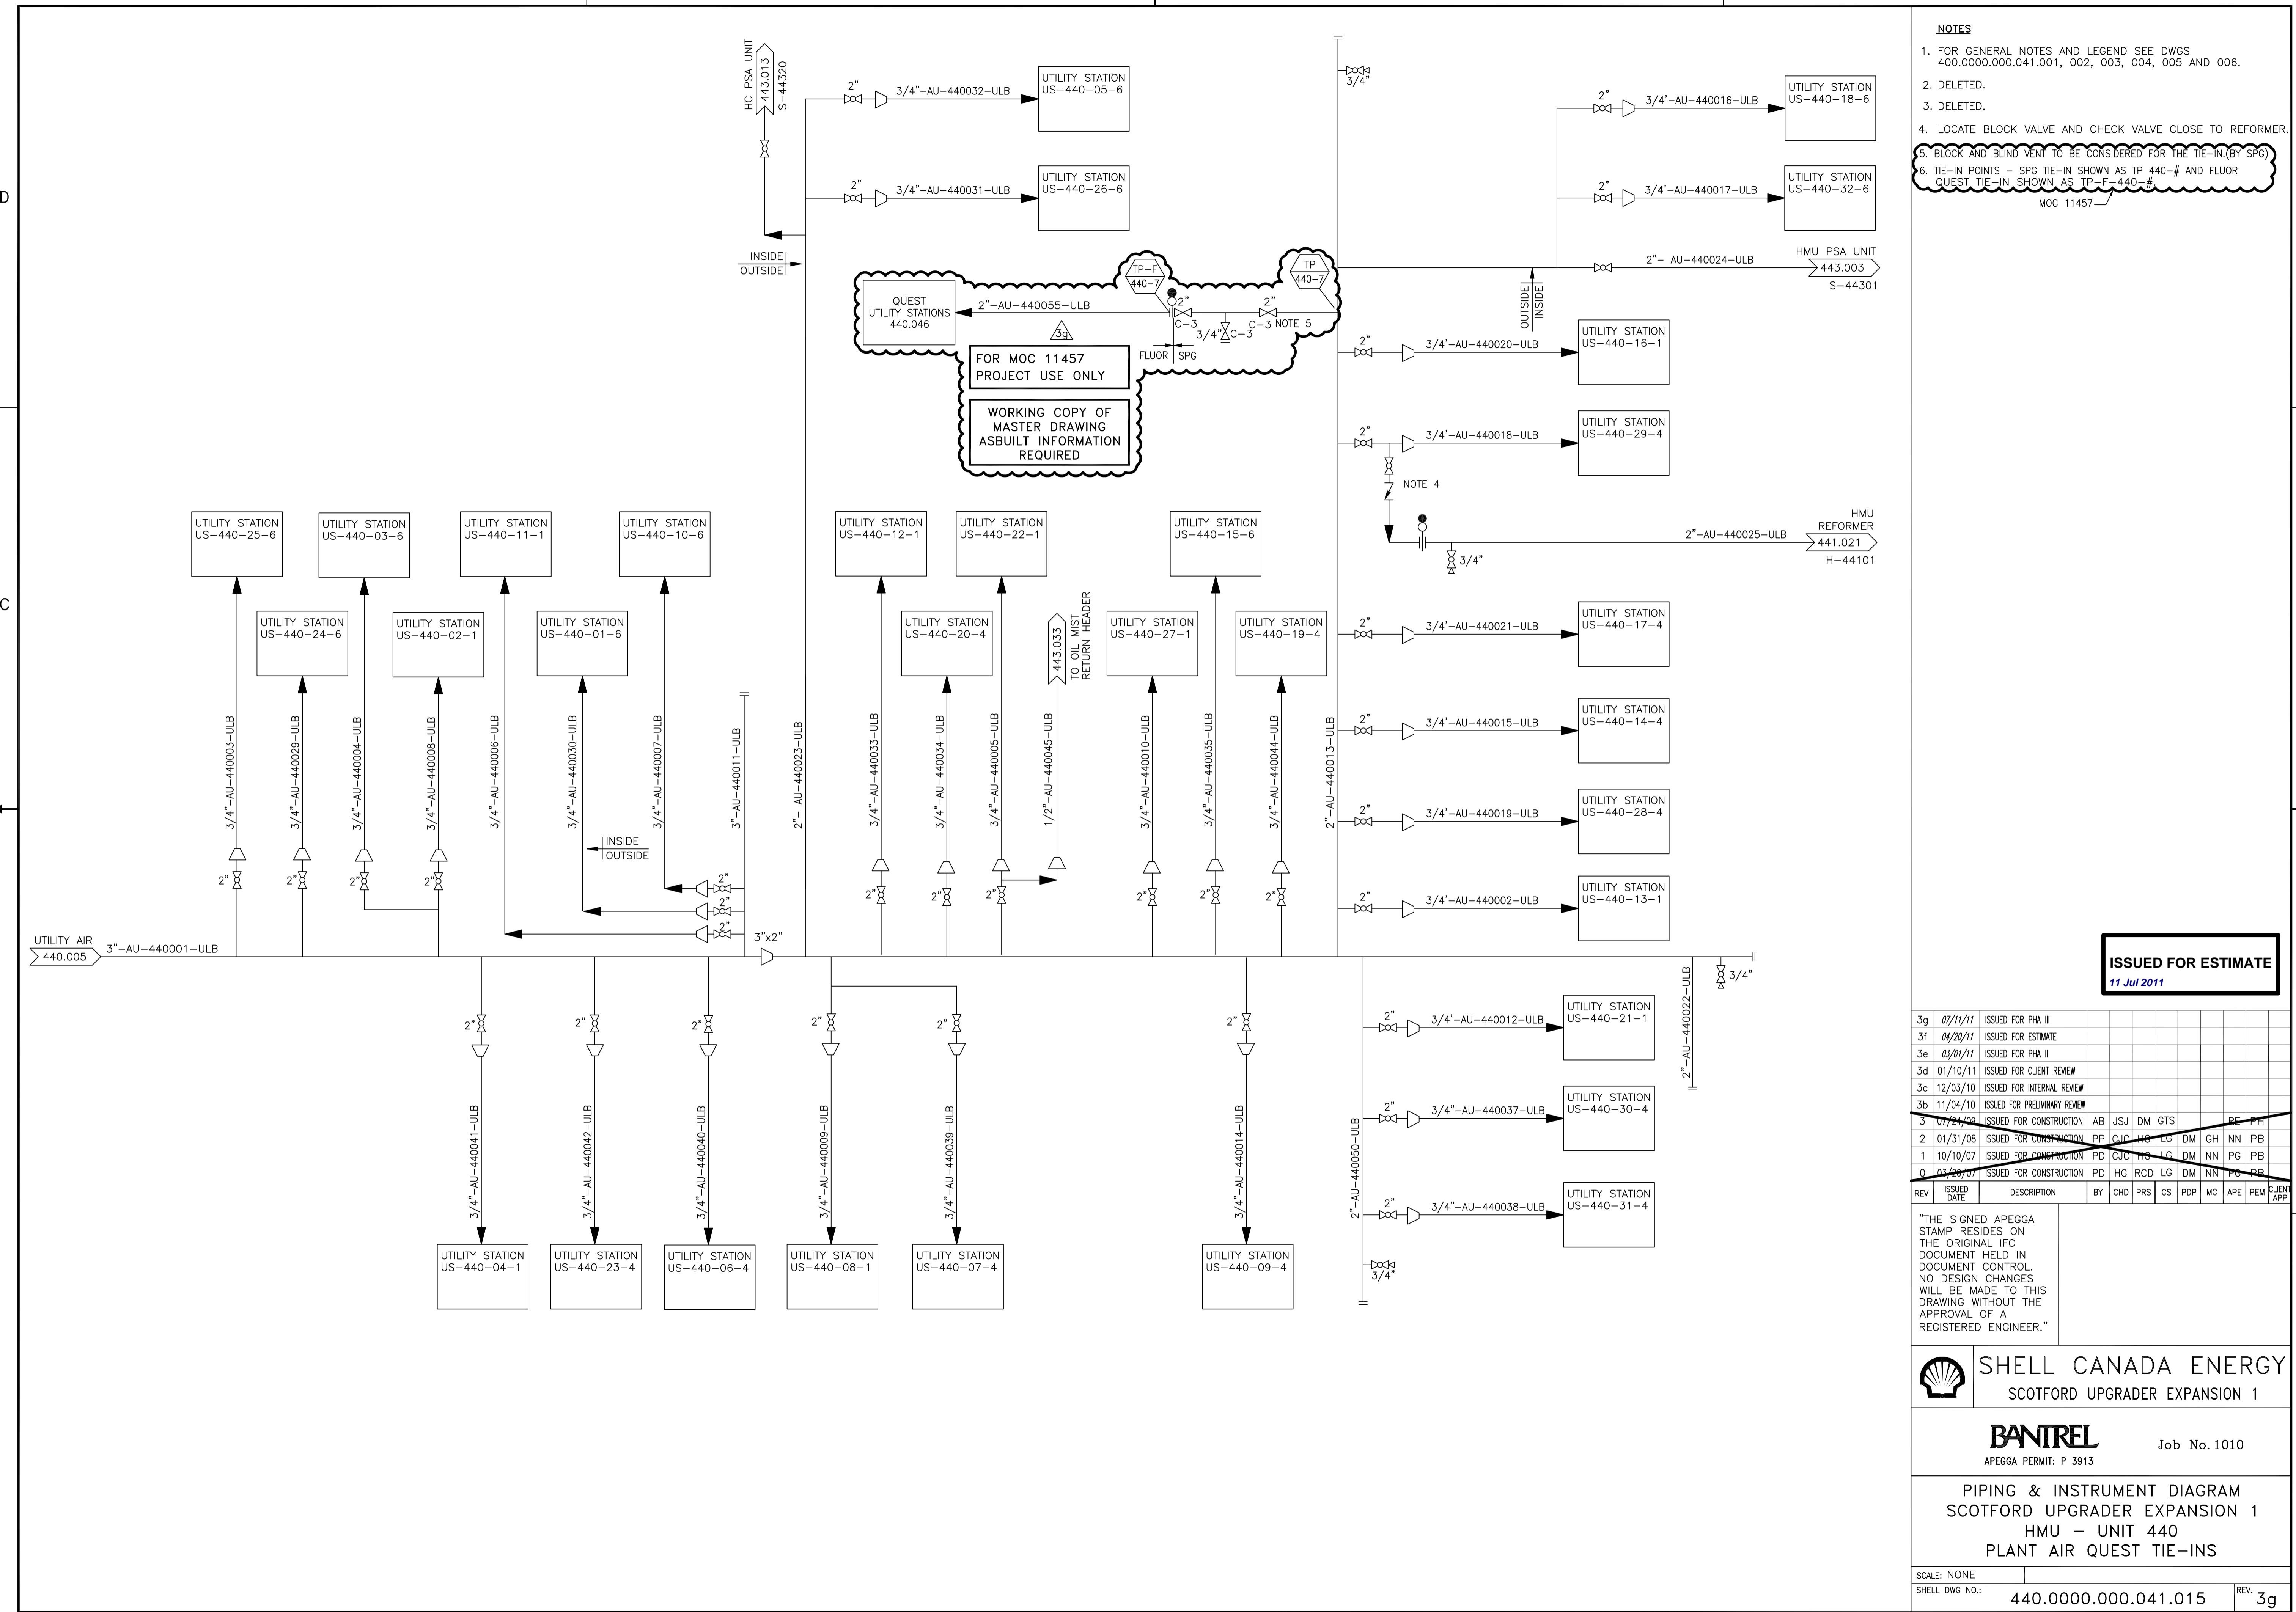

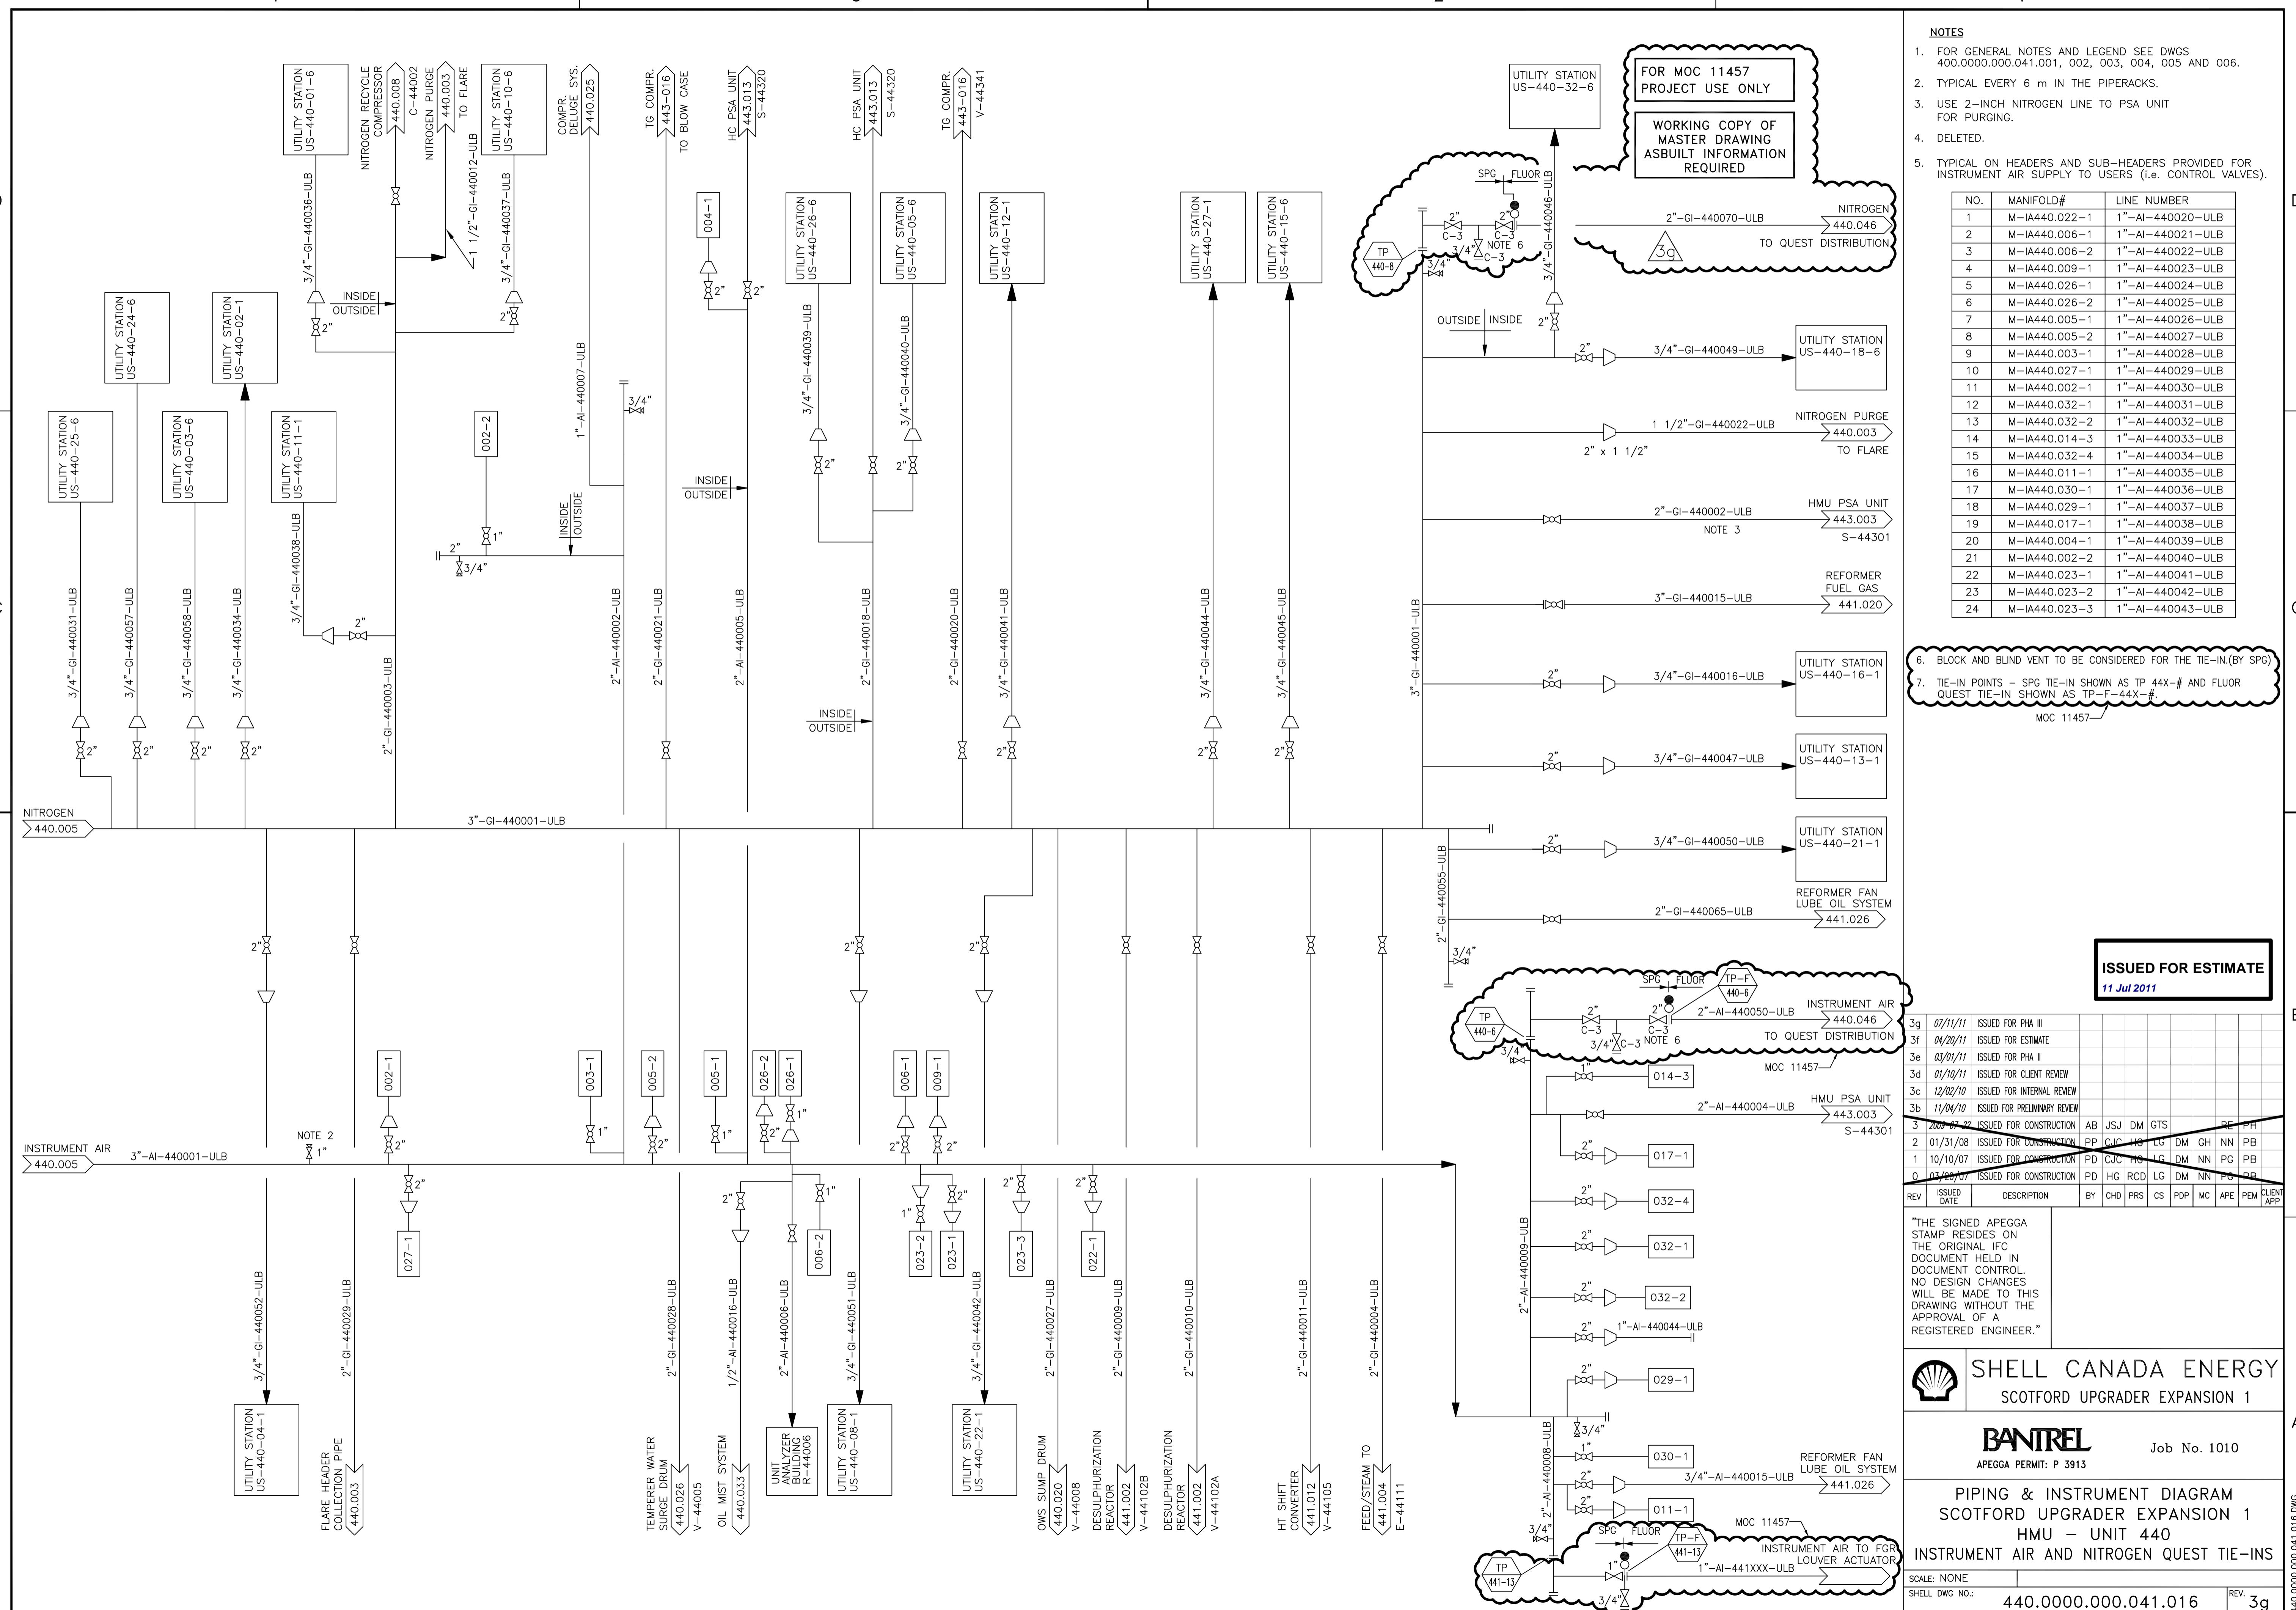


BUILDING NO. R-44001			
ITEM NUMBER	LP STEAM HEADER / BRANCH NO.	LP STEAM LINE FROM	CONDENSATE HEADER NO.
SUB-HEADER 1	4"-SL-440078-SAB	-	2"-SCL-440079-SAB
SUB-HEADER 2	3"-SL-440014-SAB	-	2"-SCL-440006-SAB
E-44010 A	2"-SL-440014-SAB	1 1/2"-SL-440082-SAB	2"-SCL-440006-SAB
E-44010 B	2"-SL-440014-SAB	1 1/2"-SL-440083-SAB	2"-SCL-440006-SAB
E-44010 C	2"-SL-440014-SAB	1 1/2"-SL-440084-SAB	2"-SCL-440006-SAB
E-44010 D	2"-SL-440014-SAB	1 1/2"-SL-440085-SAB	2"-SCL-440006-SAB
E-44010 E	2"-SL-440078-SAB	1 1/2"-SL-440086-SAB	2"-SCL-440079-SAB
E-44010 F	2"-SL-440078-SAB	1 1/2"-SL-440087-SAB	2"-SCL-440079-SAB
E-44010 G	2"-SL-440078-SAB	1 1/2"-SL-440088-SAB	2"-SCL-440079-SAB
E-44010 H	2"-SL-440078-SAB	1 1/2"-SL-440089-SAB	2"-SCL-440079-SAB
TV-440181	4"-SL-440093-SAB	1 1/2"-SL-440081-SAB	2"-SCL-440078-SAB


BUILDING NO. R-44302			
ITEM NUMBER	LP STEAM HEADER / BRANCH NO.	LP STEAM LINE FROM	CONDENSATE HEADER NO.
SUB-HEADER	3"-SL-440080-SAB	-	2"-SCL-443006-SAB
E-44308 A	2"-SL-440080-SAB	1 1/2"-SL-443017-SAB	2"-SCL-443006-SAB
E-44308 B	2"-SL-440080-SAB	1 1/2"-SL-443018-SAB	2"-SCL-443006-SAB
E-44308 C	2"-SL-440080-SAB	1 1/2"-SL-443019-SAB	2"-SCL-443006-SAB
E-44308 D	2"-SL-440080-SAB	1 1/2"-SL-443020-SAB	2"-SCL-443006-SAB
E-44308 E	2"-SL-440080-SAB	1 1/2"-SL-443021-SAB	2"-SCL-443006-SAB
E-44308 F	2"-SL-440080-SAB	1 1/2"-SL-443022-SAB	2"-SCL-443006-SAB
E-44308 G	2"-SL-440080-SAB	1 1/2"-SL-443023-SAB	2"-SCL-443006-SAB
E-44308 H	2"-SL-440080-SAB	1 1/2"-SL-443024-SAB	2"-SCL-443006-SAB
TV-443281	3"-SL-440080-SAB	2"-SL-443016-SAB	2"-SCL-443005-SAB


NOTE 11


BUILDING NO. R-44301			
ITEM NUMBER	LP STEAM HEADER / BRANCH NO.	LP STEAM LINE FROM	CONDENSATE HEADER NO.
SUB-HEADER	4"-SL-440079-SAB	-	3"-SCL-443004-SAB
E-44307 A	2"-SL-440079-SAB	1 1/2"-SL-443002-SAB	2"-SCL-443004-SAB
E-44307 B	2"-SL-440079-SAB	1 1/2"-SL-443003-SAB	2"-SCL-443004-SAB
E-44307 C	2"-SL-440079-SAB	1 1/2"-SL-443004-SAB	2"-SCL-443004-SAB
E-44307 D	2"-SL-440079-SAB	1 1/2"-SL-443005-SAB	2"-SCL-443004-SAB
E-44307 E	2"-SL-440079-SAB	1 1/2"-SL-443006-SAB	2"-SCL-443004-SAB
E-44307 F	2"-SL-440079-SAB	1 1/2"-SL-443007-SAB	2"-SCL-443004-SAB
E-44307 G	2"-SL-440079-SAB	1 1/2"-SL-443008-SAB	2"-SCL-443004-SAB
E-44307 H	2"-SL-440079-SAB	1 1/2"-SL-443009-SAB	2"-SCL-443004-SAB
E-44307 I	2"-SL-440079-SAB	1 1/2"-SL-443010-SAB	2"-SCL-443004-SAB
E-44307 J	2"-SL-440079-SAB	1 1/2"-SL-443011-SAB	2"-SCL-443004-SAB
E-44307 K	2"-SL-440079-SAB	1 1/2"-SL-443012-SAB	2"-SCL-443004-SAB
E-44307 L	2"-SL-440079-SAB	1 1/2"-SL-443013-SAB	2"-SCL-443004-SAB
E-44307 M	2"-SL-440079-SAB	1 1/2"-SL-443014-SAB	2"-SCL-443004-SAB
E-44307 N	2"-SL-440079-SAB	1 1/2"-SL-443015-SAB	2"-SCL-443004-SAB
TV-443181	4"-SL-443029-SAB	2"-SL-443001-SAB	2"-SCL-443003-SAB

NOTE 11

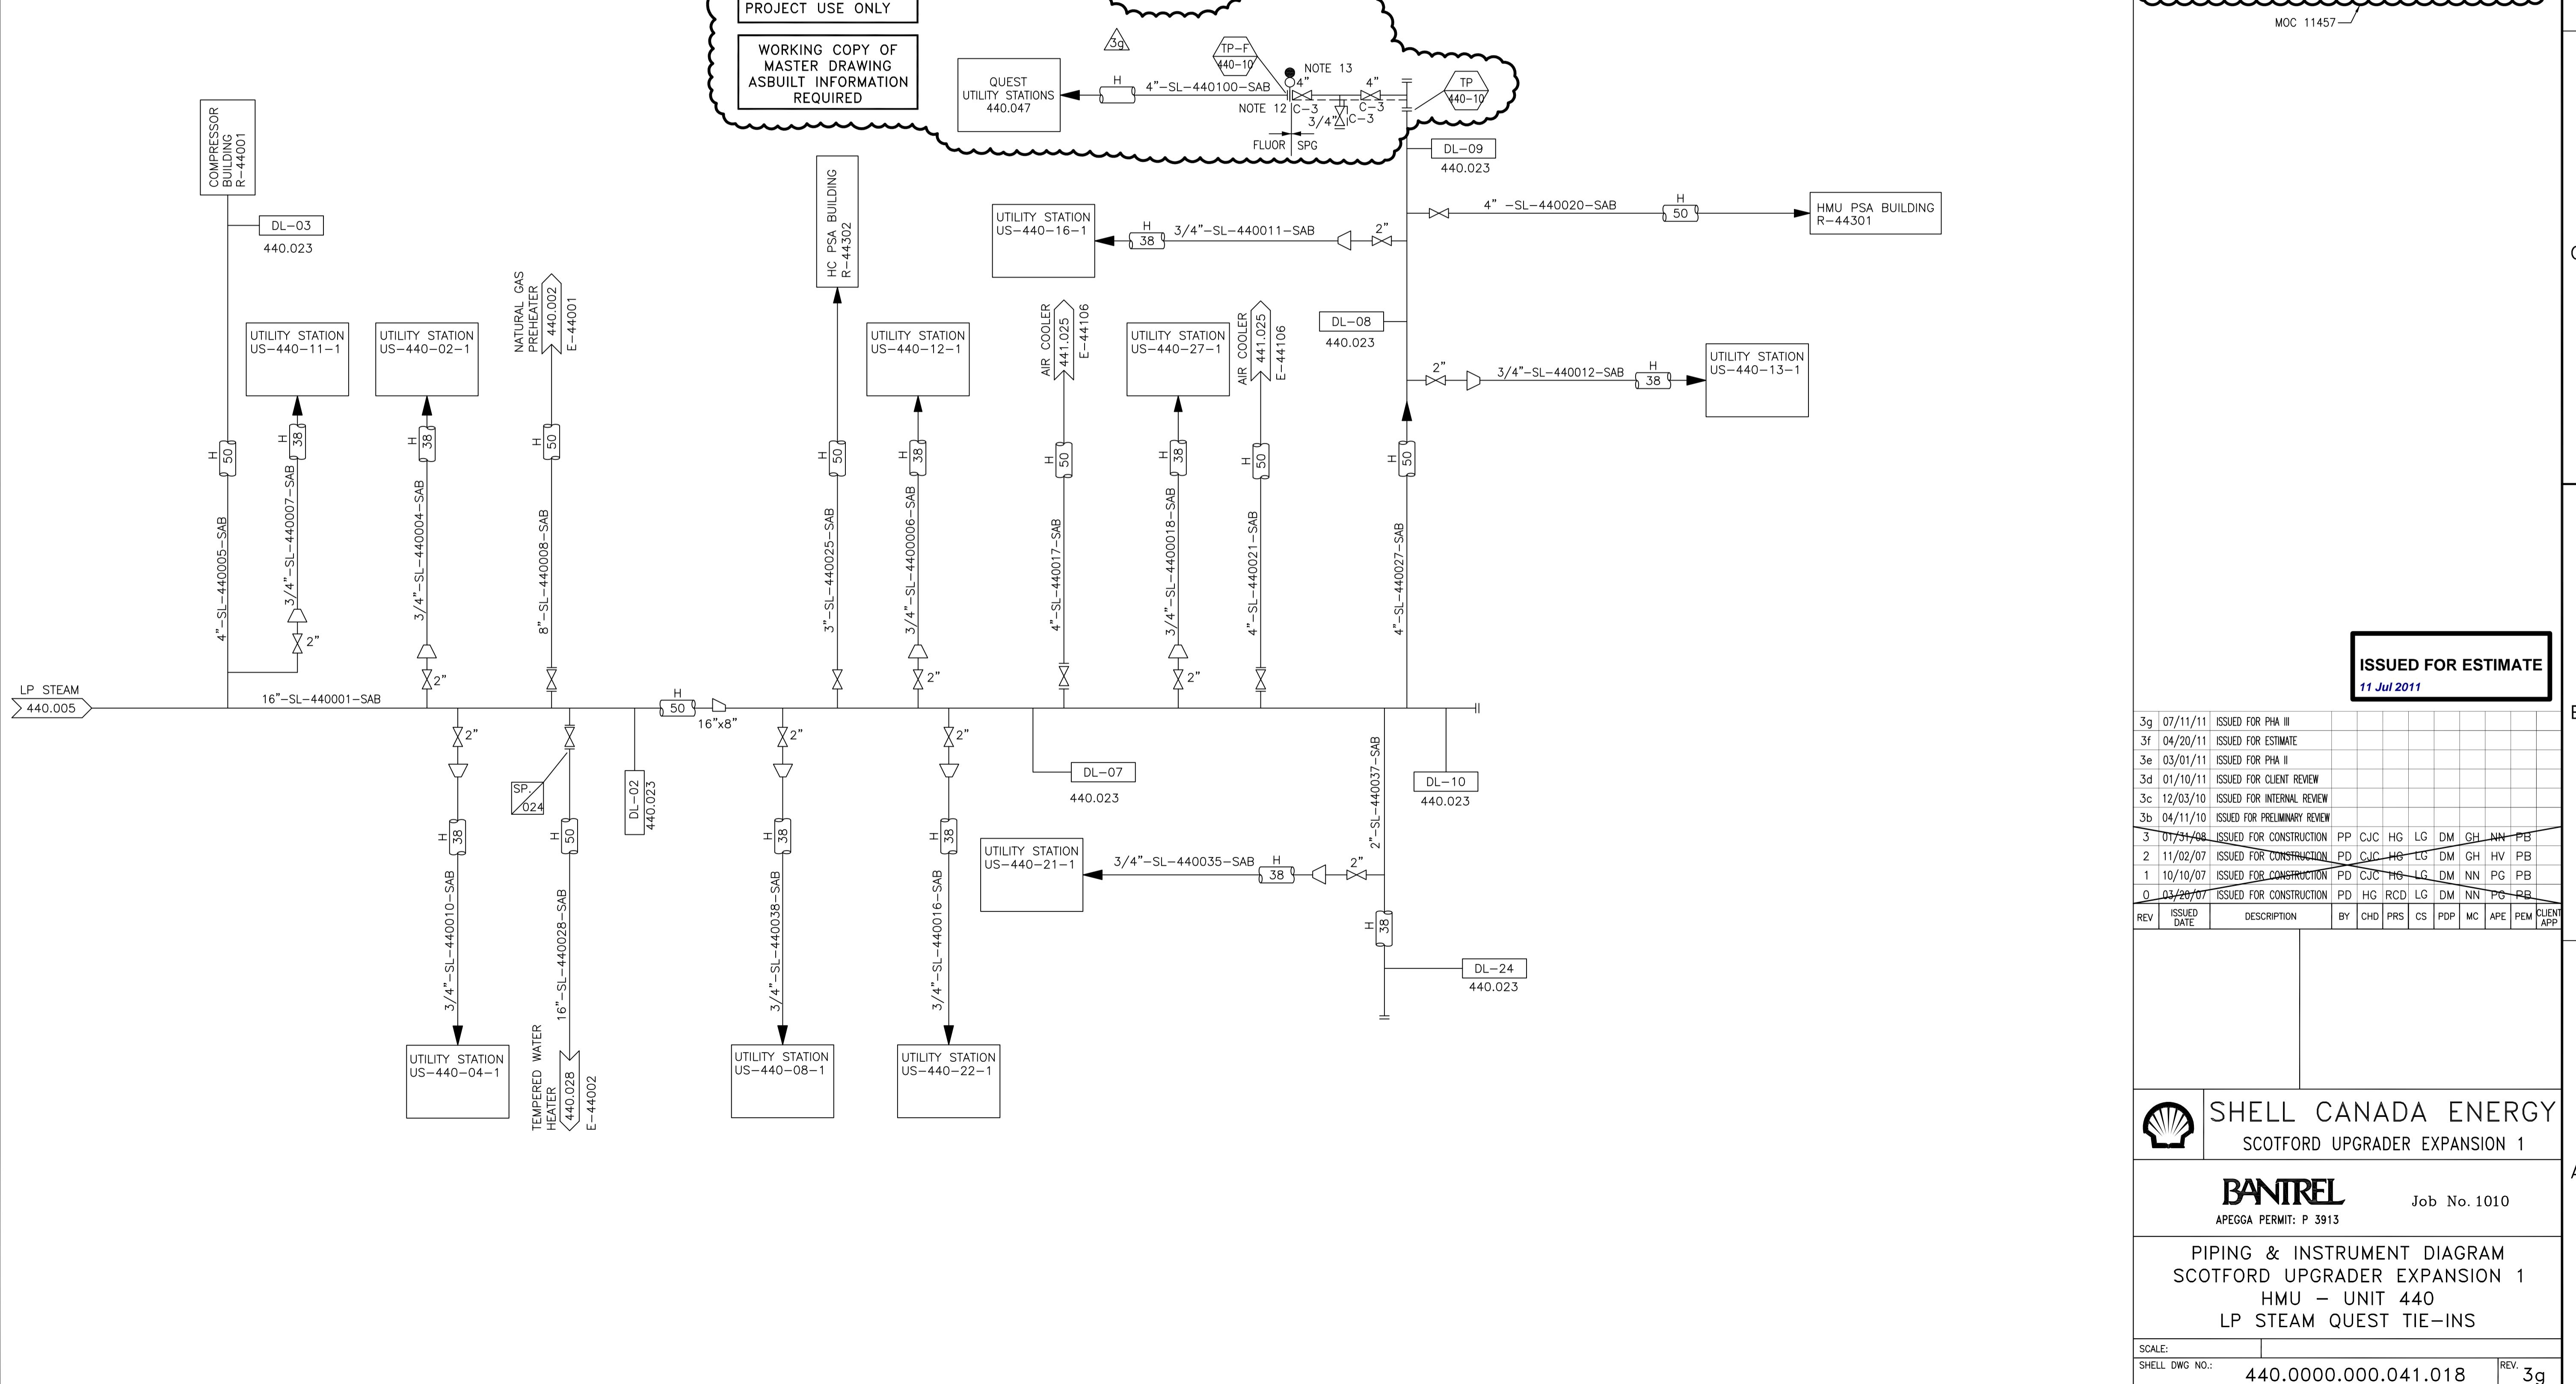


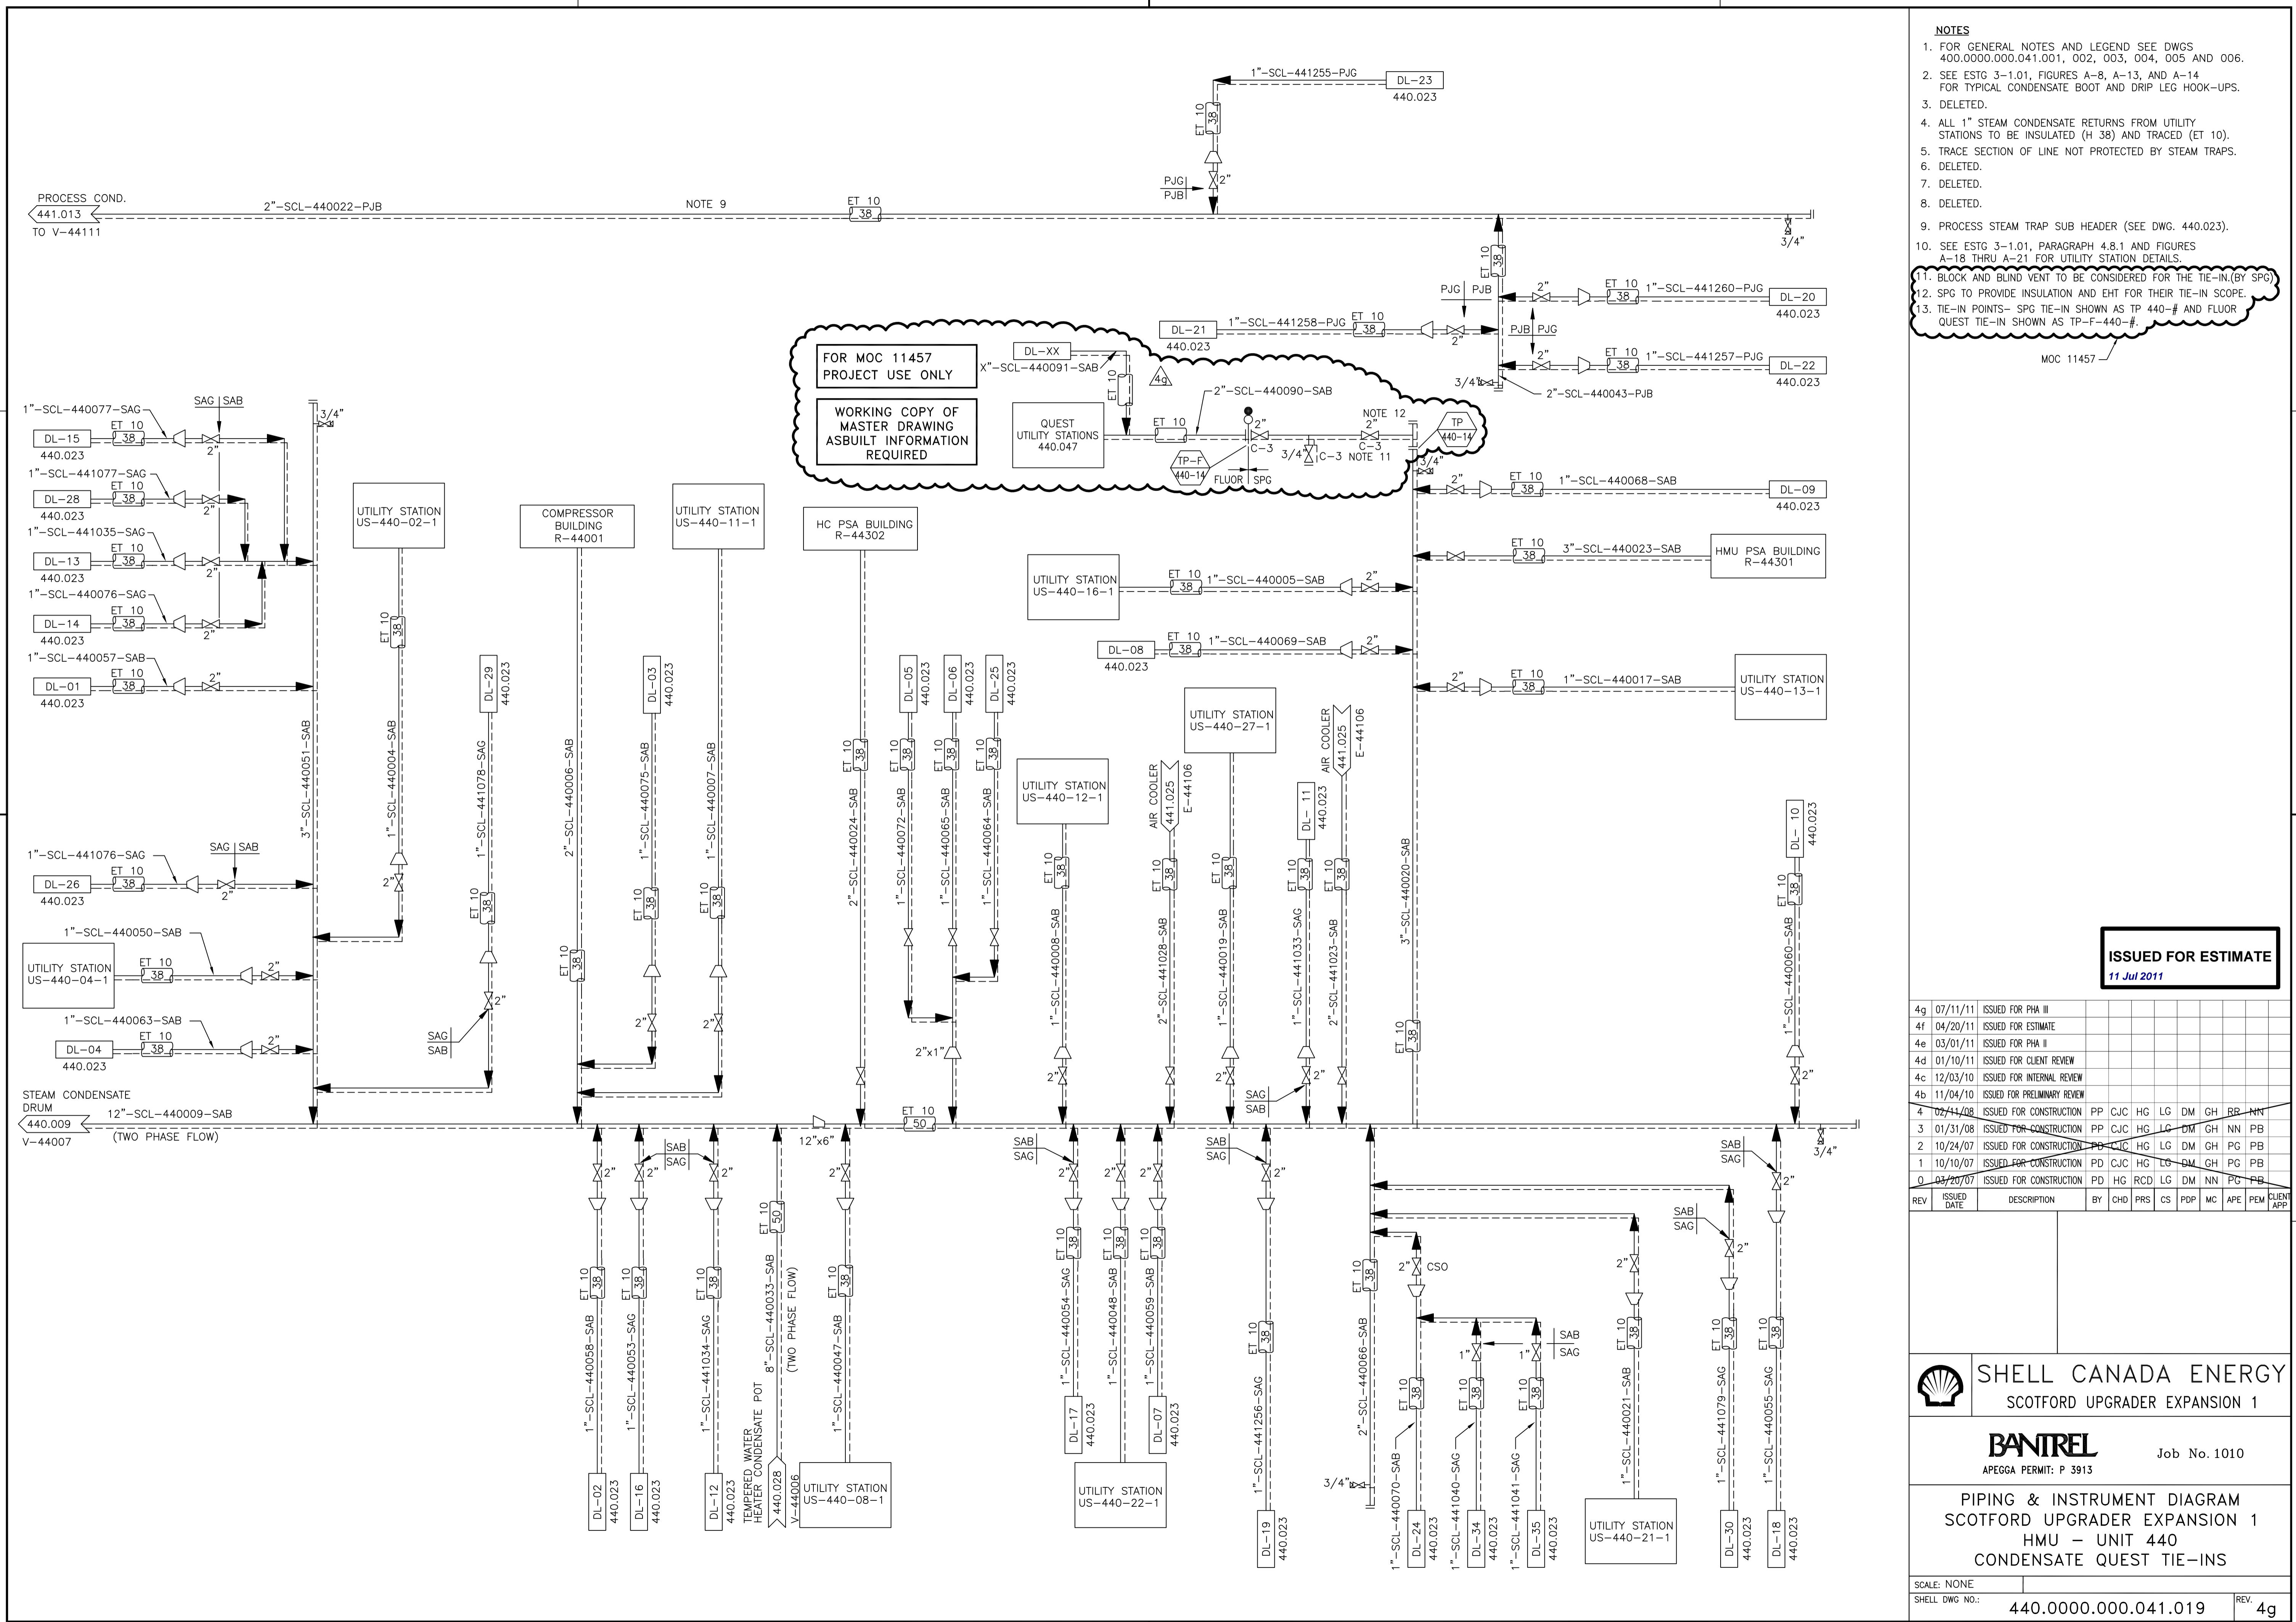

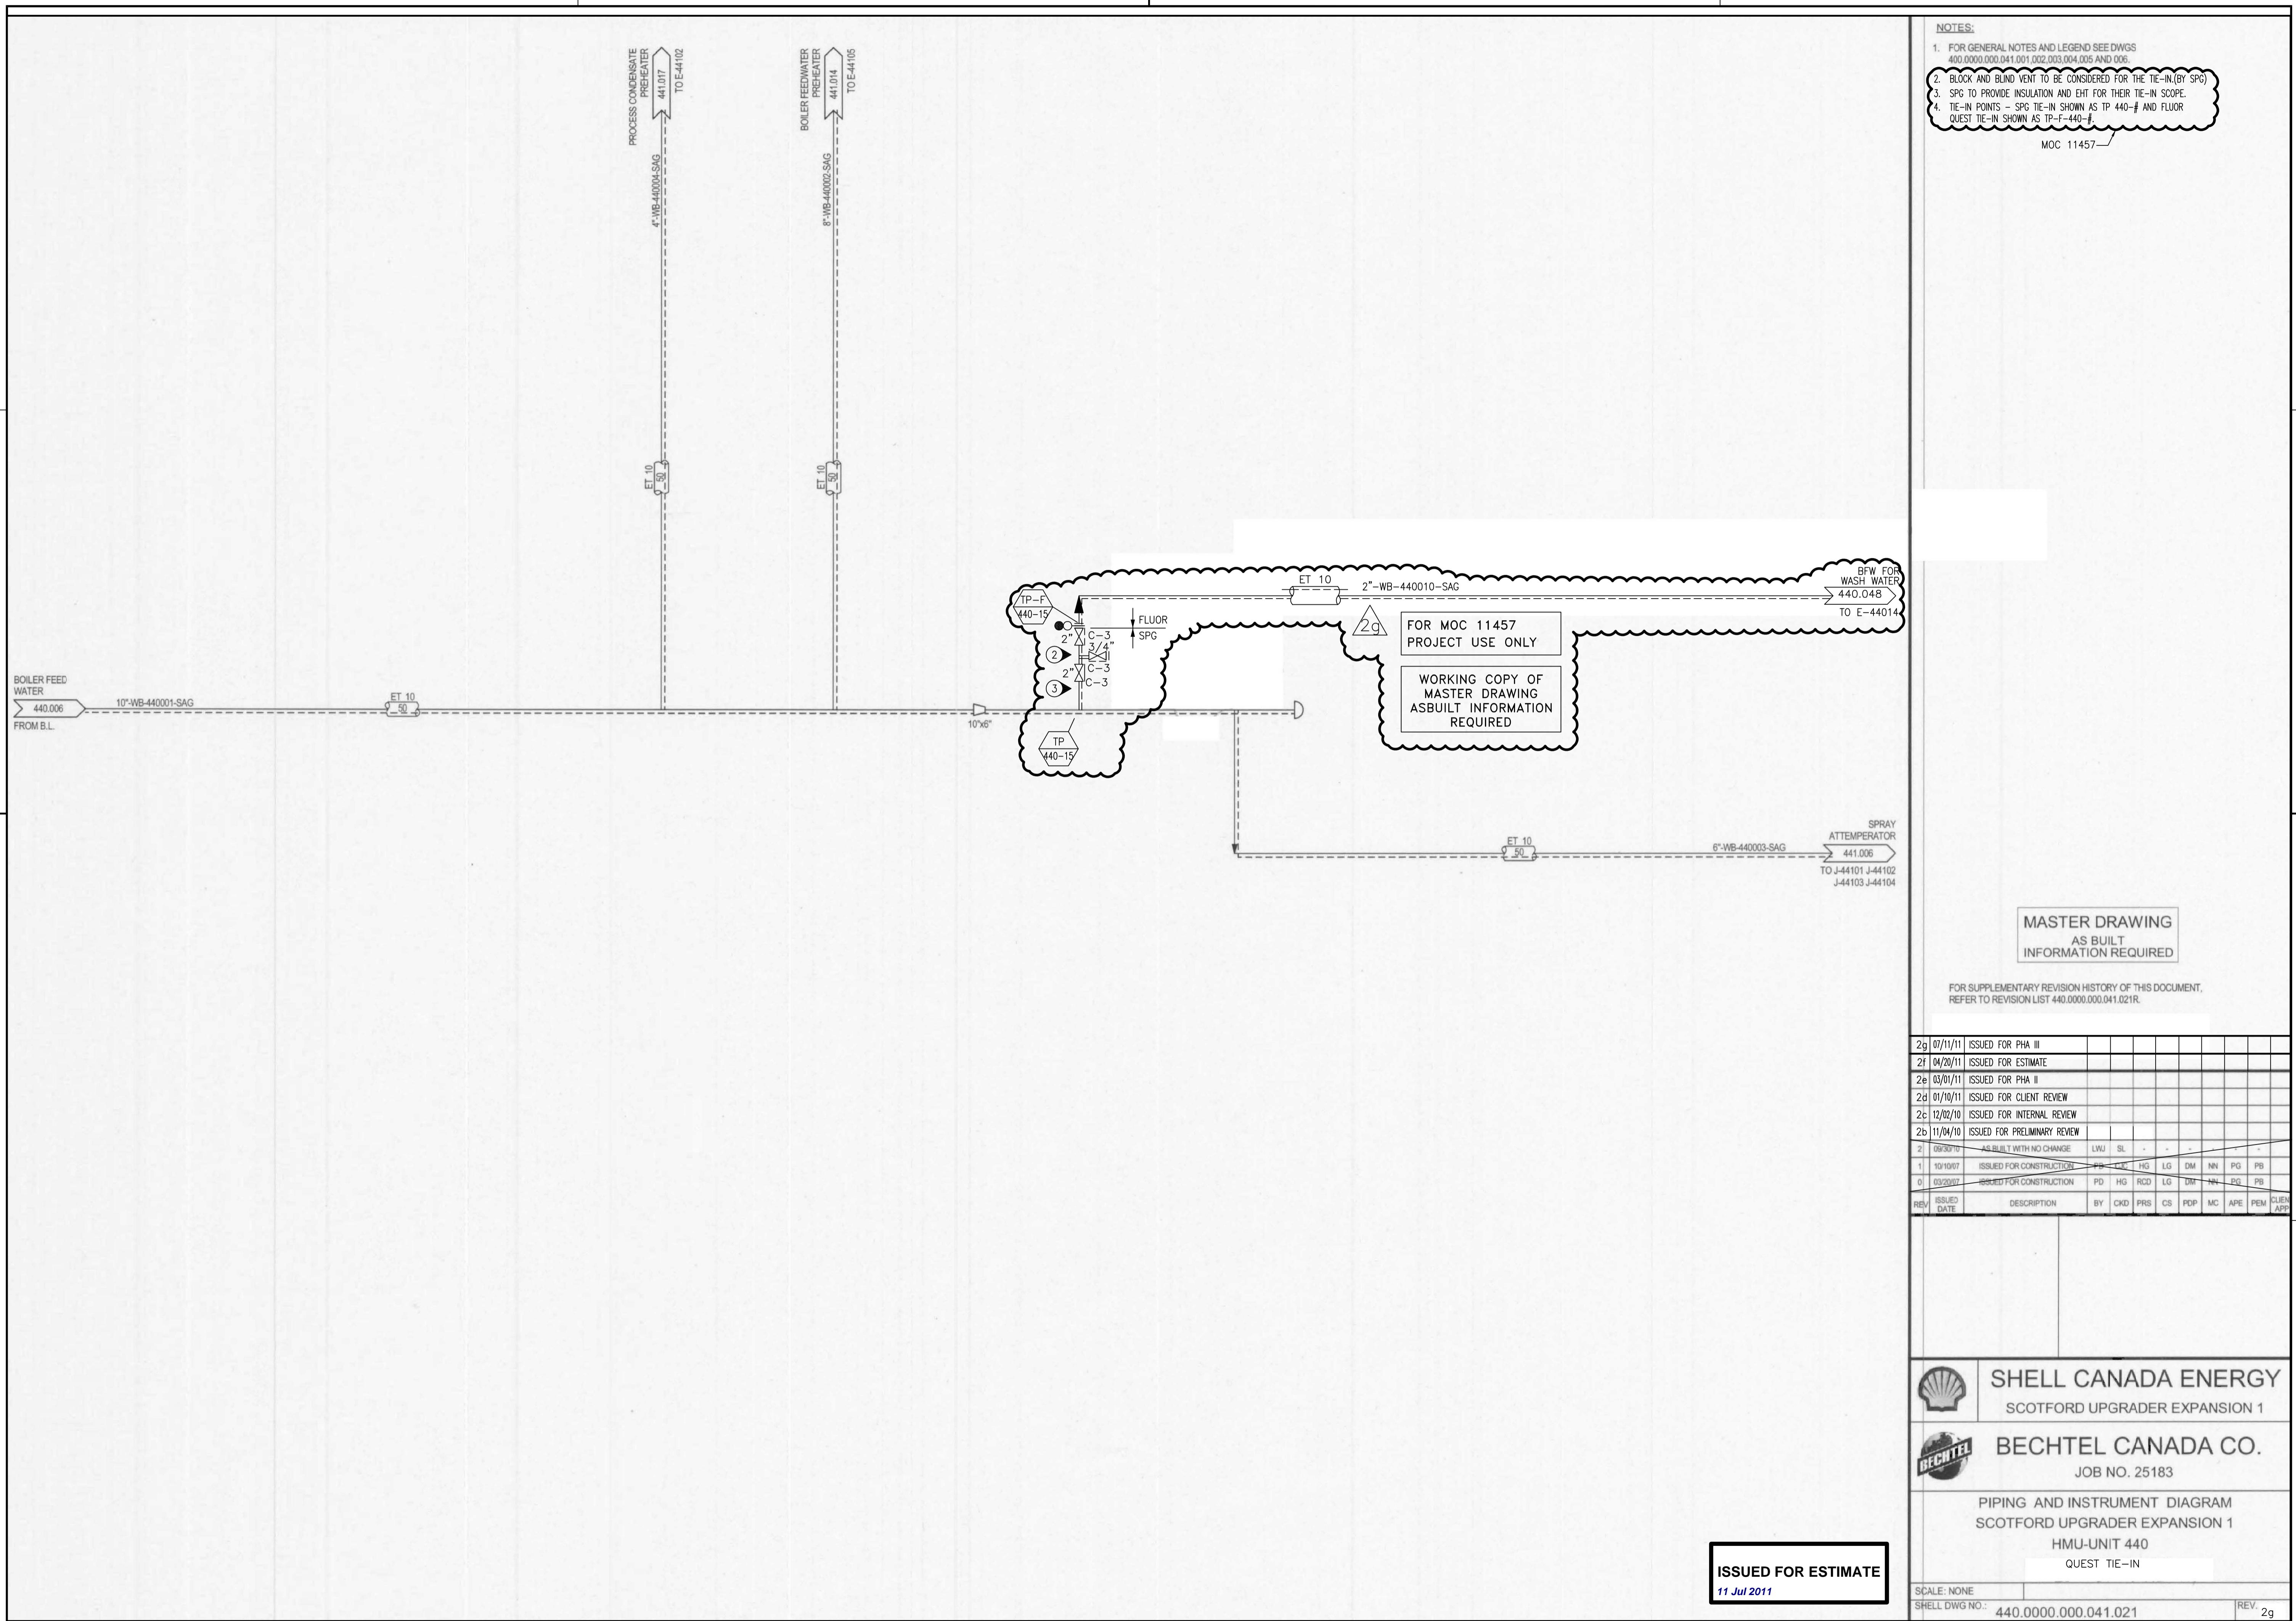

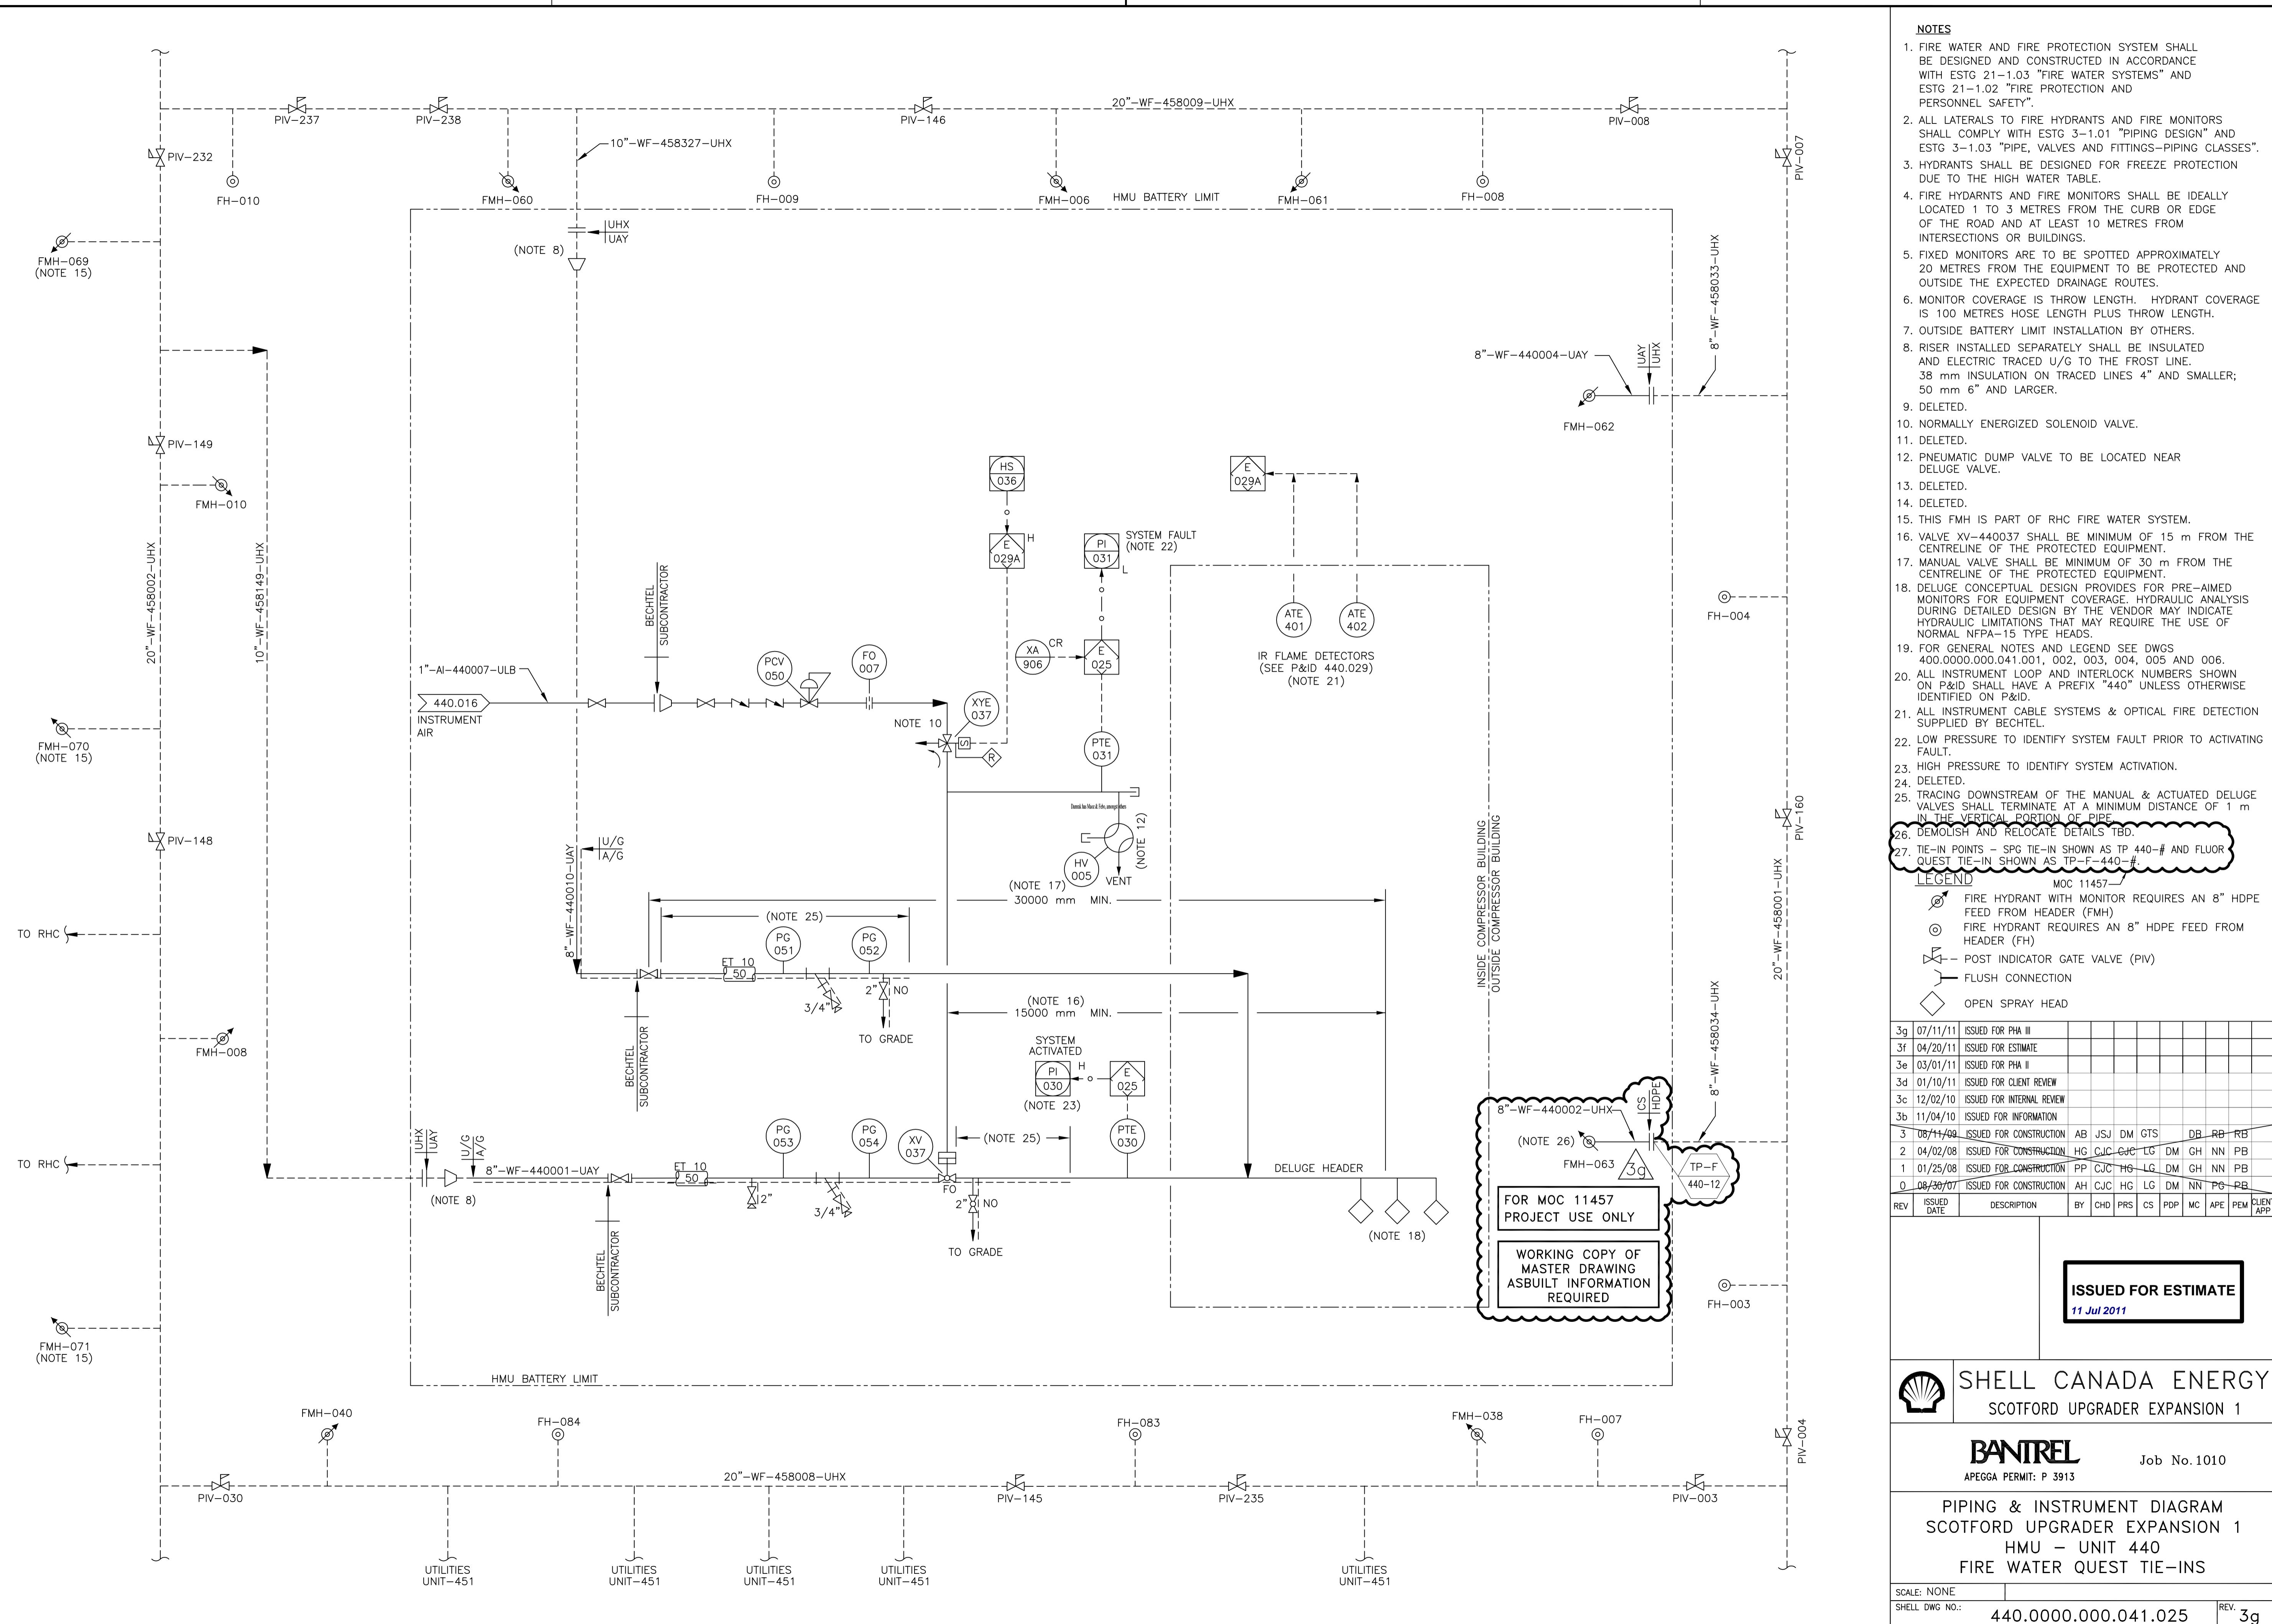

- . SEE DRAWINGS 200.0000.000.041.007 THRU 016 FOR SYMBOL IDENTIFICATION  
GENERAL NOTES & CONNECTION DETAILS.
- . ALL INSTRUMENT TAG NUMBERS ARE PREFIXED BY "440" UNLESS OTHERWISE  
STATED.
- . DEP 31.38.01.11 PIPING DESIGN GENERAL REQUIREMENTS SECTION 5.8 AND  
FIGURE 18-2 TO 18-5 FOR UTILITY STATION DETAILS.
- . PIPING HEADER BRANCH CONNECTIONS SHALL BE MADE ON TOP OF PIPE AND BE  
VALVED.

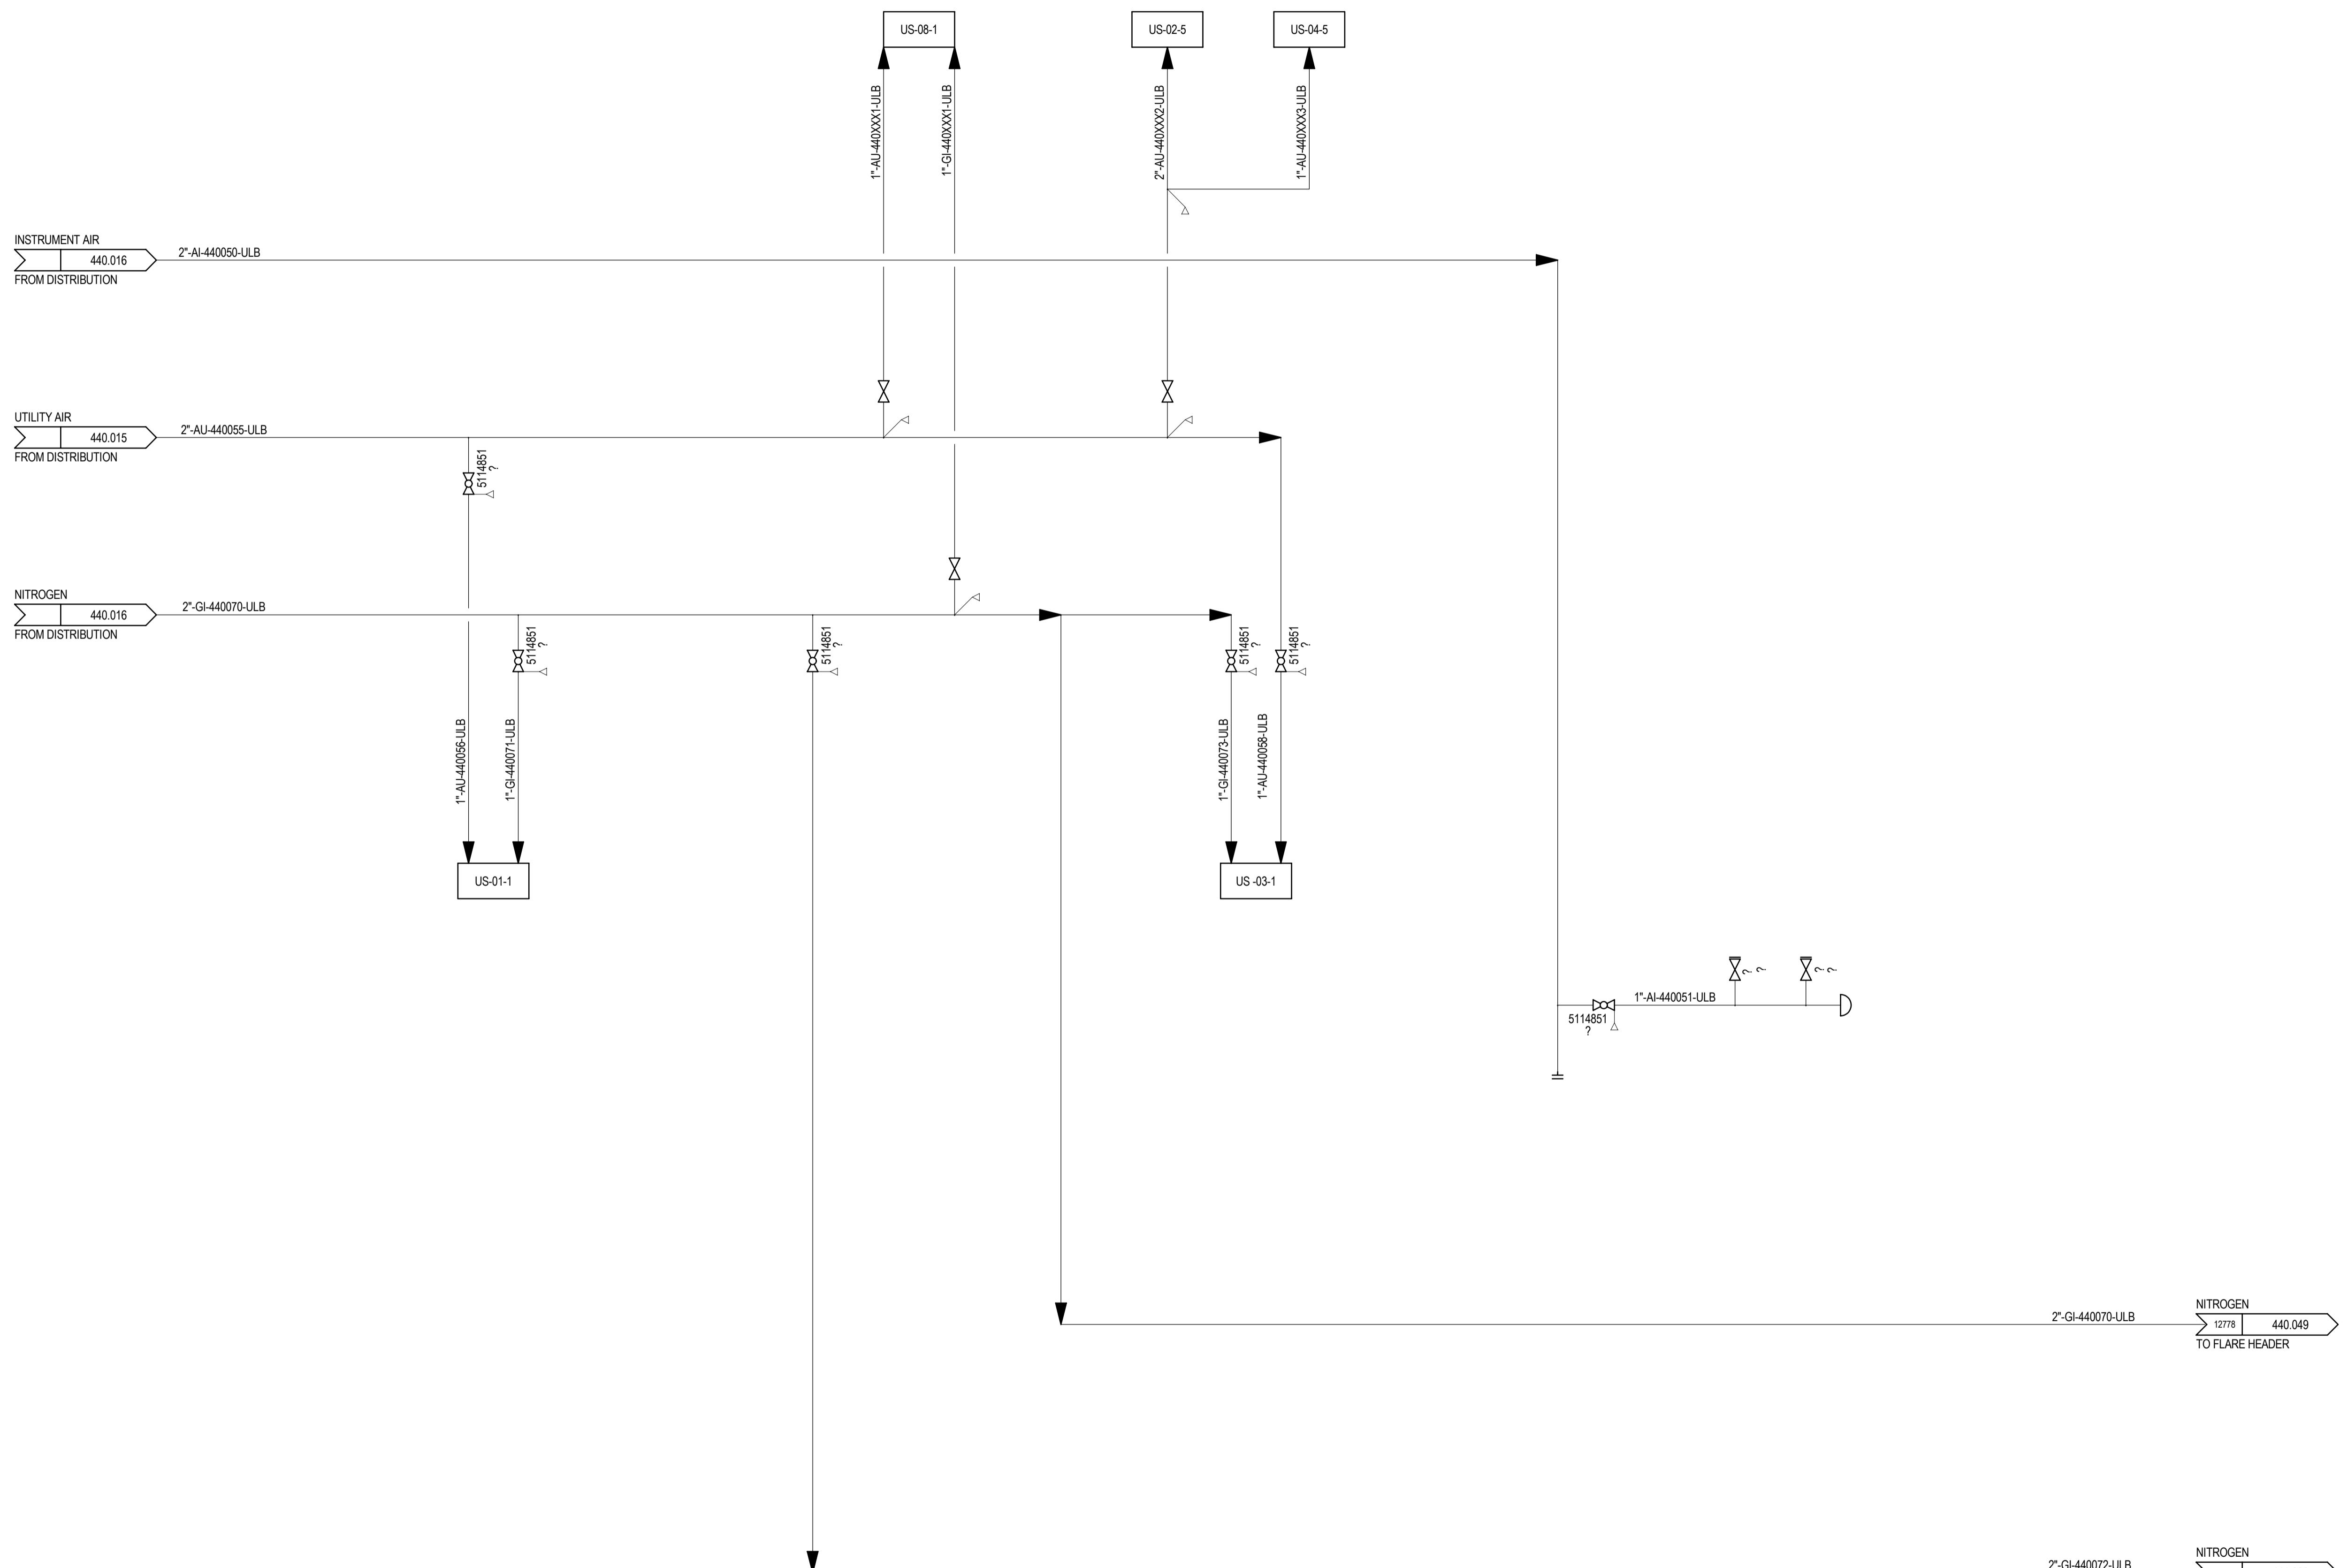

**ISSUED FOR ESTIMATE**

G	07/11/11	ISSUED FOR PHA III									
F	04/20/11	ISSUED FOR ESTIMATE									
E	03/01/11	ISSUED FOR PHA II									
D	01/10/11	ISSUED FOR CLIENT REVIEW									
C	12/02/10	ISSUED FOR INTERNAL REVIEW									
B		ISSUED FOR PRELIMINARY REVIEW									
V	ISSUED	DESCRIPTION	BY	CKD	PRS	CS	PDP	MC	APE	PEM	CLIE




# SHELL CANADA


## QUEST CCS PROJECT


# **FLUOR**


**PIPING AND INSTRUMENT DIAGRAM  
QUEST CCS PROJECT  
UNIT 440 - HYDROGEN MANUFACTURING UNIT  
INST AIR UTILITY AIR AND NITROGEN DISTRIBUTION**


SCALE: NONE		
SHELL DWG NO.:	440.0000.000.041.046	REV. G

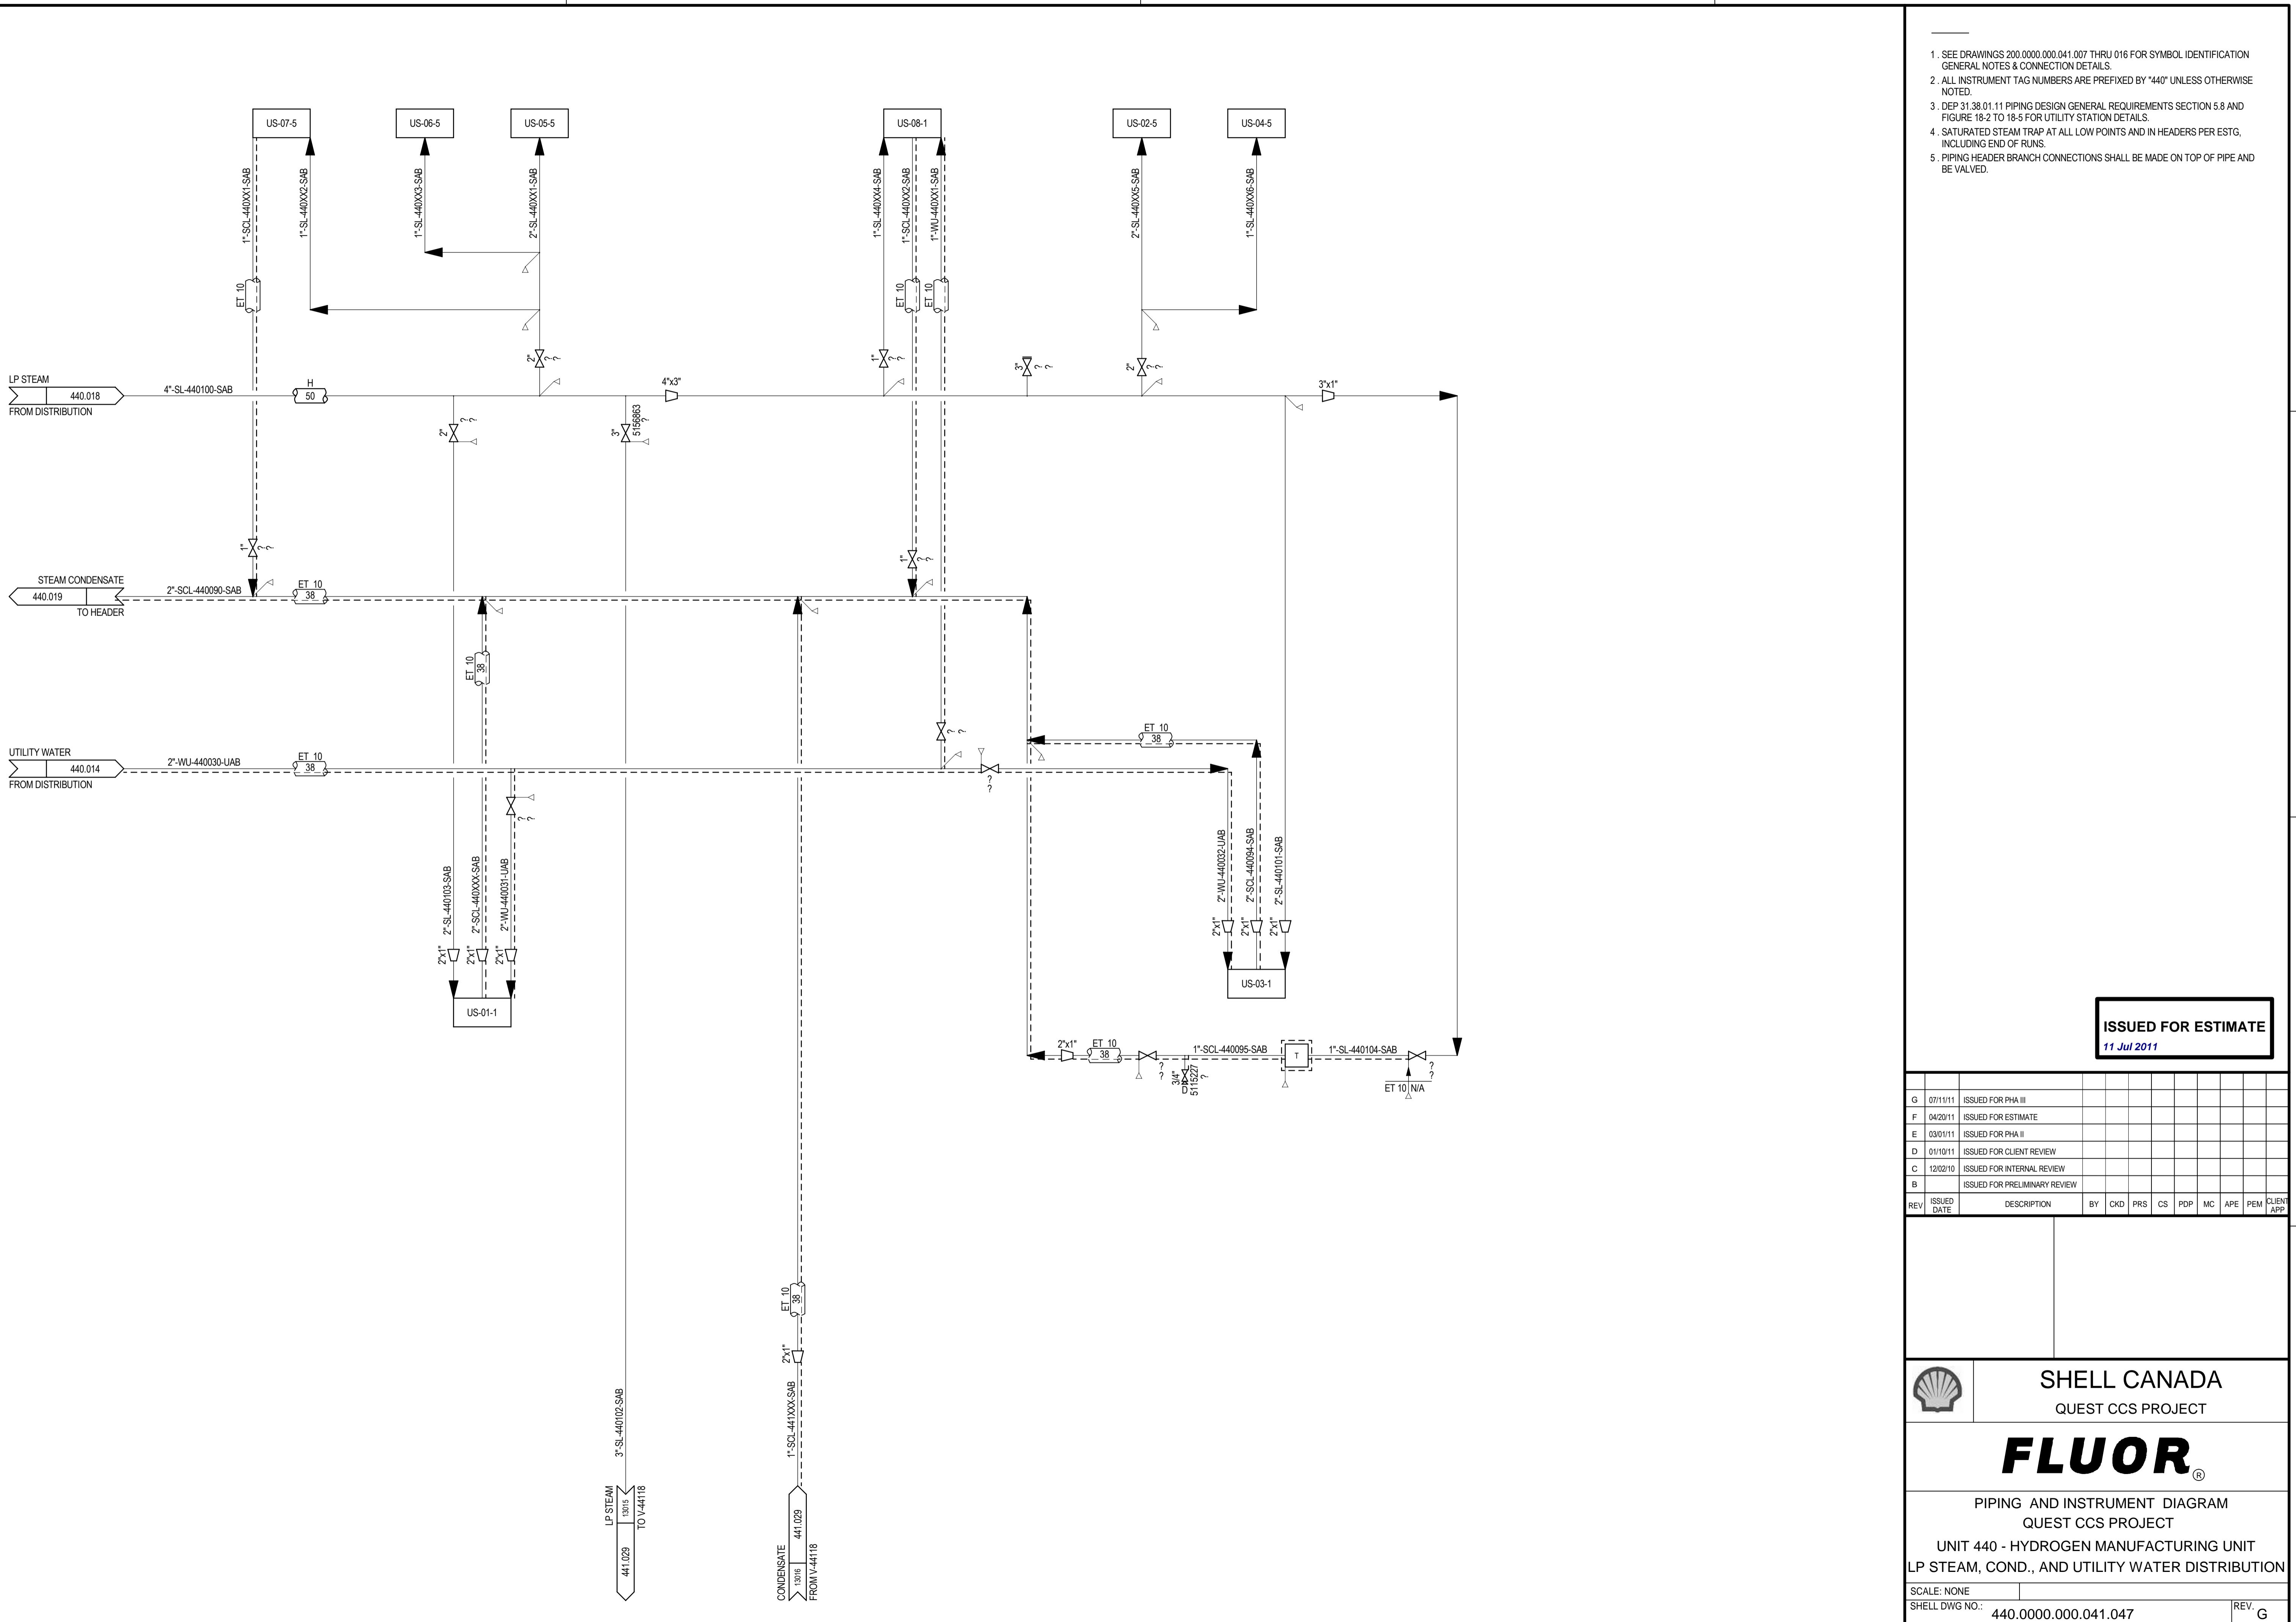


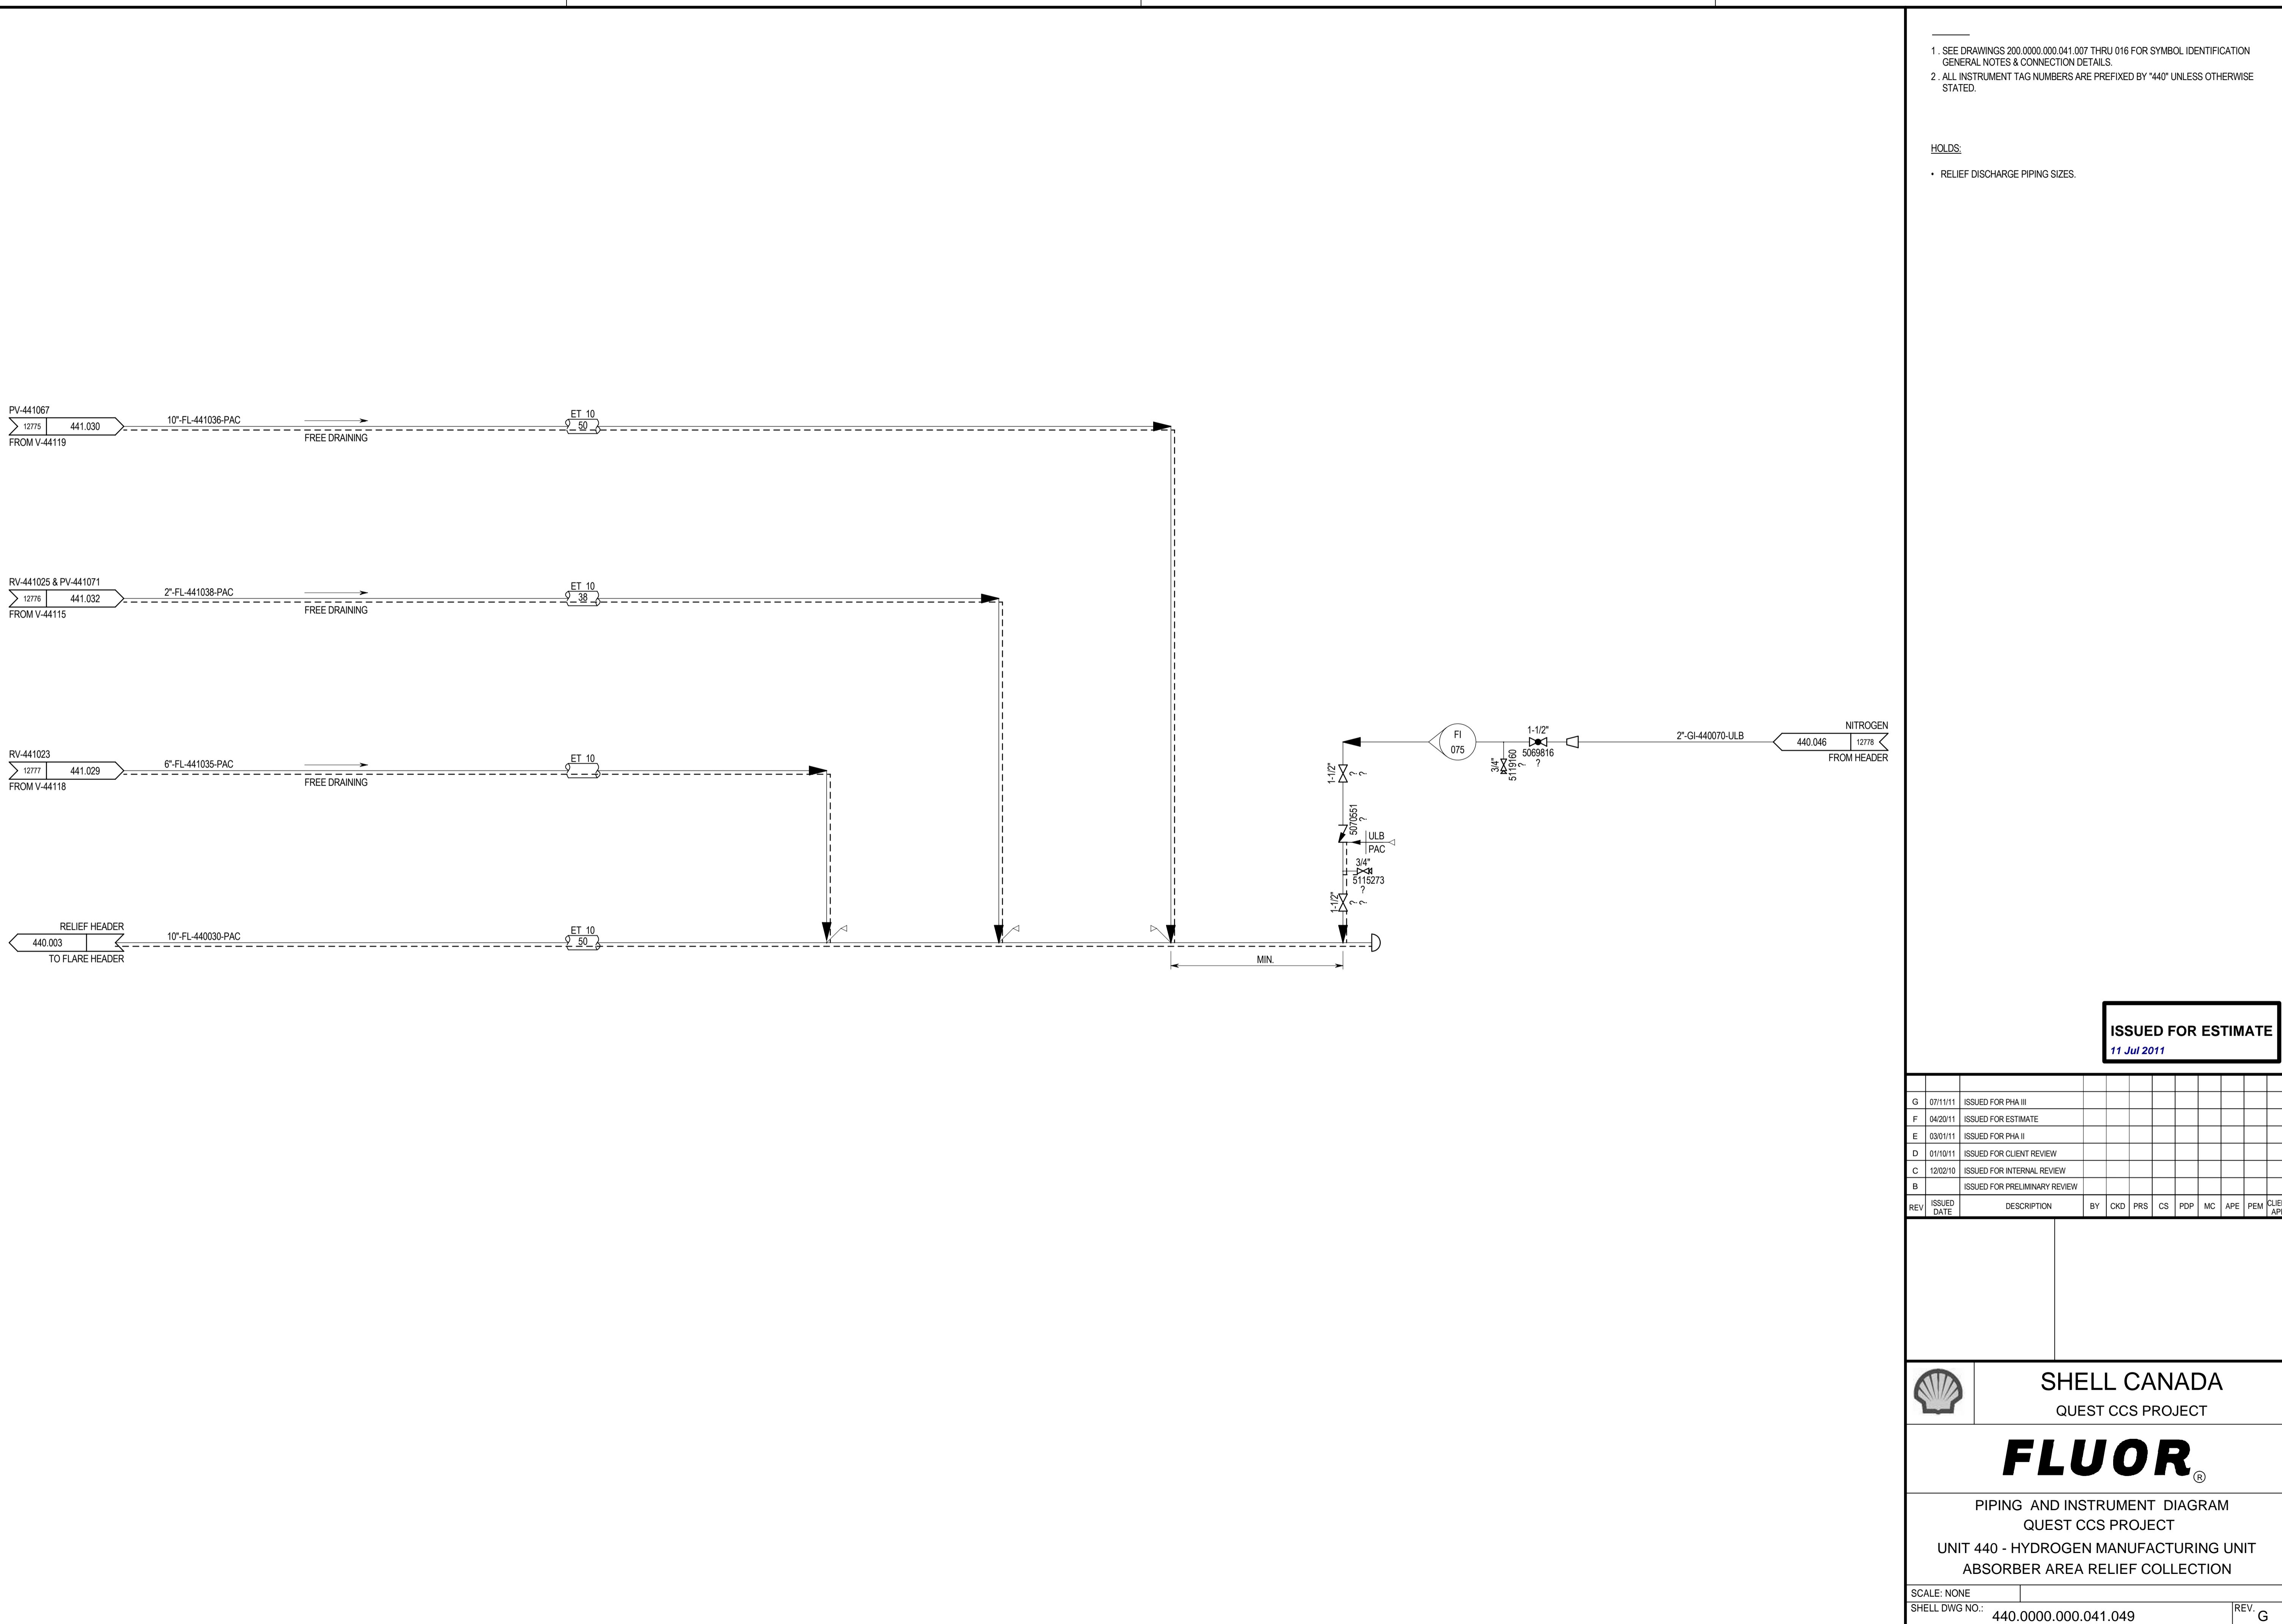

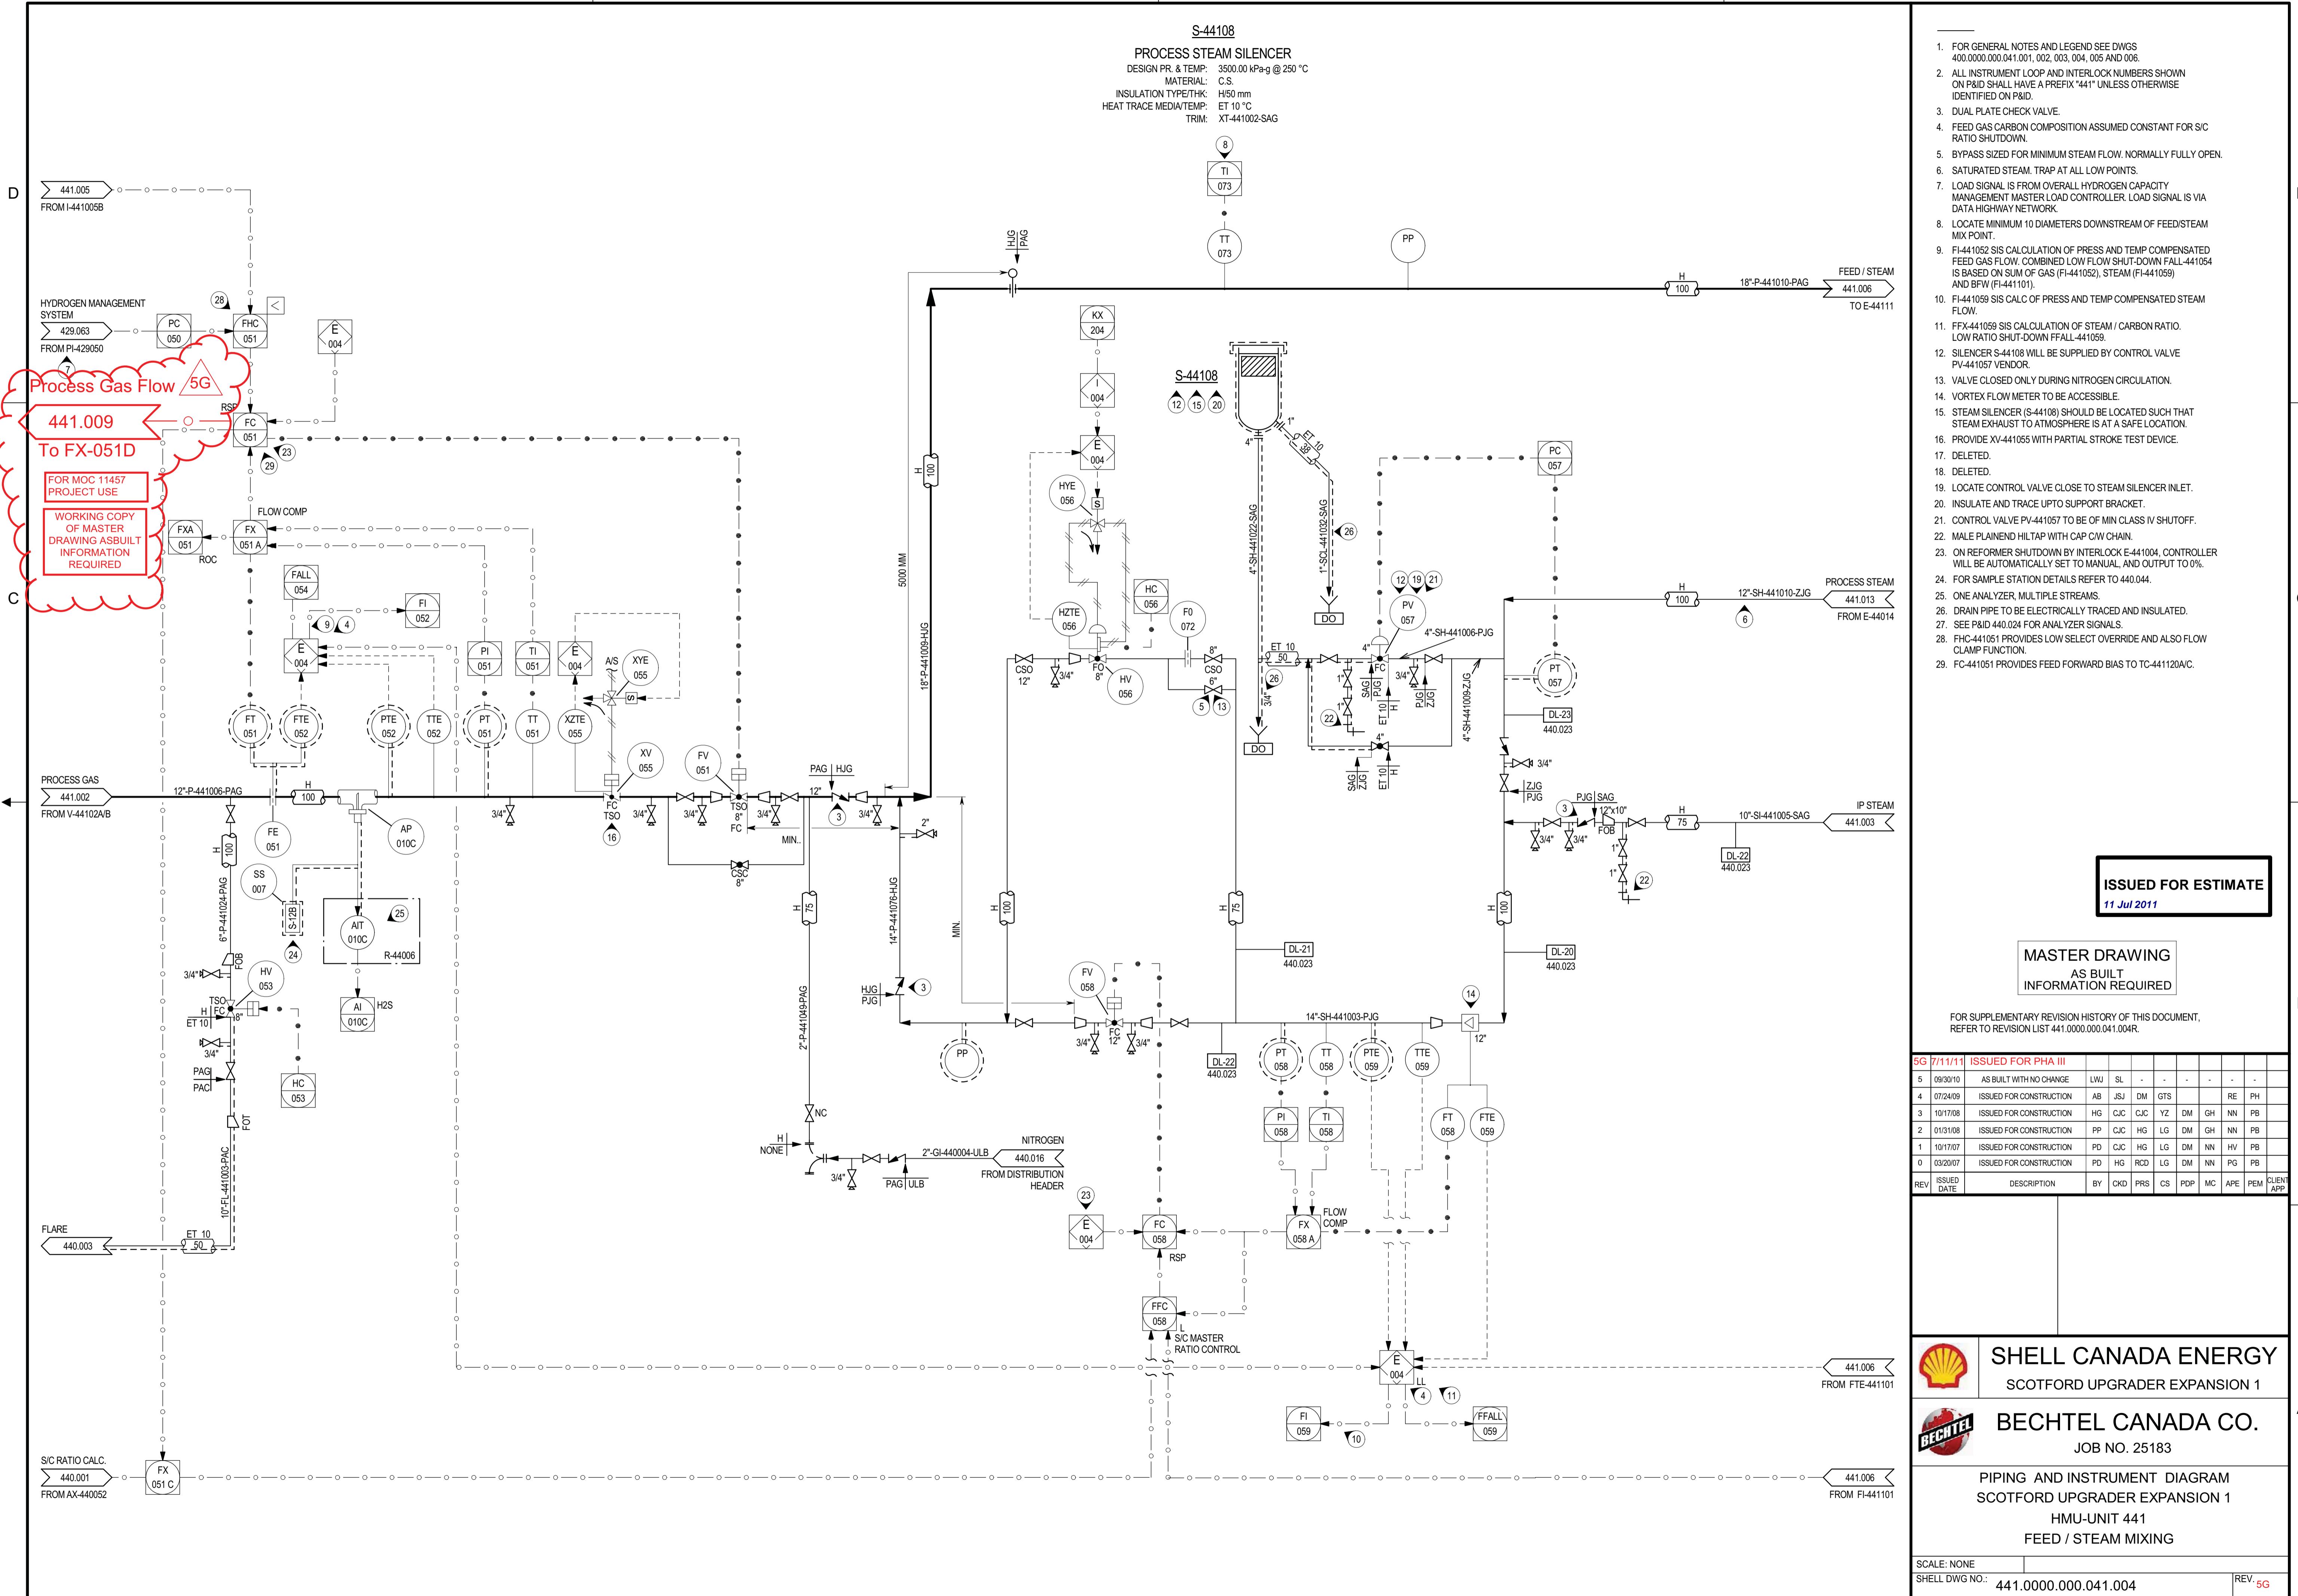

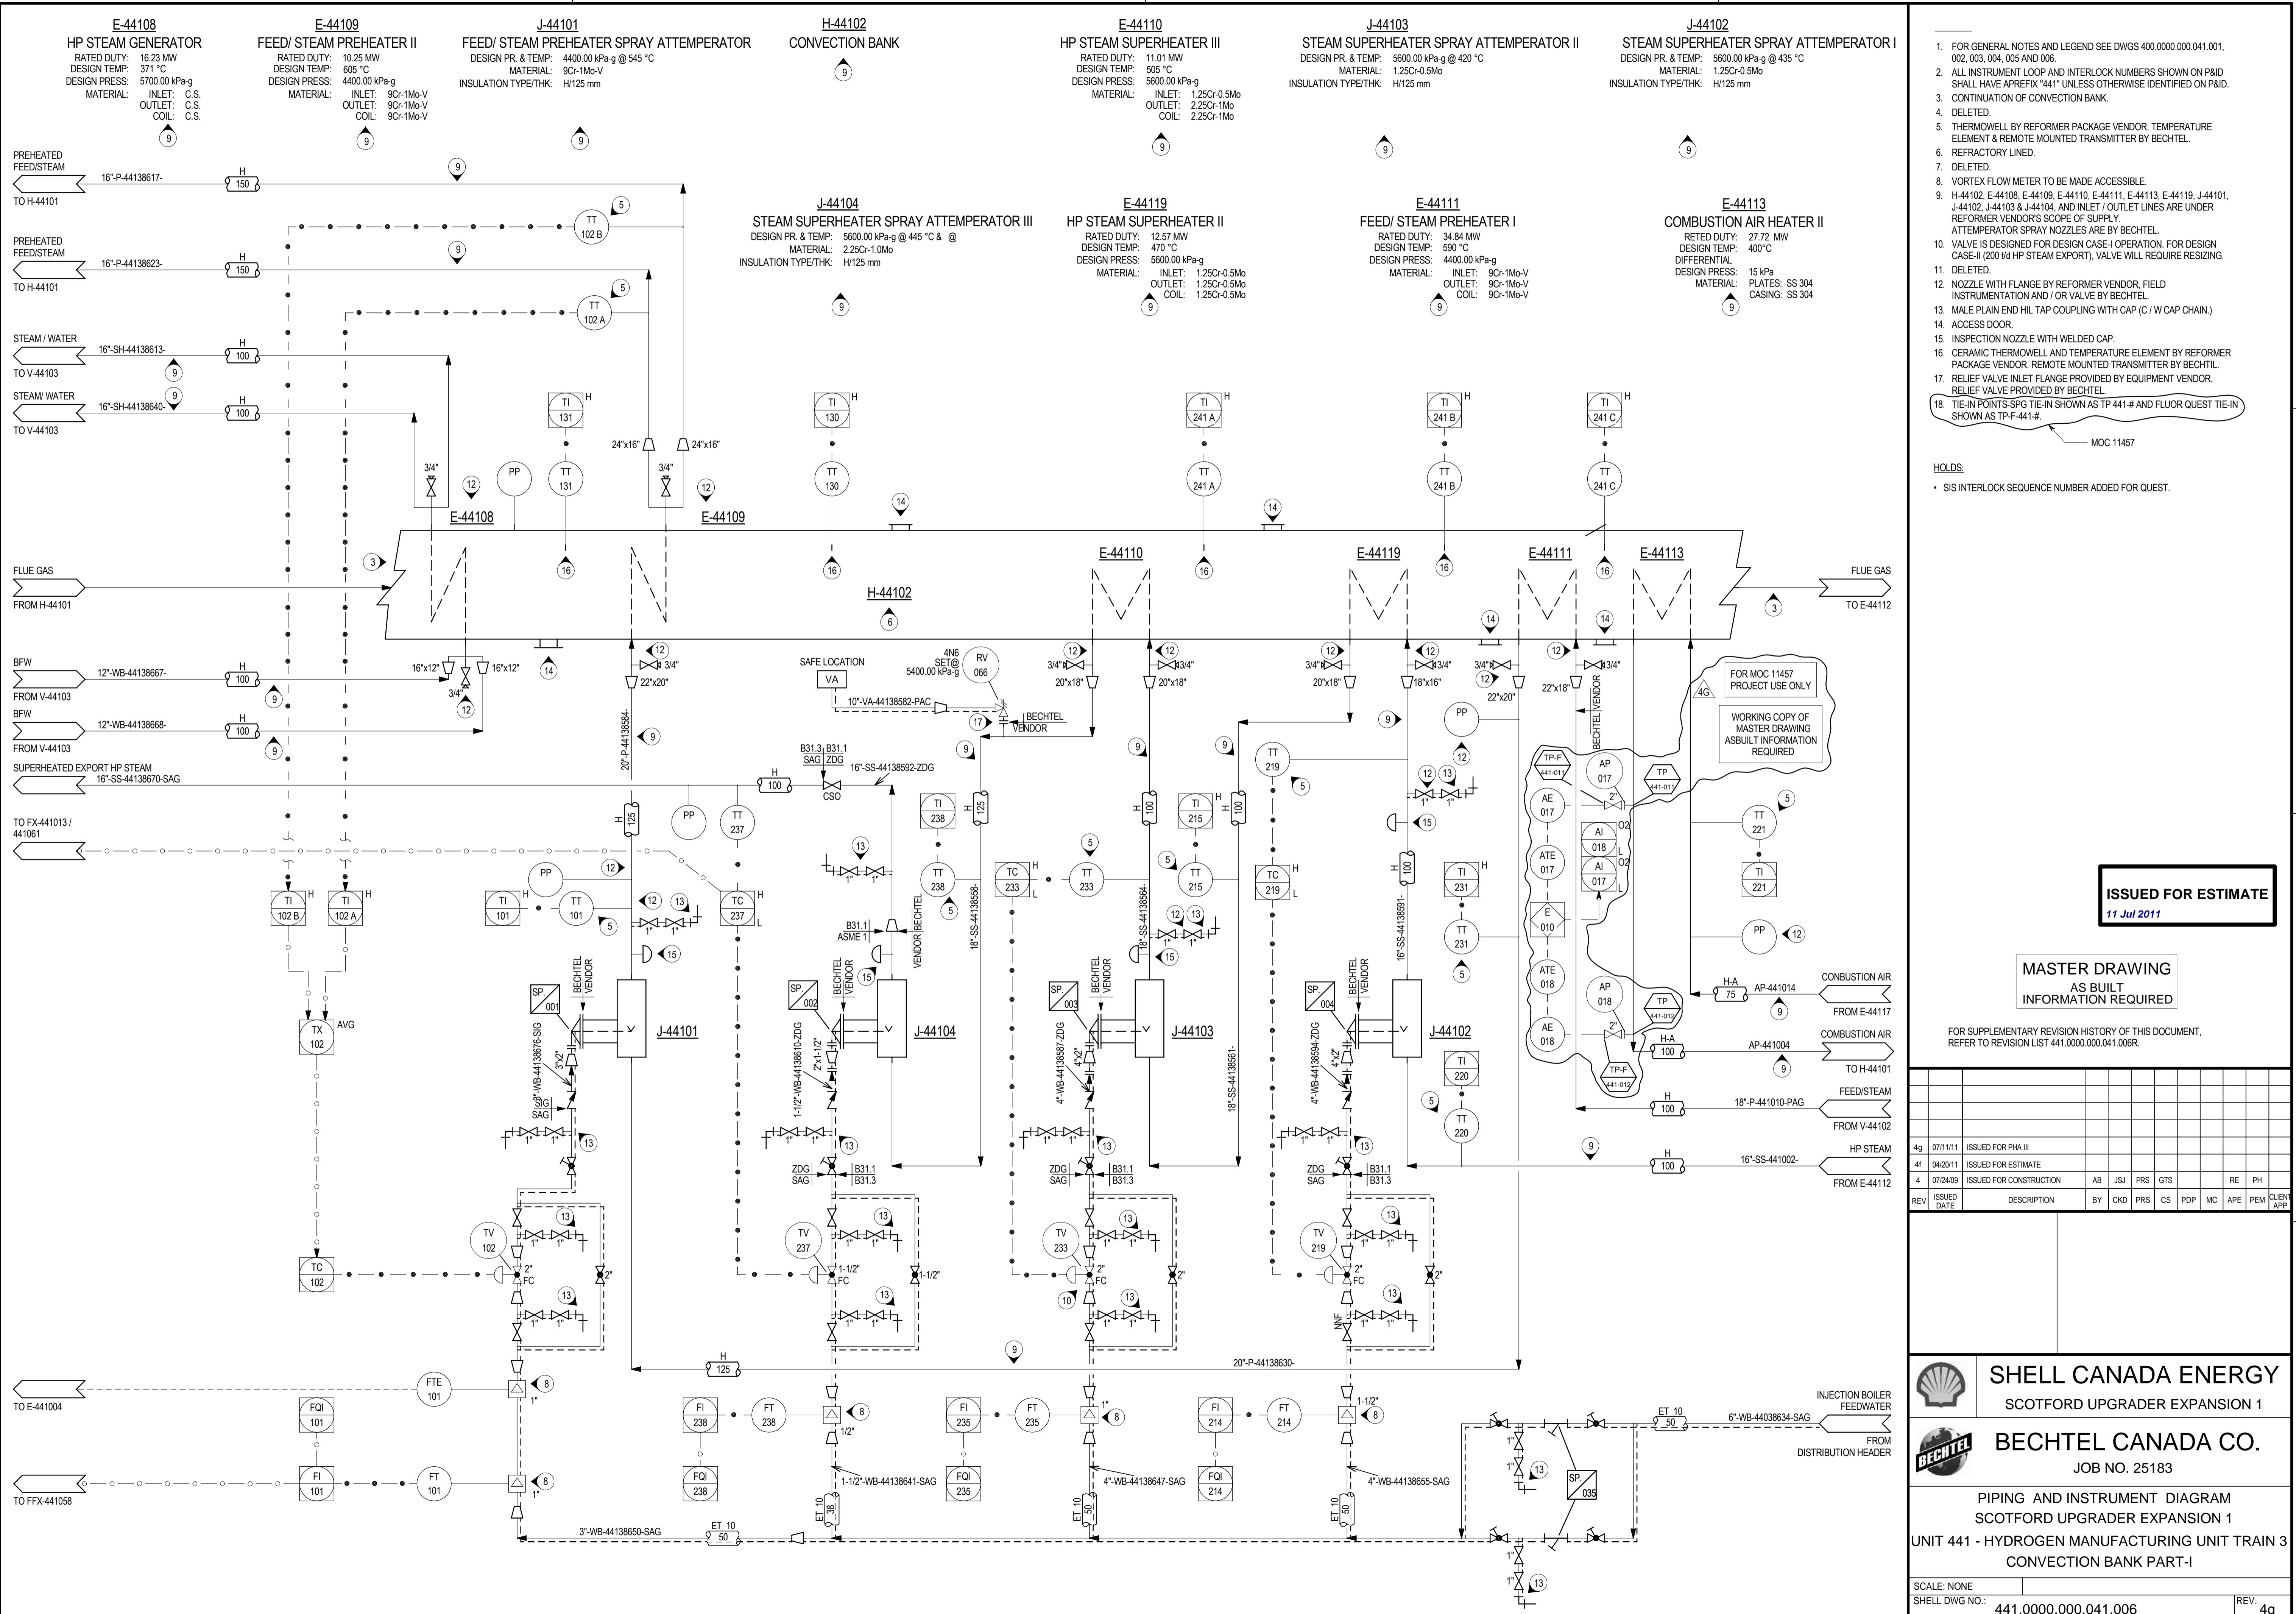

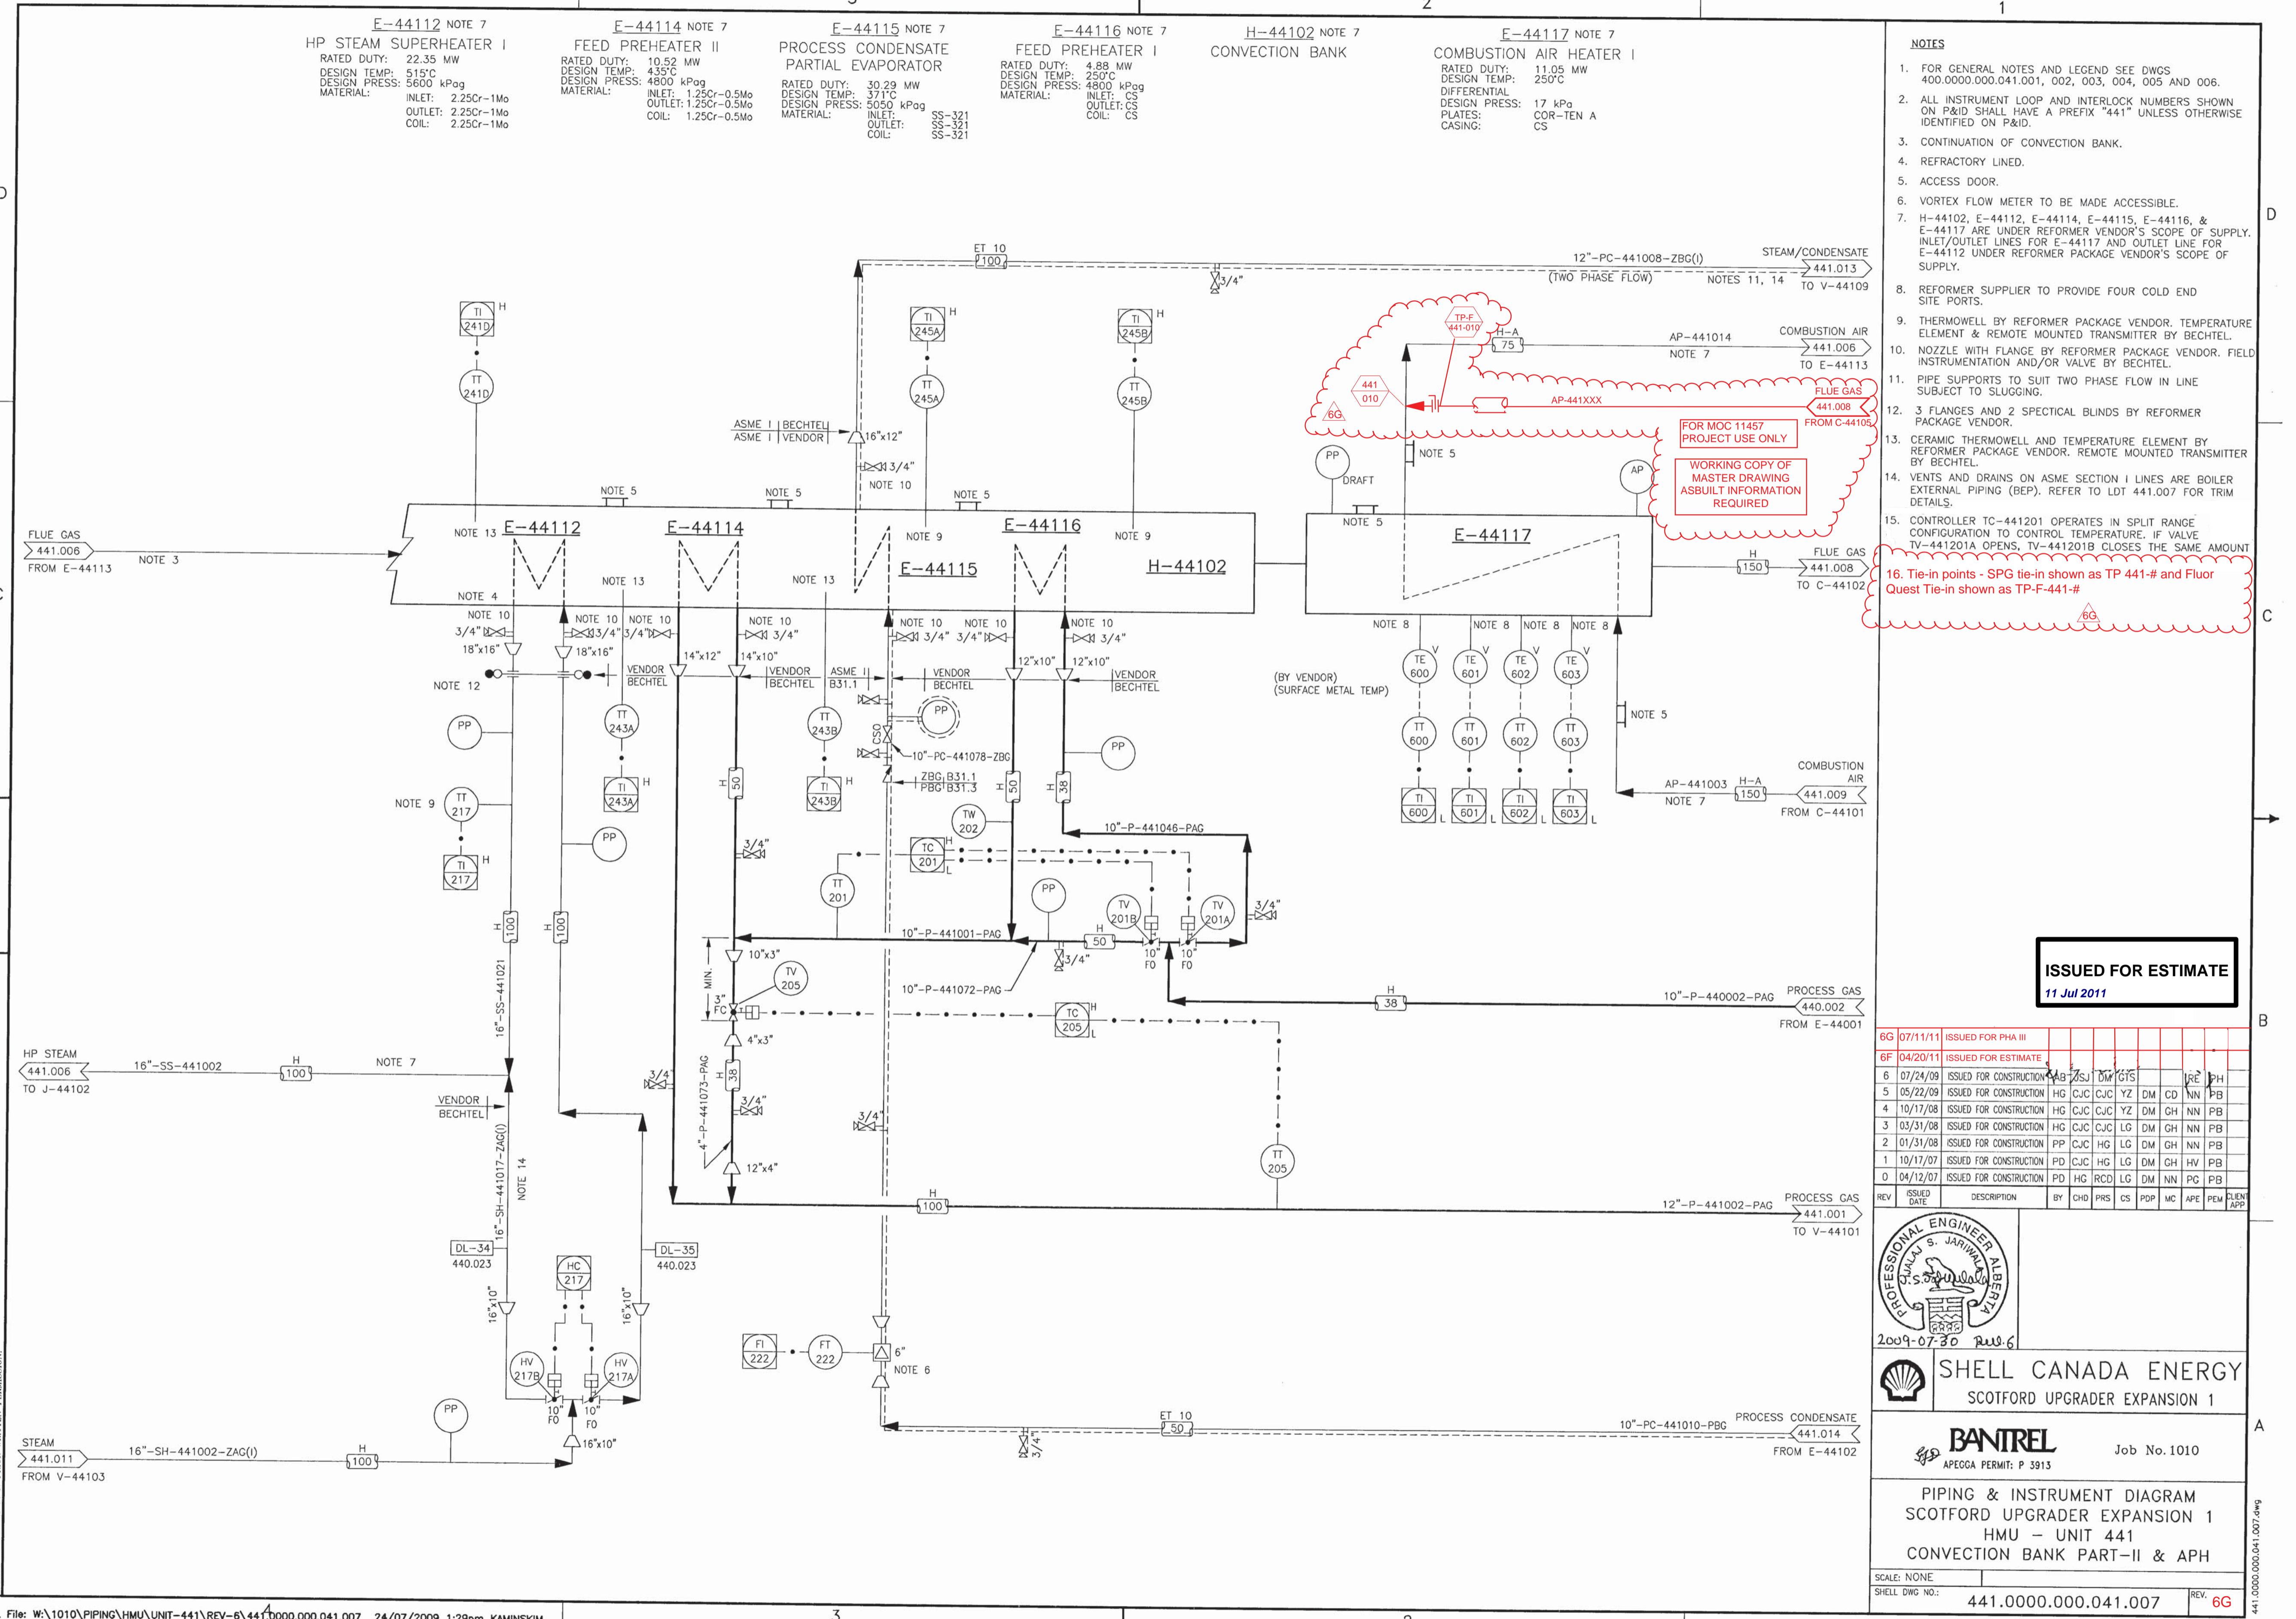

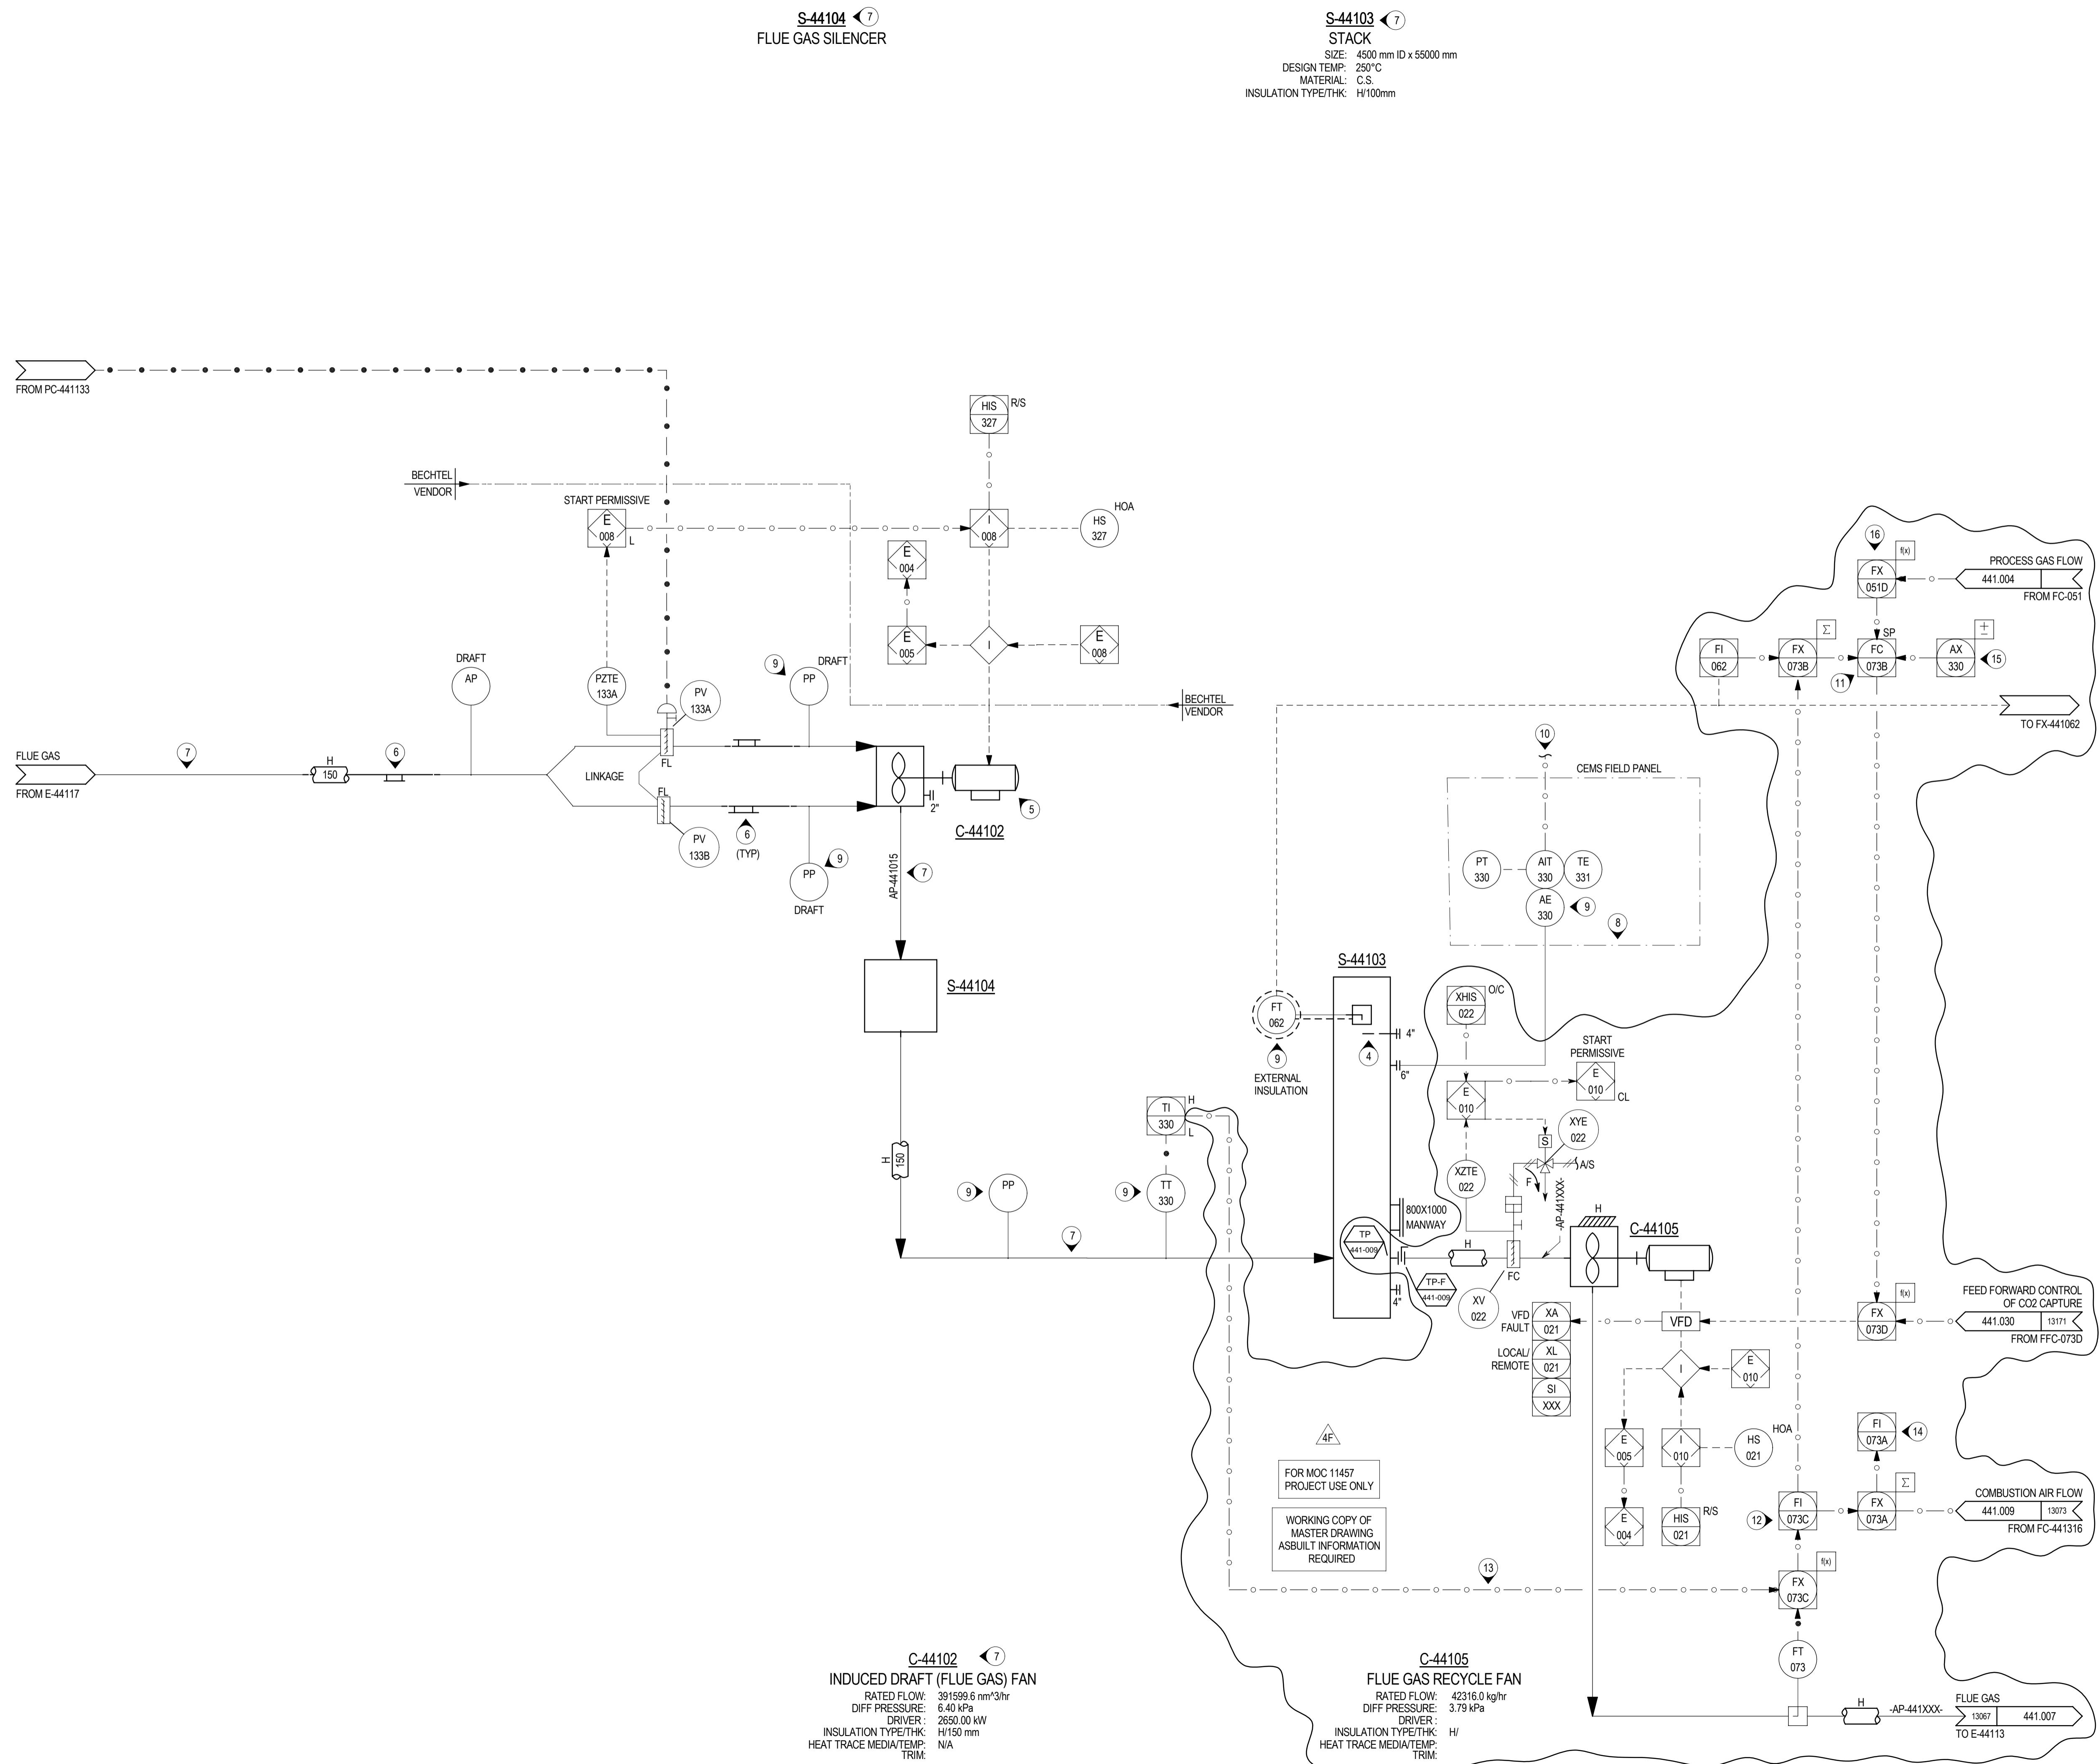

- . FOR GENERAL NOTES AND LEGEND SEE DWGS 400.0000.000.041.001, 002, 003, 004, 005 AND 006.
- . ALL INSTRUMENT LOOP AND INTERLOCK NUMBERS SHOWN ON P&ID SHALL HAVE A PREFIX "441" UNLESS OTHERWISE IDENTIFIED ON P&ID.
- . DELETED.
- . THREE SETS OF NOZZLES:
  - SET1 - MANUAL SAMPLE PORTS, 4", 150# FFWN C/W BLIND AND 4" NPT CAPPED NIPPLE. 4 @ 90°
  - SET2 - CEMS SAMPLE PORTS, 6", 150# FFWN. 2 @ 180°
  - SET3 - ANNULAR PORT, 6", 150# FFWN. 2 @ 180°SAMPLE POINTS SHALL BE AS PER ALBERTA STACK SAMPLING CODE.
- . ONE LUBE OIL SYSTEM FOR BOTH FANS (C-44101 & C-44102) REFER TO P&ID NUMBER 441.024 & 441.026.
- . ACCESS DOOR.
- . C-44102, S-44103, S-44104 AND ASSOCIATED PIPING UNDER REFORMER VENDOR'S SCOPE OF SUPPLY.
- . CEMS ENCLOSURE.
- . NOZZLE WITH FLANGE BY REFORMER PACKAGE VENDOR. FIELD INSTRUMENTATION AND/OR VALVE BY BECHTEL.
- . SEE P&ID 440.024 FOR ANALYZER SIGNAL DETAILS.
- . TOTAL CONVECTION SECTION FLOW.
- . FLUE GAS RECYCLE FLOW.
- . TI-330 USED TO TEMPERATURE COMPENSATE FX-073C.
- . TOTAL FGR AND COMBUSTION AIR FLOW.
- . AX-330 IS FOR THE OPERATOR TO MANUALLY BIAS THE CONTROLLER OUTPUT TO OPTIMISE NOx EMISSIONS.
- . FX-051D DETERMINES THE SETPOINT FOR THE CONVECTION SECTION FLOW BASED ON THE HMU LOAD.
- . TIE-IN POINTS- SPG TIE-IN SHOWN AS TP-441-# AND FLUOR QUEST TIE-IN WHICH IS TP-5-441-#

HOLDS: MOC 11457

**ISSUED FOR ESTIMATE**

**MASTER DRAWING**

**AS BUILT**

**INFORMATION REQUIRED**

FOR SUPPLEMENTARY REVISION HISTORY OF THIS DOCUMENT,  
REFER TO REVISION LIST 441.0000.000.041.008R.

11/11	ISSUED FOR PHA III									
20/11	ISSUED FOR ESTIMATE									
14/11	ISSUED FOR PHA II									
10/11	ISSUED FOR CLIENT REVIEW									
02/10	ISSUED FOR INTERNAL REVIEW									
	ISSUED FOR PRELIMINARY REVIEW									
30/10	AS BUILT WITH NO CHANGE	LWJ	SL							
UED	DESCRIPTION	RV	CKD	PRS	CS	PDP	MC	APE	PEM	CLIENT




# SHELL CANADA ENERGY

## SCOTFORD UPGRADE EXPANSION 1

**ECHTEL CANADA CO.**  
**JOB NO. 25183**

PIPING AND INSTRUMENT DIAGRAM  
SCOTFORD UPGRADER EXPANSION 1  
441 - HYDROGEN MANUFACTURING UNIT TRAIN 3  
ID FAN AND ELLIE GAS STACK

: NONE | DWG NO.: 441-0000-000-041-008 | REV. 1G

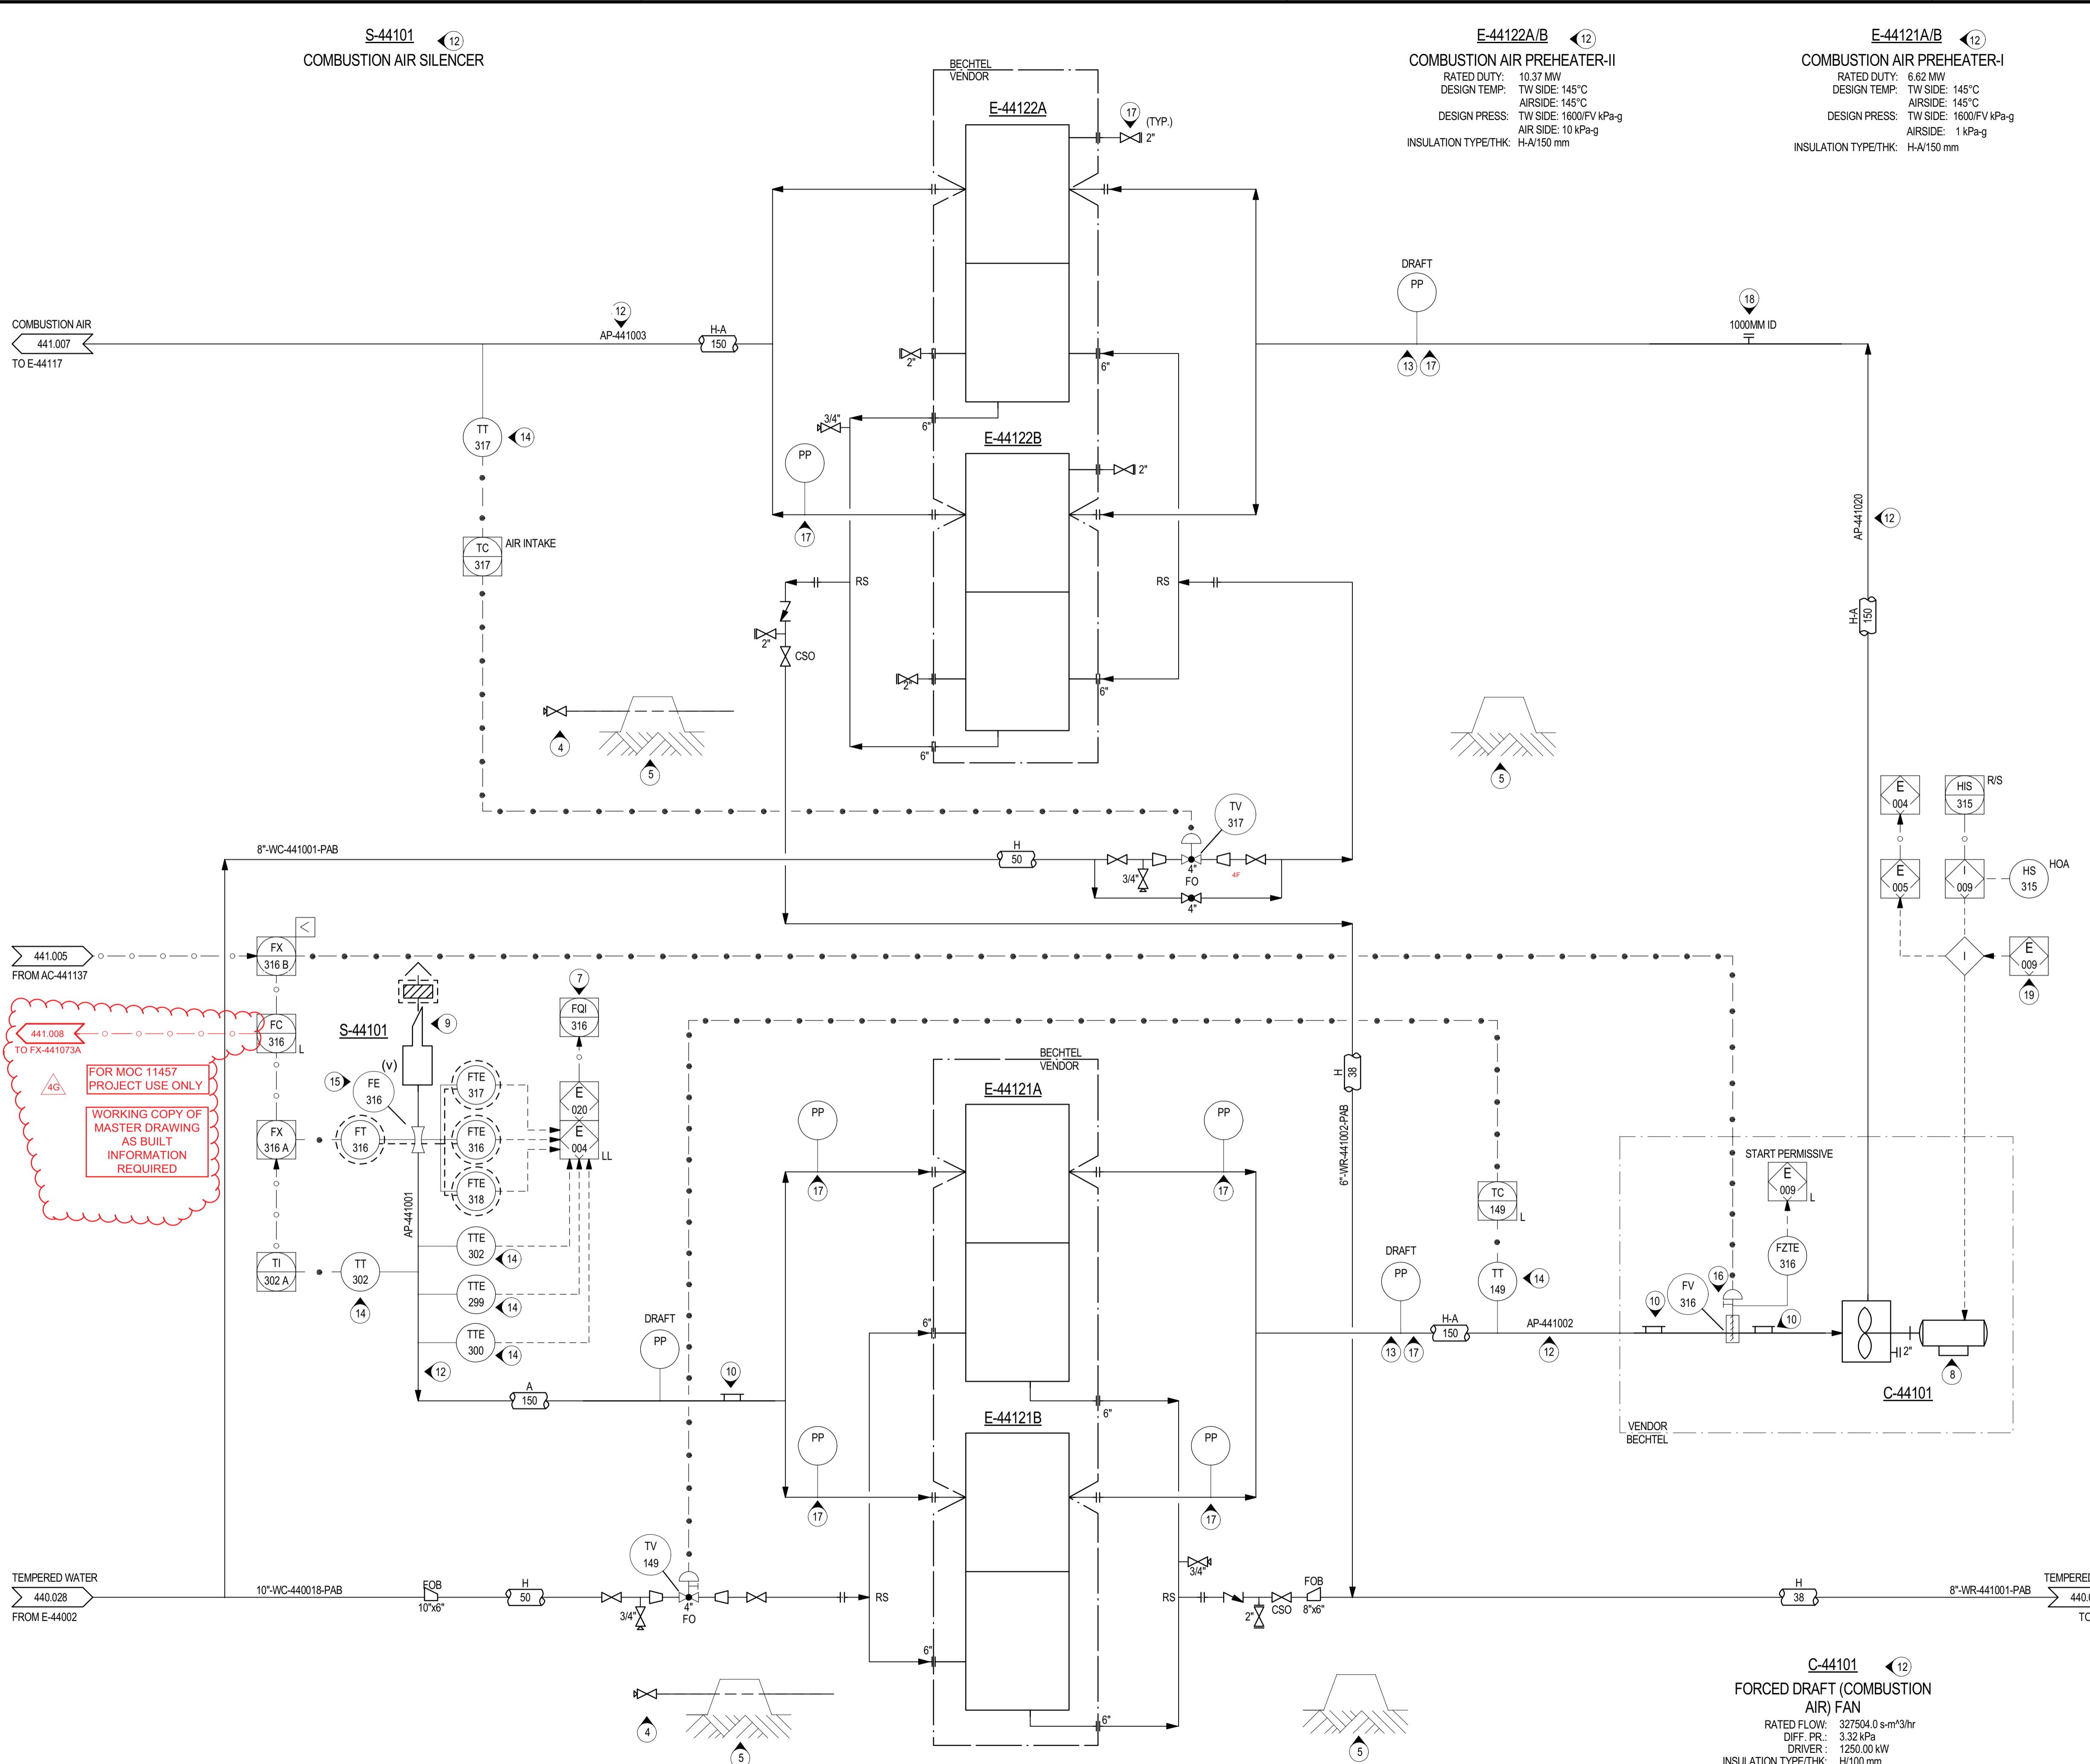

1. FOR GENERAL NOTES AND LEGEND SEE DWGS 400.0000.000.041.001, 002, 003, 004, 005 AND 006.
2. ALL INSTRUMENT LOOP AND INTERLOCK NUMBERS SHOWN ON P&ID SHALL HAVE A PREFIX "441" UNLESS OTHERWISE IDENTIFIED ON P&ID.
3. DELETED.
4. VALVE OPENED ONLY TO DRAIN RAIN WATER.
5. PROVIDE SHALLOW CURBING FOR SPILL.
6. DELETED.
7. REFORMER START - UP PURGE FLOW TOTALIZER (FQI - 441316).
8. ONE LUBE OIL SYSTEM FOR BOTH FANS (C - 44101 & C - 44102). REFER TO P&ID NO.441.024 & 441.026.
9. BIRD SCREEN ELECTRICALLY TRACED. BIRD SCREEN IS SUPPLIED WITH S - 44101 (BY VENDOR).
10. ACCESS DOOR.
11. DELETED.
12. S - 44101, C - 44101, E - 44121A/B, E - 44122A / B AND COMBUSTION AIR LINES ARE UNDER REFORMER'S VENDOR SCOPE OF SUPPLY.
13. LOCATION SUITABLE FOR C - 44101 PERFORMANCE MEASUREMENT.
14. THERMOWELL BY REFORMER PACKAGE VENDOR. TEMPERATURE ELEMENT AND TRANSMITTER BY BECHTEL.
15. VENTURI FE - 441316 WITH NOZZLES BY REFORMER PACKAGE VENDOR, FLOW TRANSMITTER BY BECHTEL.
16. FOUNDATION FIELD BUS POSITIONER AND POSITION TRANSMITTER BY REFORMER PACKAGE VENDOR.
17. NOZZLE WITH FLANGE BY REFORMER PACKAGE VENDOR. FIELD INSTRUMENTATION AND / OR VALVE BY BECHTEL.
18. FOR START UP OPTION # 1.
19. FOR DETAILED MACHINE MONITORING, REFER TO P&ID 441.024.

ISSUED FOR ESTIMATE  
11 Jul 2011

# MASTER DRAWING

## AS BUILT INFORMATION REQUIRED

FOR SUPPLEMENTARY REVISION HISTORY OF THIS DOCUMENT,  
REFER TO REVISION LIST 441.0000.000.041.009R.

11/11	ISSUED FOR PHA III									
20/11	ISSUED FOR ESTIMATE									
30/10	AS BUILT PER PROJECT NO 25183	LWJ	SL	-	-	-	-	-	-	
24/09	ISSUED FOR CONSTRUCTION	AB	JSJ	DM	GTS			RE	PH	
31/08	ISSUED FOR CONSTRUCTION	PP	CJC	HG	LG	DM	GH	NN	PB	
17/07	ISSUED FOR CONSTRUCTION	PD	CJC	HG	LG	DM	GH	HV	PB	
12/07	ISSUED FOR CONSTRUCTION	PD	HG	RCD	LG	DM	NN	PG	PB	
UED ATE	DESCRIPTION	BY	CKD	PRS	CS	PDP	MC	APE	PEM	CLIENT APPROVED




# SHELL CANADA ENERGY


## SCOTFORD UPGRADE EXPANSION 1


# BECHTEL CANADA CO.

JOB NO. 25182

**PIPING AND INSTRUMENT DIAGRAM  
SCOTFORD UPGRADER EXPANSION 1  
HMU-UNIT 441  
COMBUSTION AIR HEATING AND FD FAN**

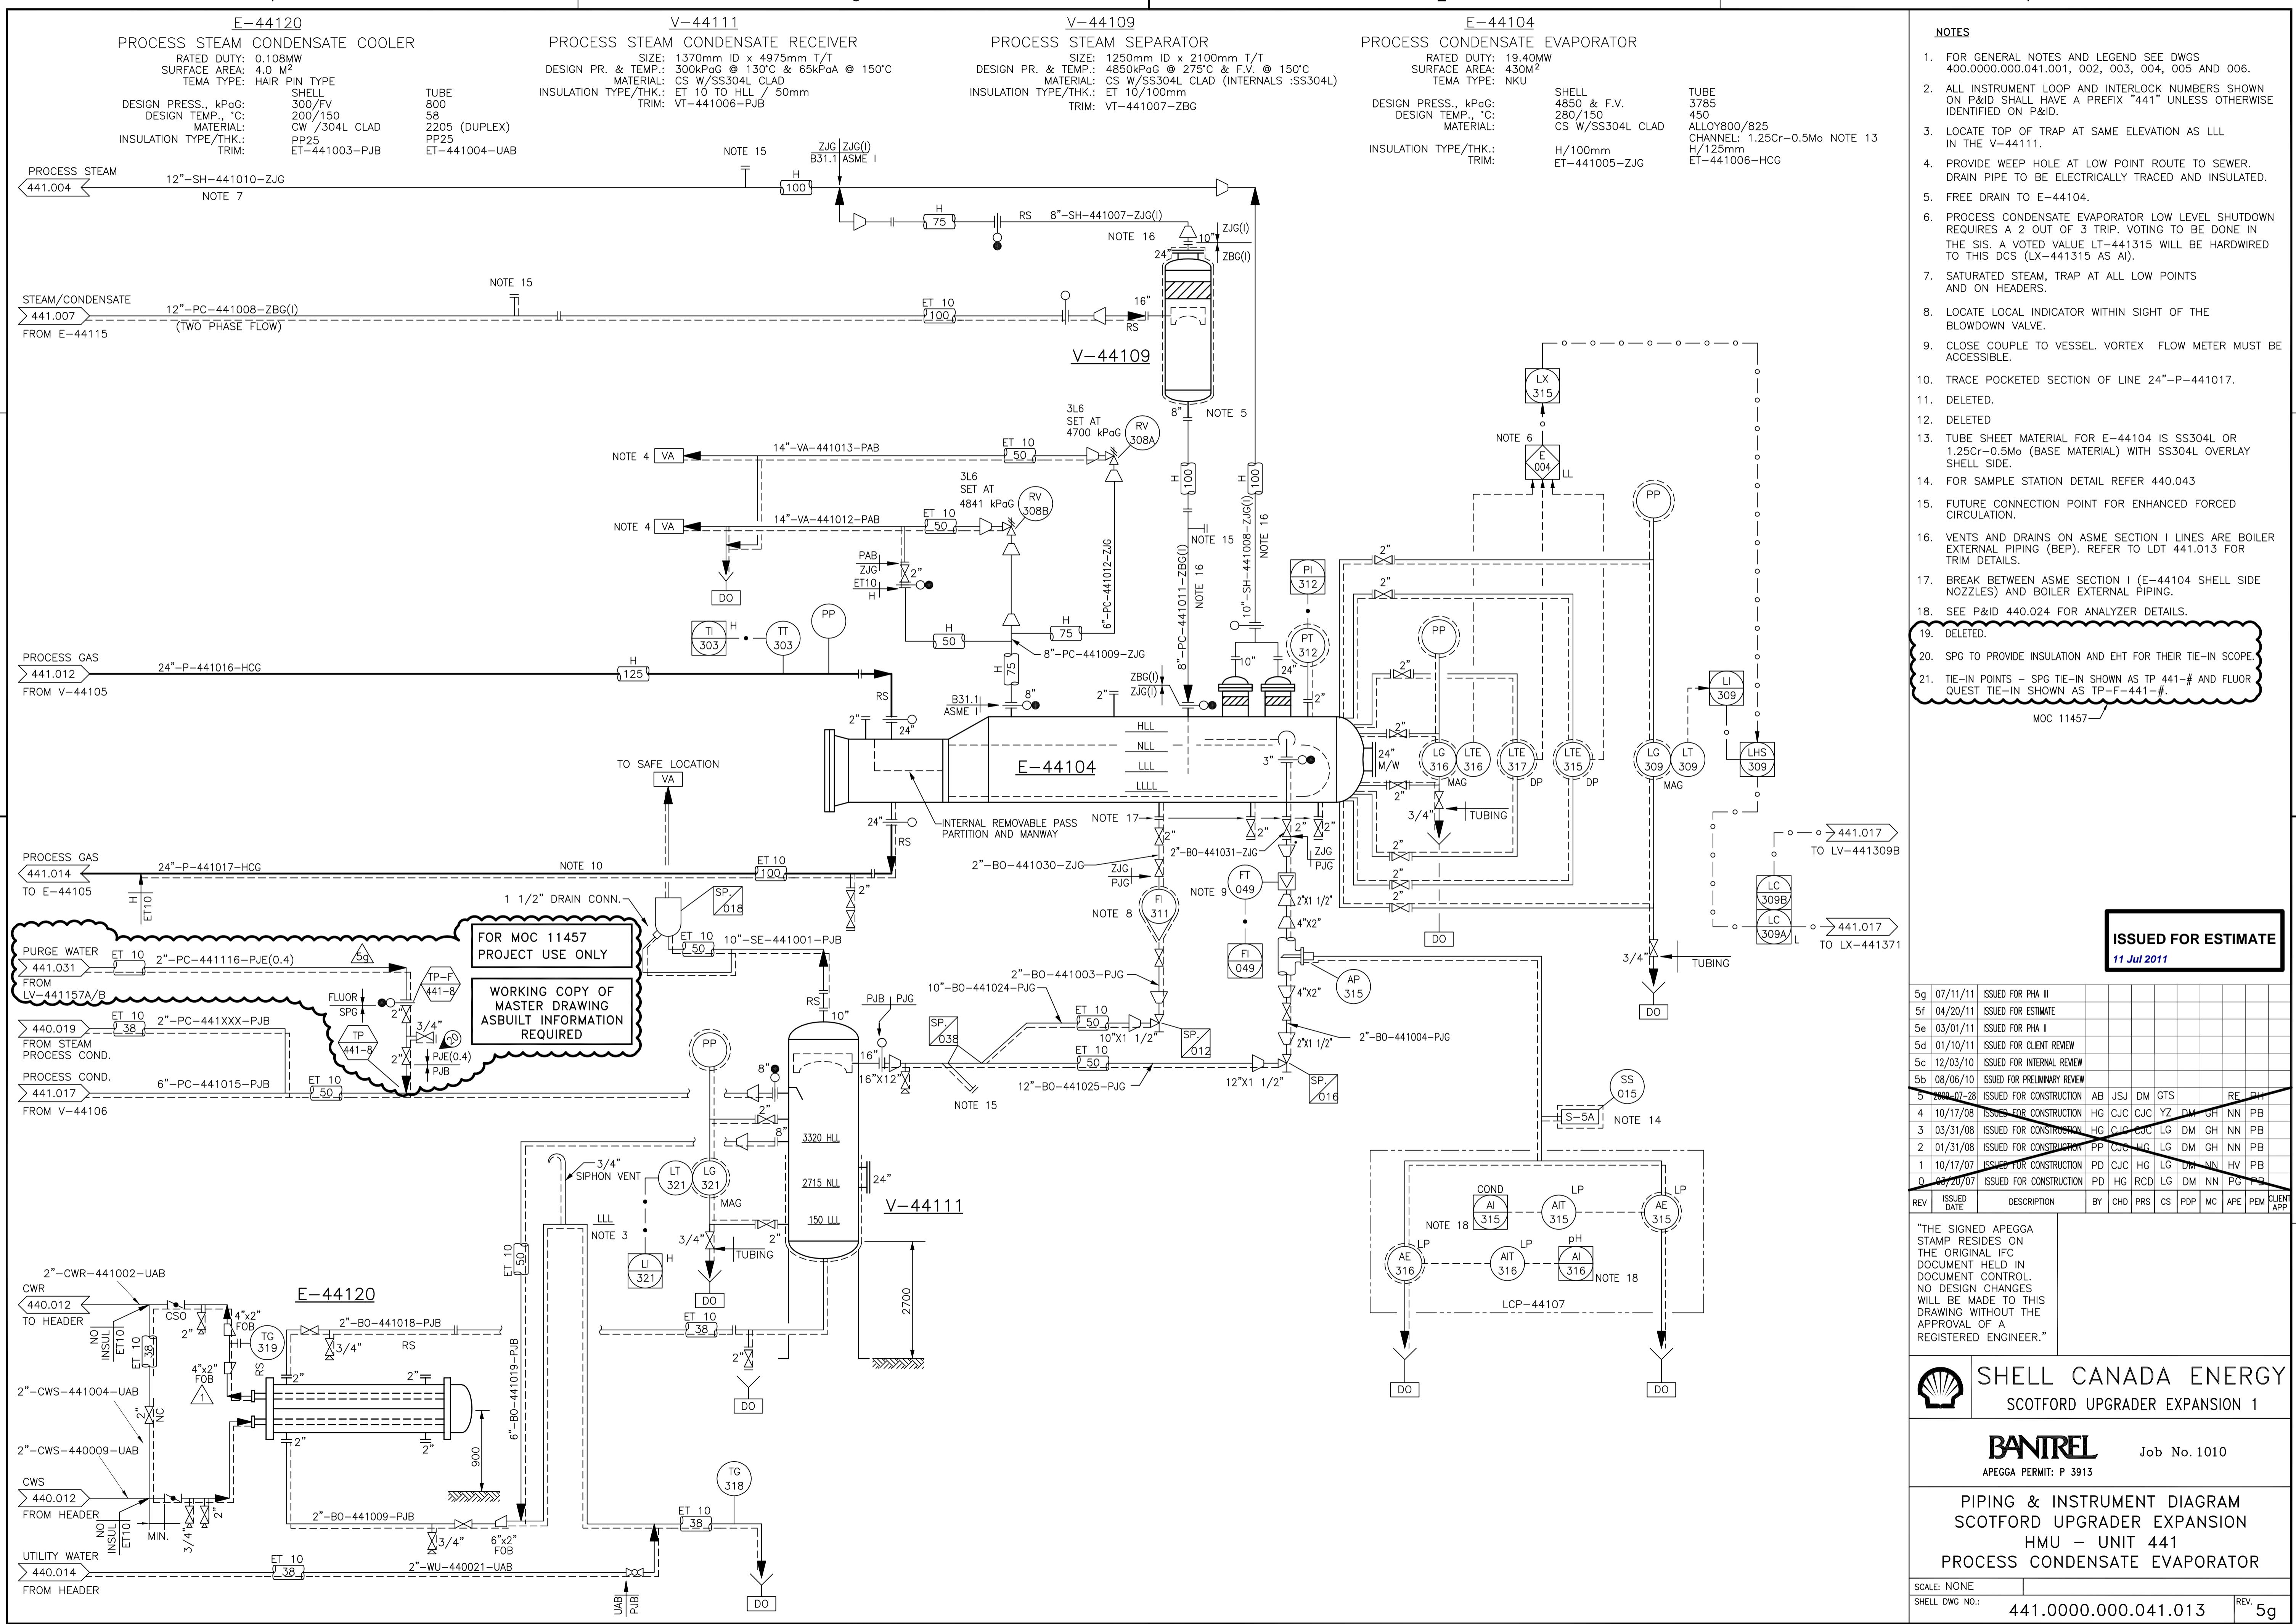

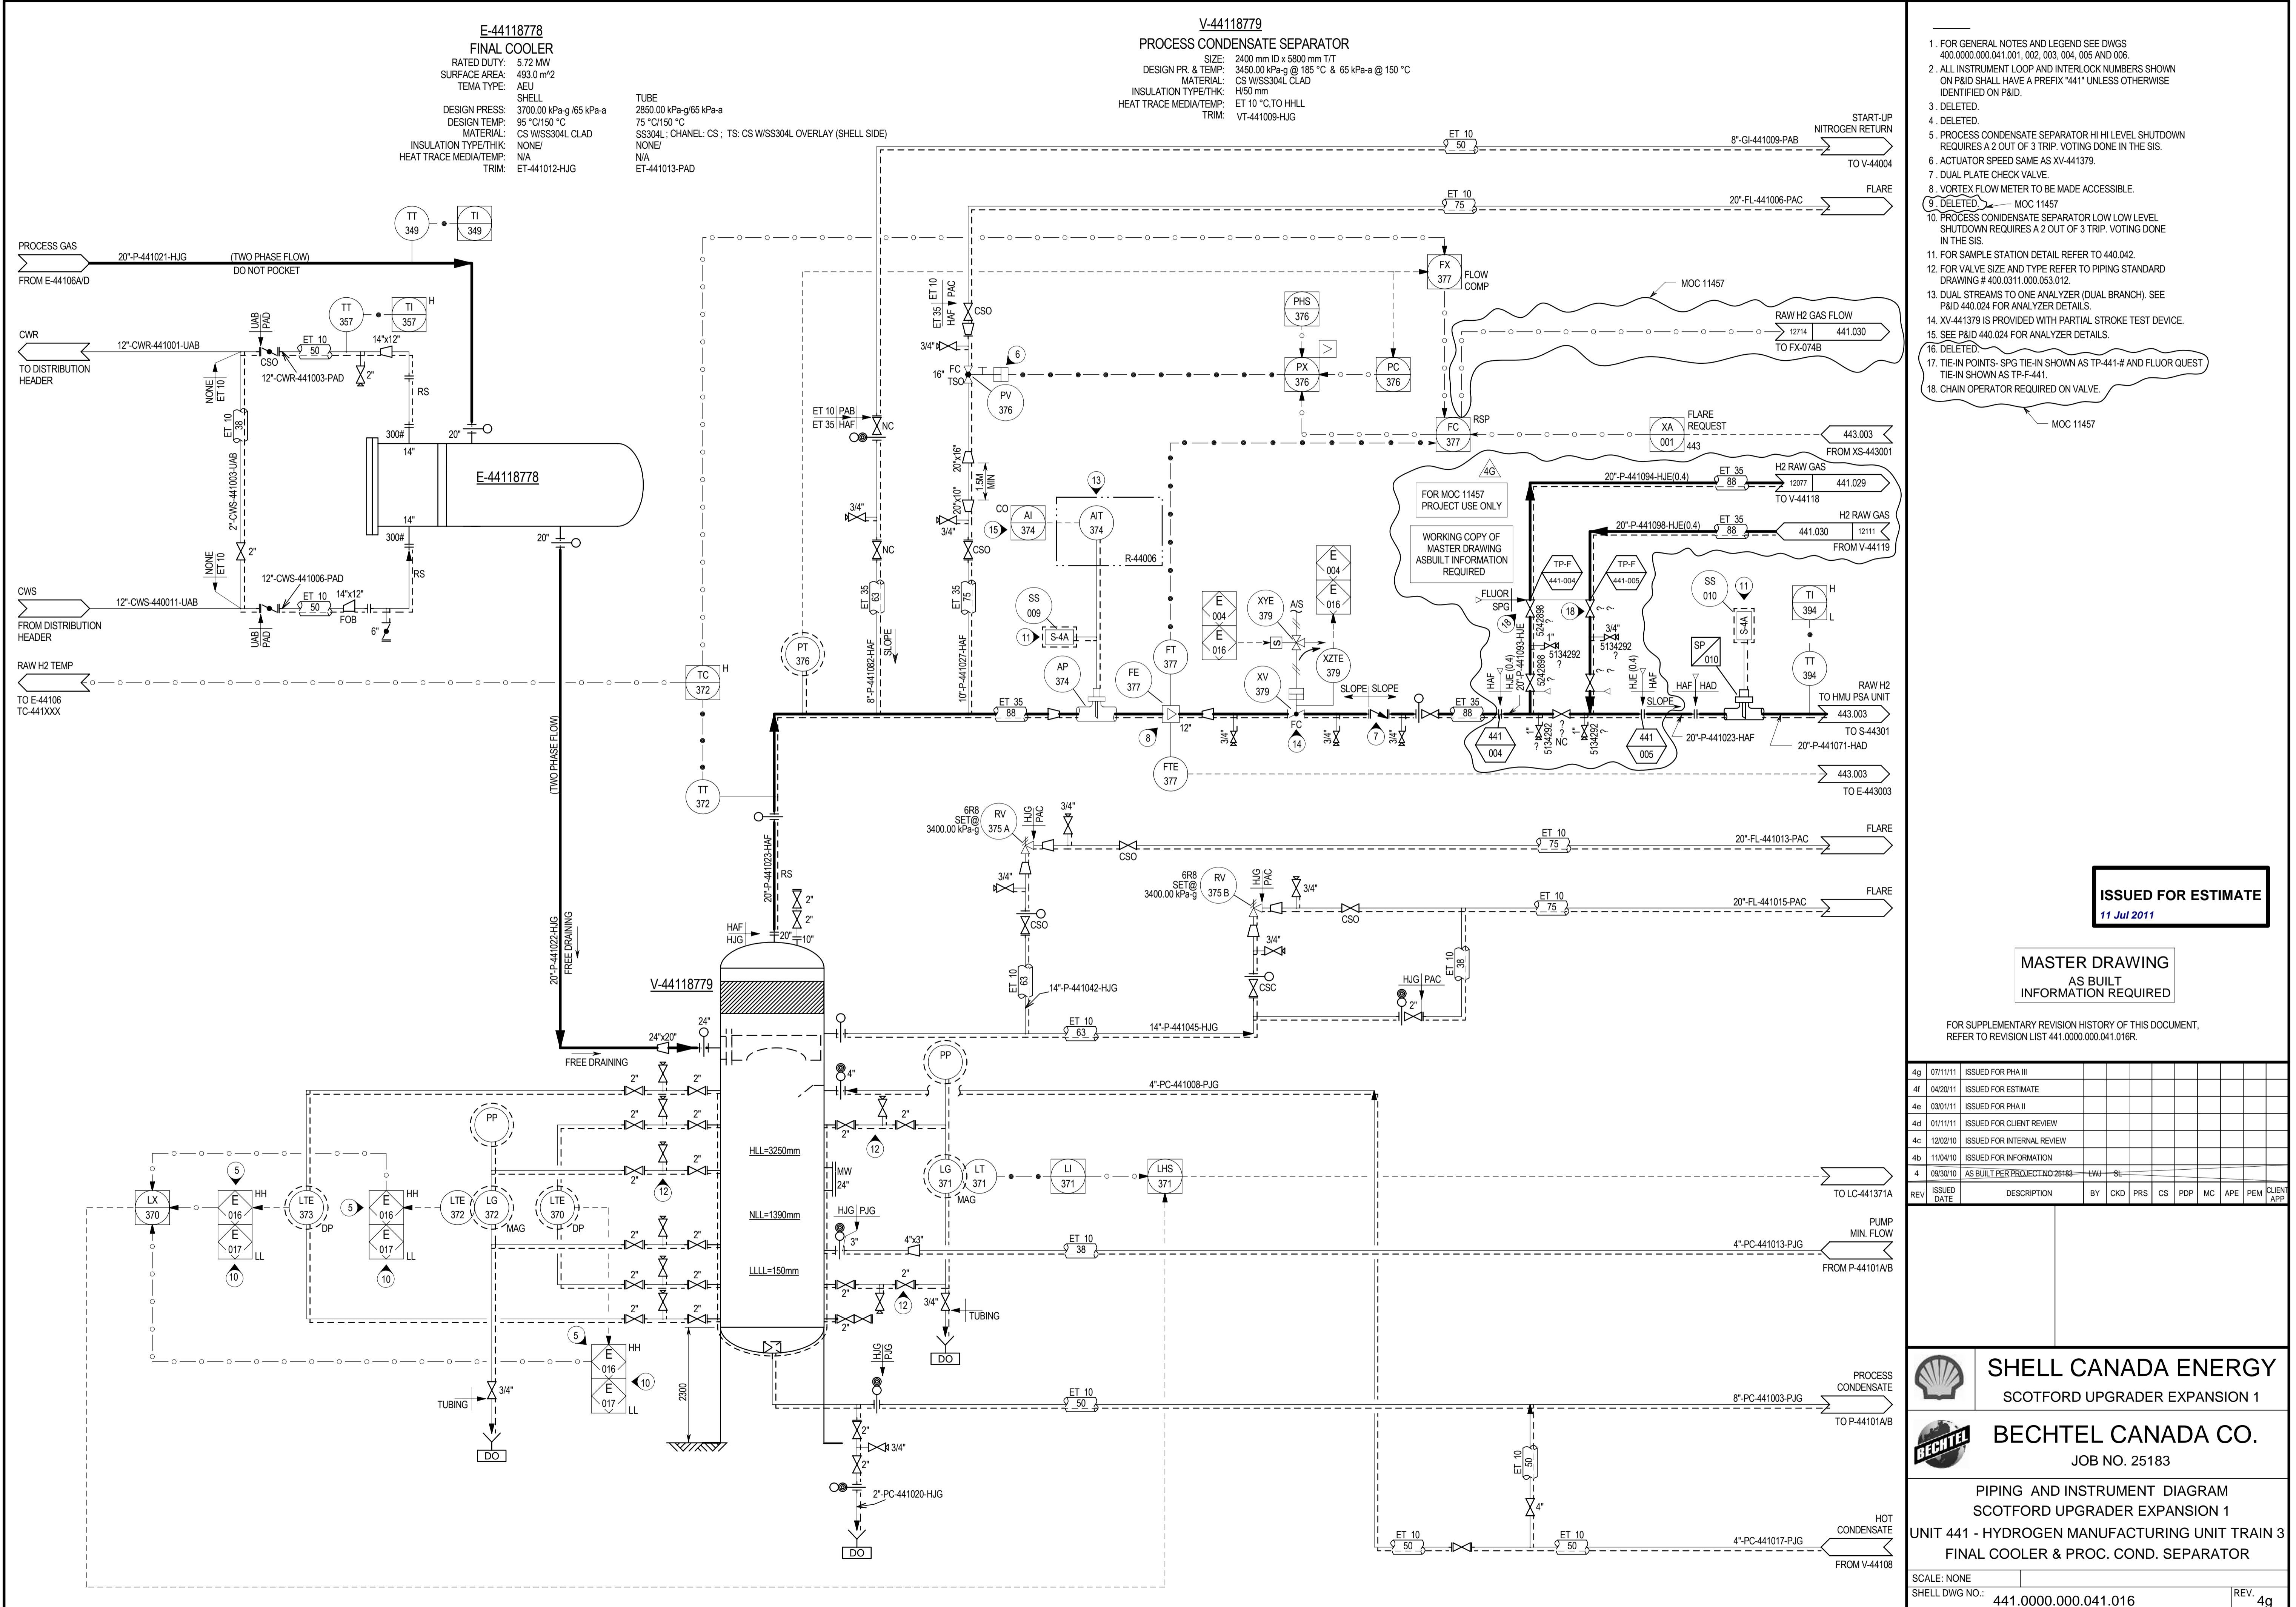

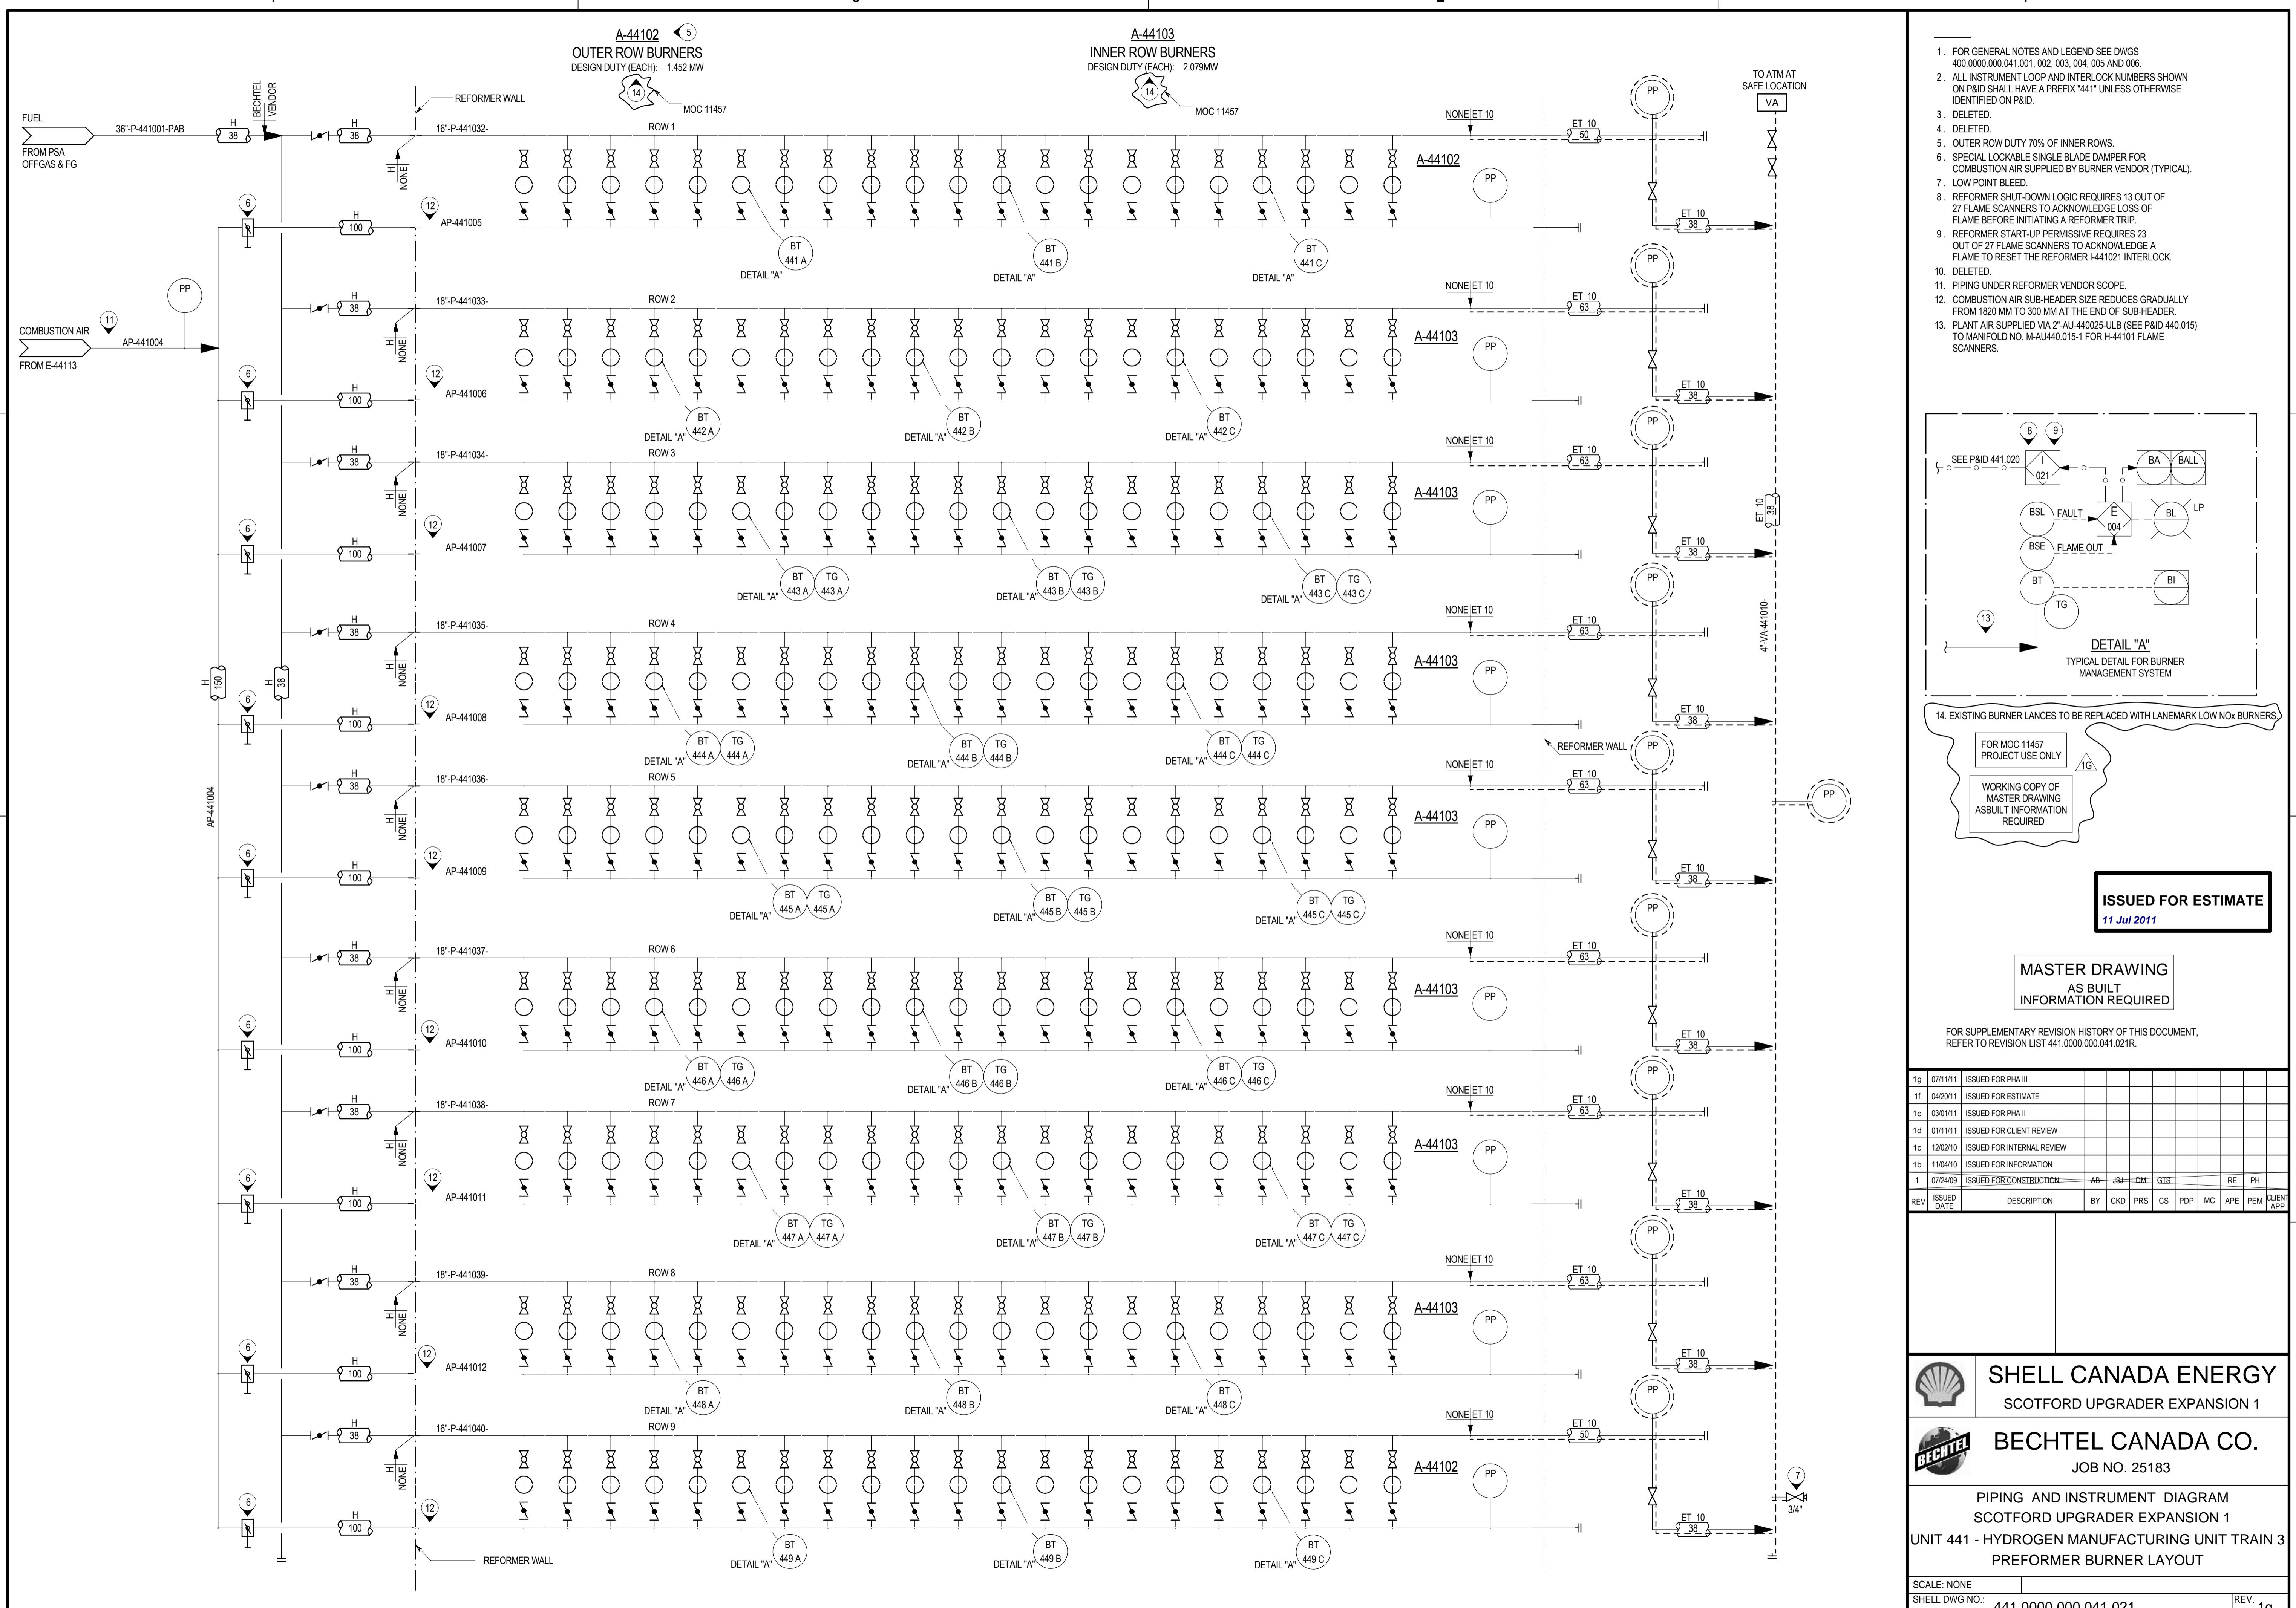

FILE:\F:\1025\DRAWINGS\HJM\U441441.021.pid MODEL DATE:7/6/2011 1:44:10 PM BY:ahm14887

